




**DONAHEY SURVEY**  
 LOTS 23 - 24 - 25 - 26  
 SHAWNEE ISLAND  
 STOKES TOWNSHIP  
 LOGAN COUNTY OHIO  
 1" = 25'  
 JANUARY 1951

INDEXED ON MAP  
 2389 - 1P  
 INDEXED ON MAP

Indicates Distance from Lot line to Water as shown, Feb. 24, 1951 2:30 P.M.

Book FM-26  
 Page 27  
 Revised Feb. 24, 1951

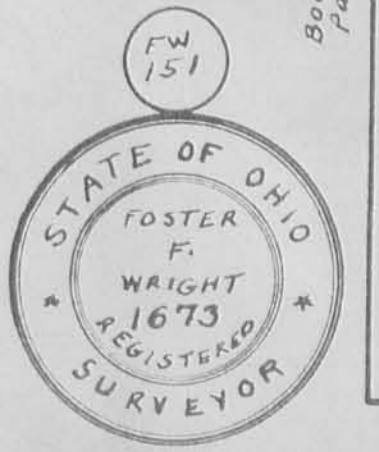

● Irons