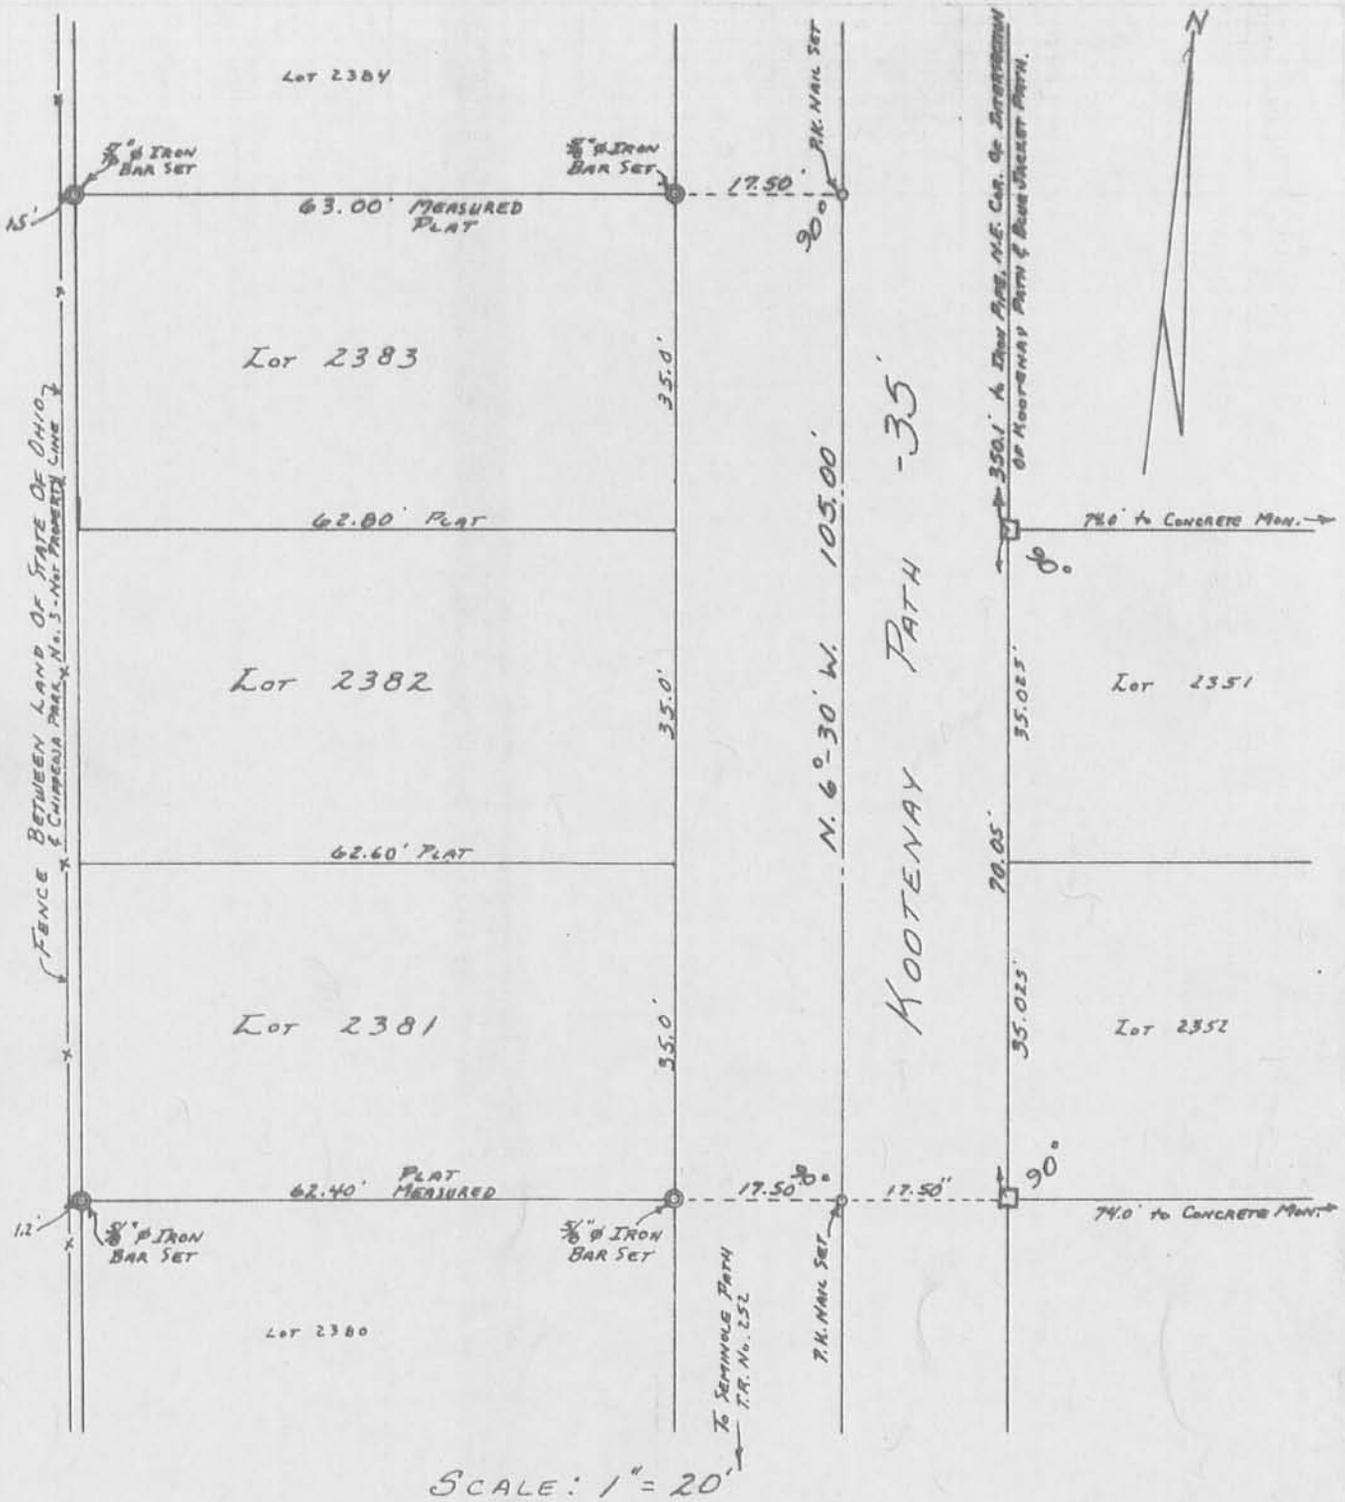

SCALE: 1" = 20'

REFERENCE:
CHIPPEWA PARK No. 3
PLAT BOOK C. VOL. 3 PAGES 15-16
LOGAN COUNTY RECORDERS OFFICE.

SURVEYED AND PLATTED BY:
DANIEL E. GILBERT, P.S.
REG. SUR. No. 5402

STATE OF OHIO DANIEL E. GILBERT 5402 REGISTERED SURVEYOR

ZIEGLER SURVEY
LOTS 2381-2382-2383
CHIPPEWA PARK No. 3
V.M.S. No. 12276
STOKES TOWNSHIP
LOGAN COUNTY, OHIO
MAY 18, 1968

4231

INDEXED ON MAP