Tecumseh Island – Minnewaucken Island

Nichols Thompson
Buchenroth Kaucher
Crites
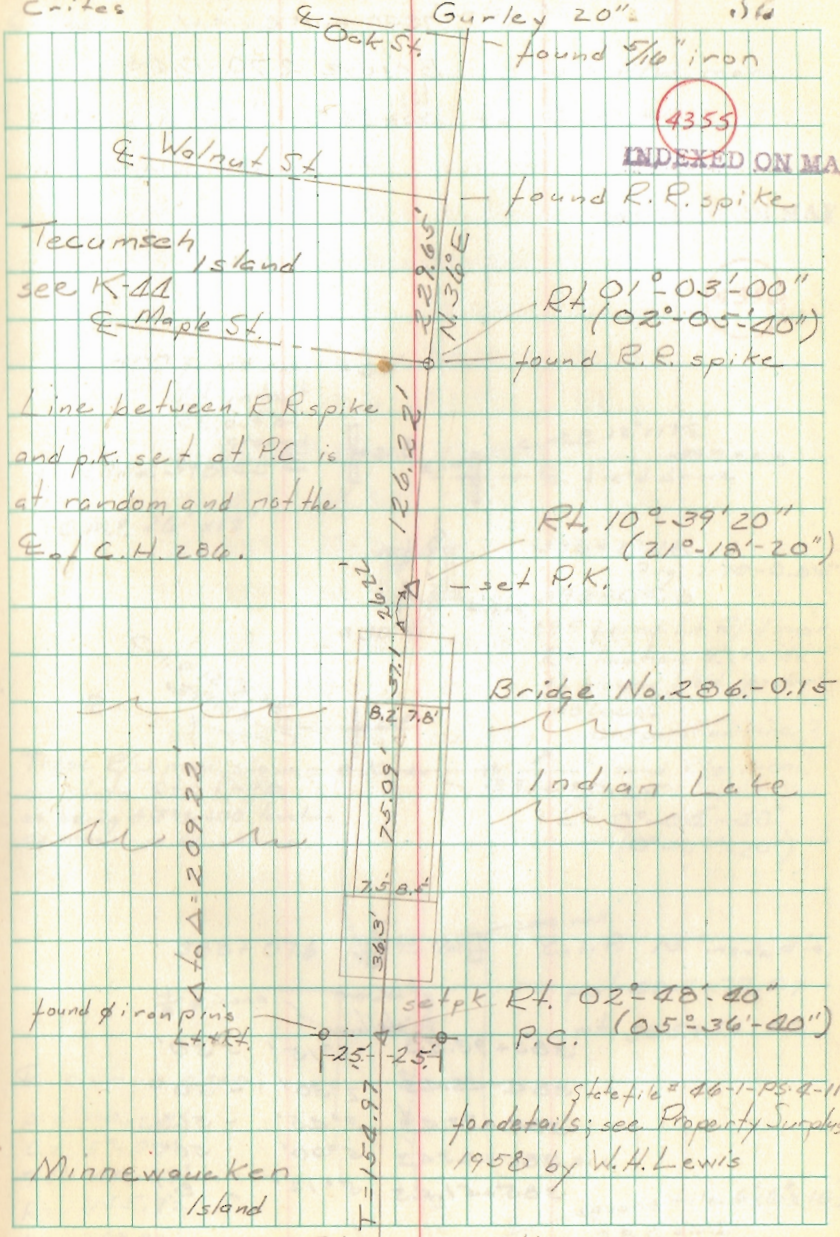
27 June 1967
Sunny 90° calm
Gurley 20"