LOT 26-27
SEMINOLE ISL.

A = 3/4" Pipe found
B = " " "
C = 1/2 " "
D = " " "

.025

421.60'
-0.10
421.50
.58
420.92
+.37
421.29

0.58

120.93
100.00

4.22
.025
2110
844
.10550

58
37
+.19

.37

INDEXED ON MAP
9627

Dodson
Artis
McCurdy
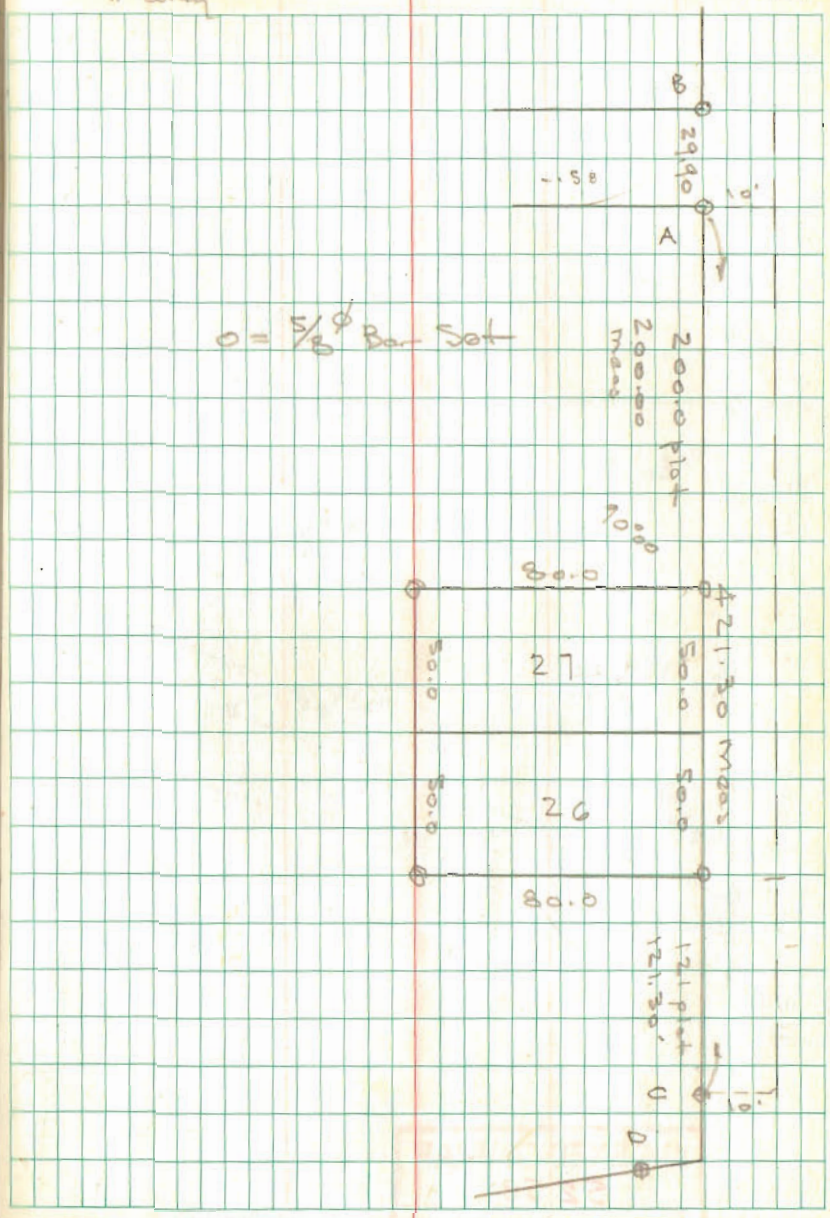
2/3/74
30°