Road #45
Union Twp.

This Road is 40' (see Index)

Stakes were set. 20' from ℄ on S. side of road. No Measurements taken.

1346
INDEXED ON MAP
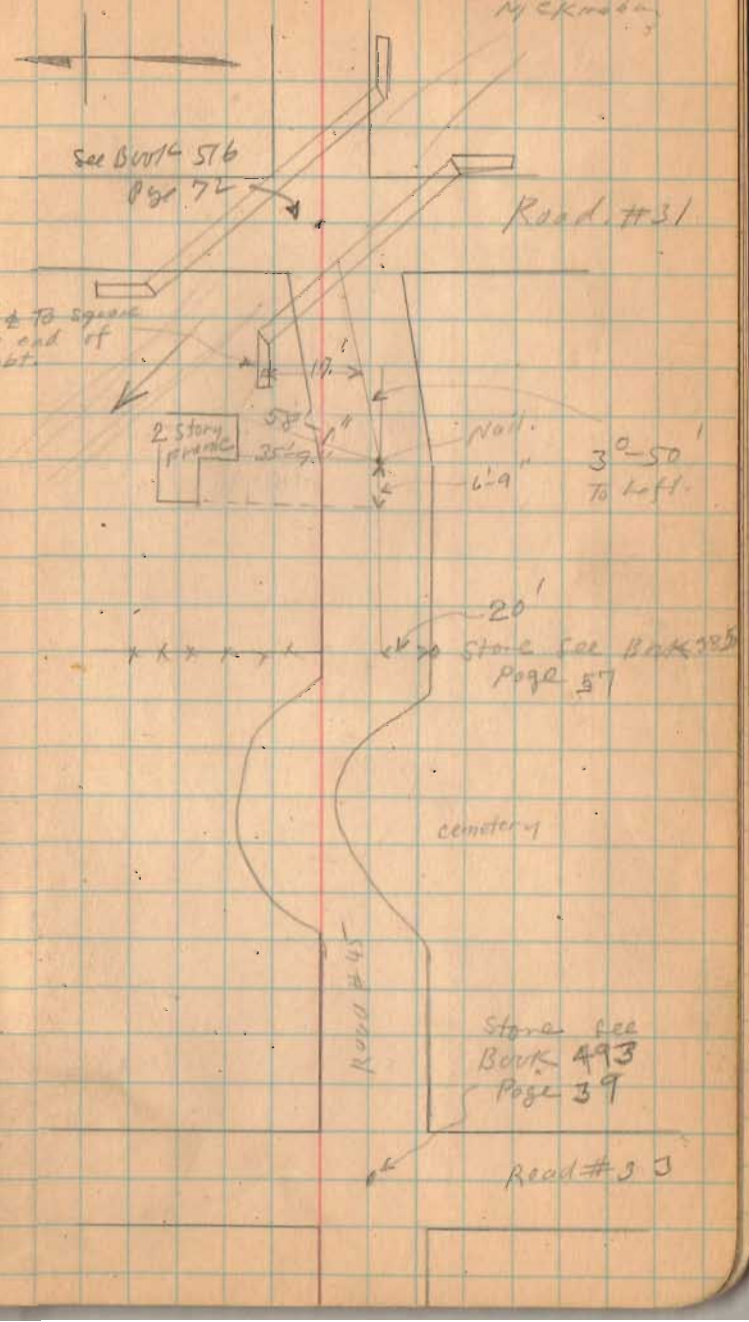
Aug-15-1925
Aug-17-1925 17
Wright
McKinney