Survey of line between
Dallas Brenner & Paul Bissell

Union Twp. Sec. 14 T-3-R-14 March 7, 1852
G.W. Wilgus
D.L. Dodson - Notes

Measured line "E-D" & "D.F" - found stone at "D" on line with fence to the North

Line "E-D" - distance from deed of Dallas Brenner Vol. 168 pg. 315

Line "D C" - distance from deed of Dallas Brenner Vol. 168 pg. 315

Projected line "E-D" to "C", measured deed distance and set 2"x2"x12" hub
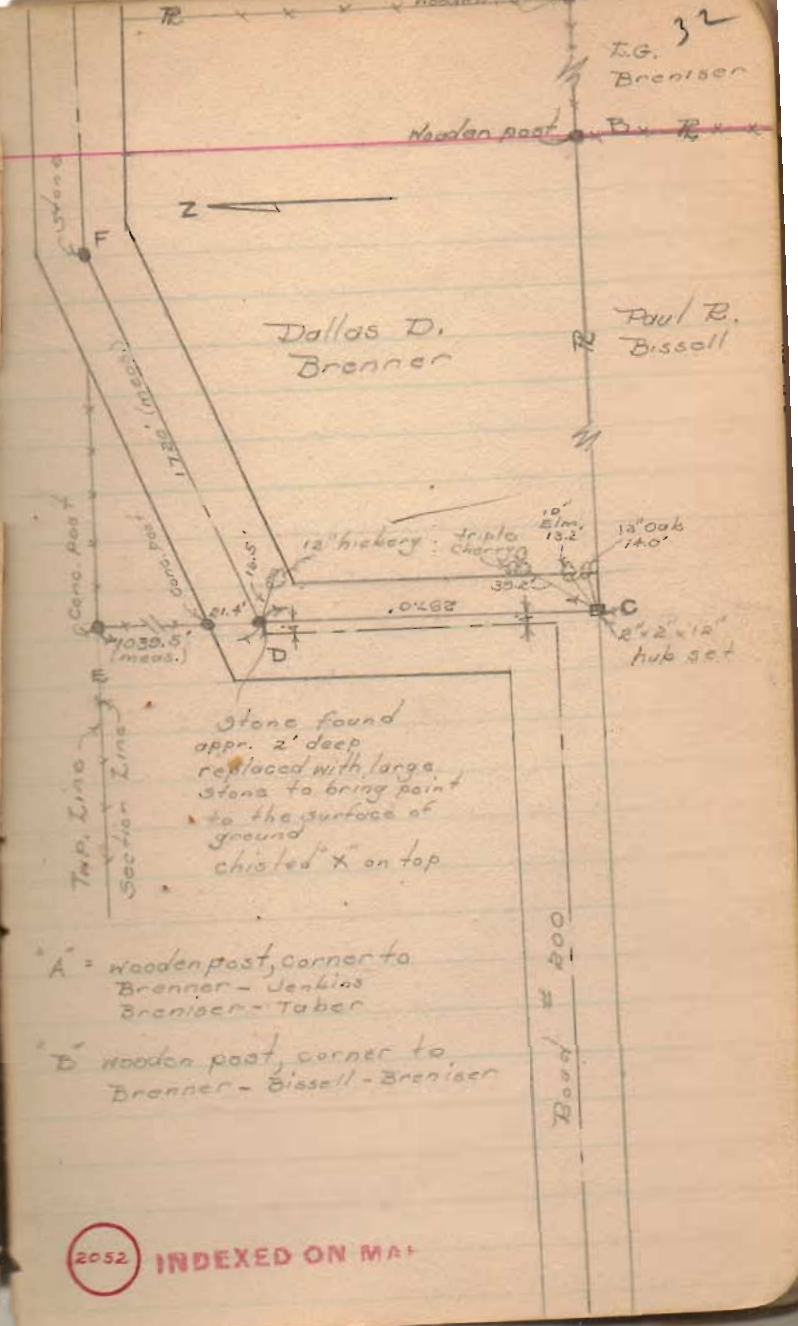
Ran offset line 20' South of line "A-C" found "B" to be on line with "A-C"; set stakes 20' North of offset line for Property line between Paul Bissell & Dallas Brenner