BAILEY SURVEY.

DUNN'S POND

Washington Twp. { 10121, 9946, 9925

See Drawer R for Map

A - Iron Found.

B " " (Same as F Book 390 Page 4)

C Point in center of St.

D Iron Placed. Iron Post 36" Long. Found 5-8-48

E Stake Placed with tack.

F " " " " Placed 1" Iron 5-8-48

F & D on ℄ of St. Produced.

"D" Placed Same elevation as "A."

D 63' from water

See Drawing J-27 for Print of Dunn's Pond

Found D
" F - Placed 1" Iron
New Witnesses
May-8-1948
F.F. Wright
Grover Wilgus.

see Book 390 Page 4 for survey of Dunn's Pond

May-9-1948 Wright Ed Corr. 18

INDIAL LAKE.

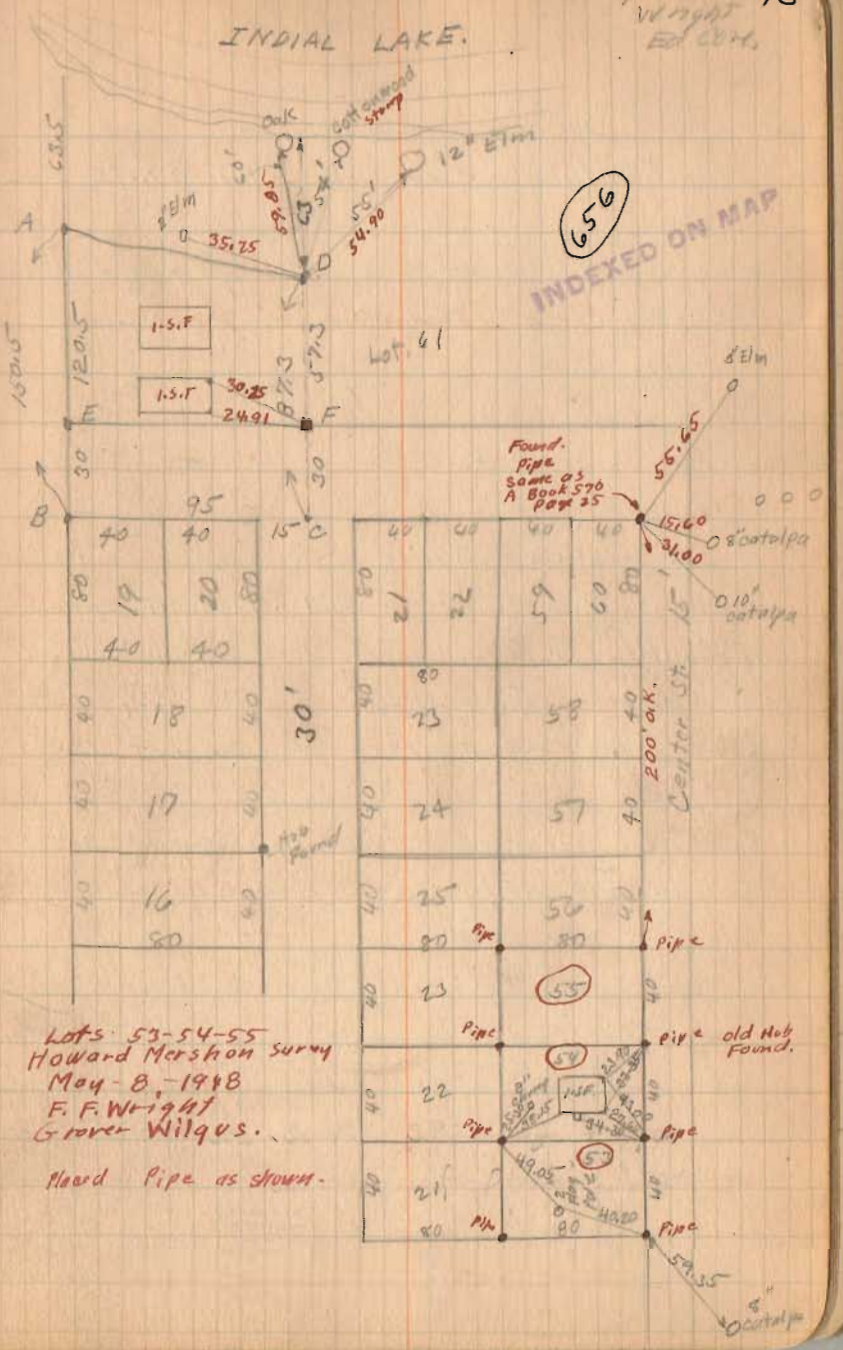

656

INDEXED ON MAP

Lots 53-54-55
Howard Mershon Survey
May-8-1948
F. F. Wright
Grover Wilgus.

Placed Pipe as shown.