FB 704

R/W LOCATION CR 37
LEWISTOWN
WASHINGTON TWP.

Point A = 1"ϕ Bar Set
B = 1"ϕ Bar Set
C = 1½" x 1" Iron Fd
D = R/R Spike Fd
E = R/R Spike Fd

℄ CR 61 Located by Pt "C" and Sta 24+37.8 (1" x ½" Iron) See Bk 560/62

℄ CR 37 Located by Pt. "C" and Pt "E" (Sta 10+05.5) See Bk 577 Pg 9/11

℄ R/R Located by Pt "D" and split of Main Line Rails 60'± South of CR37

Dec 28, 1965

Gaasch
Slater
Johnson

5

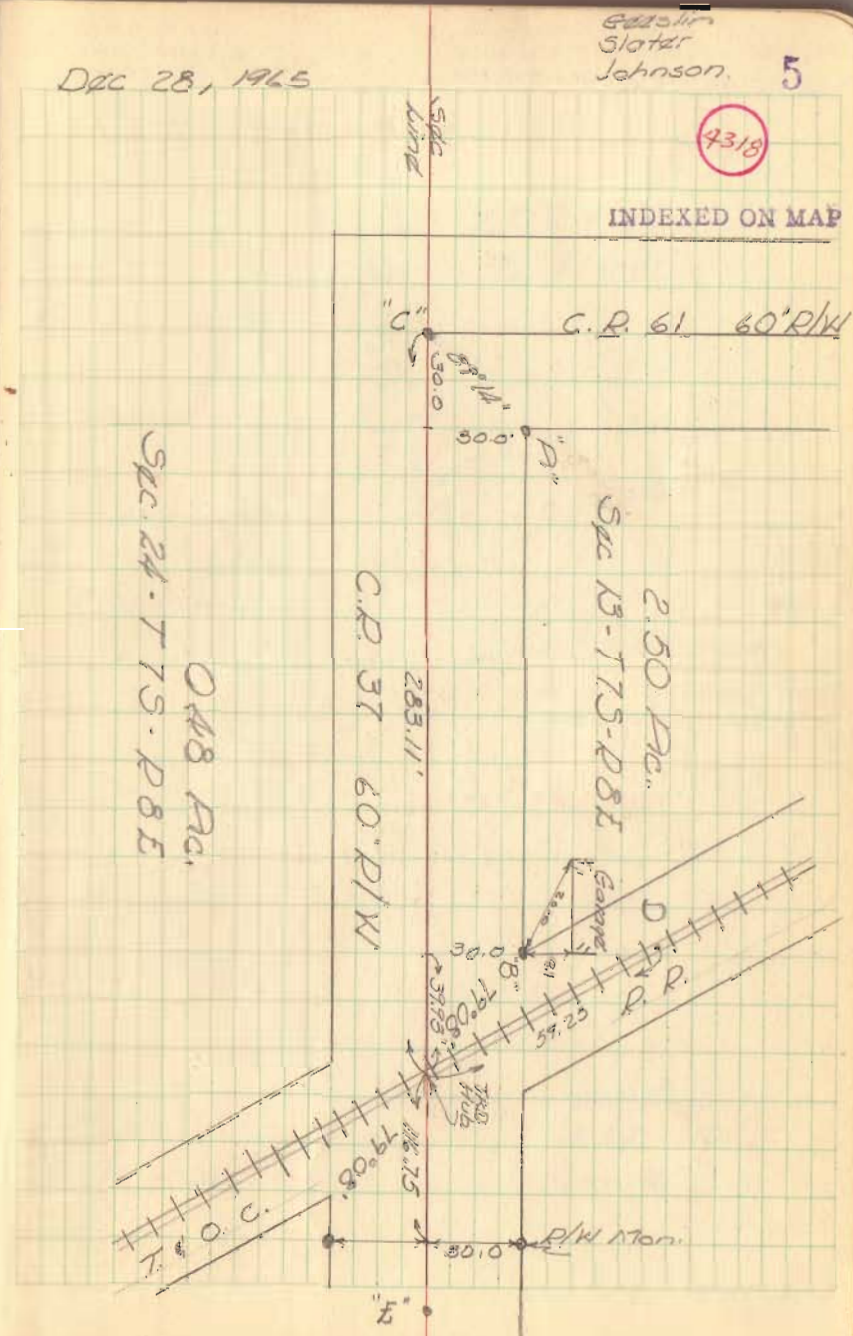
INDEXED ON MAP