Library Lot Zanesfield

Lot #11

Used East side of East Sidewalk for Lot Line. This makes Sandusky St. 60' O.K.

Measured North from the ℄ of Converse on Columbus St. Measured as shown to ℄ of Locust St. This was O.K. for Apparent ℄ of Locust St.

Then measured again from ℄ of Columbus St. as shown and set corners to Lot #11

A - ½" Iron 30" long placed by Wright

B - ½" " " " " " "

C ½" " " " " " " (Not Lot Cor.

D Chisel mark on edge of walk. (Lot Cor.

E Temporary point on walk.

F Hub on line AE near end of walk.

No Old monuments found

Noted that Corners A & B were about 16' from Fence Line on East side of Cherry Alley.

Note that this is the same as the original Allotment.
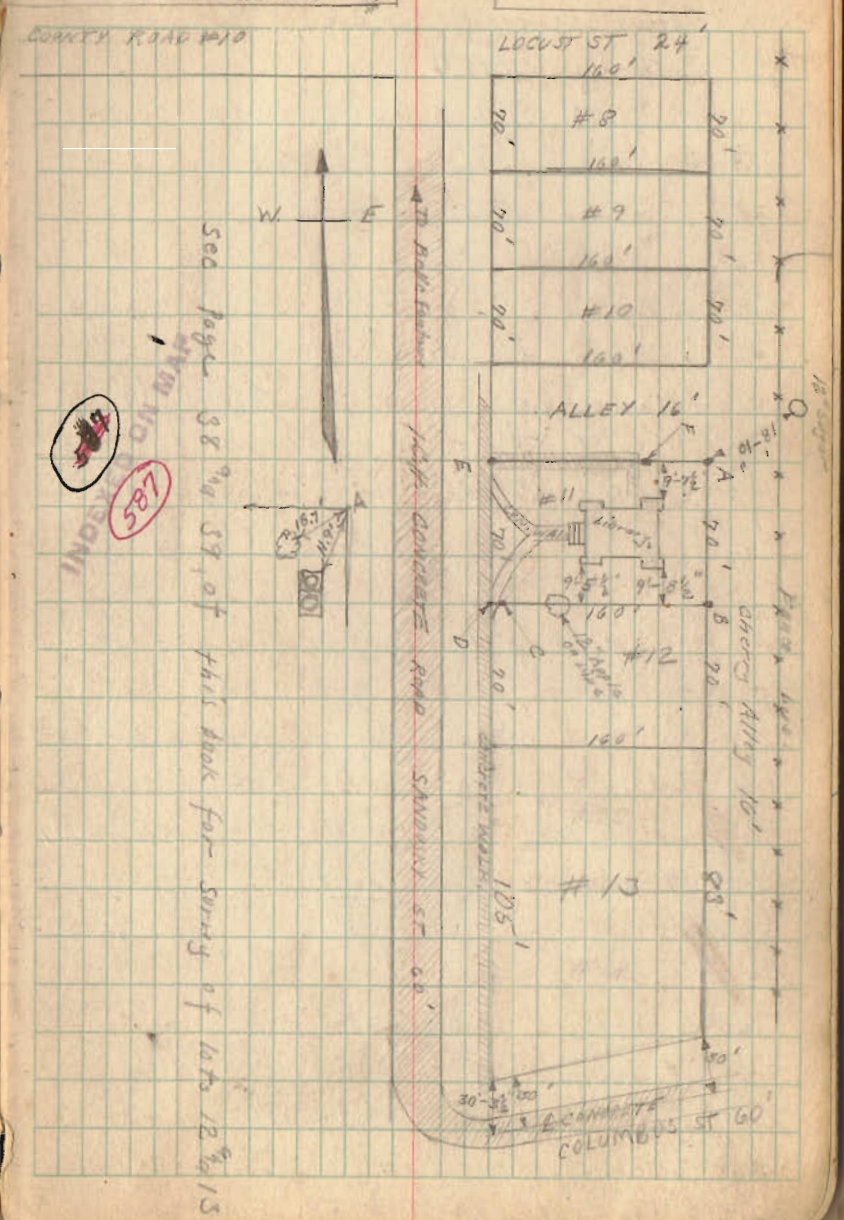
April-14-1926
Clear
Wright
Smith & Co
E.C. Williams