

NUMBER	GRANTOR	GRANTEE	INSTRUMENT	DATE	RECORD	CUSTODIAN
23	Ben D Veder	C&C RR	W.D.	2/26/28	131/17	145
24	Dellie Penner	C&C RR	W.D.	1/30/28	131/18	145
25	Wm R Boyles	C&C RR	W.D.	4/26/28	131/19	145
26	J C Whitson	C&C RR	W.D.	10/25/28	131/20	145
27	J C Whitson	C&C RR	W.D.	5/19/27	137/28	145
28	J C Whitson	C&C RR	W.D.	5/19/27	137/29	145
29	J C Whitson	C&C RR	W.D.	5/19/27	137/30	145







**RIGHT-OF-WAY AND TRACK MAP**  




 

\* See No. 23, Sheet 522A  
 1. 23  
 2. 24  
 3. 25  
 4. 26  
 5. 27


RIGHT-OF-WAY AND TRACK MAP  
 THE CLEVELAND, CINCINNATI, CHICAGO & ST. LOUIS RY. CO.  
 SANDUSKY DIVISION—GAIN LINE  
 Scale 1" = 100 Ft.  
 Office of Mechanical Engineers, Cincinnati, O.  
 THIS PROPERTY MERGED WITH THE C.C. & ST. L. RY. CO.





STATION MAP—TRACKS AND STRUCTURES  
 THE CLEVELAND, CINCINNATI, CHICAGO & ST. LOUIS RY. CO.  
 THE CINCINNATI, CLEVELAND & CINCINNATI RY. CO.

Operated by  
 SANDUSKY DIVISION, MAIN LINE

Sta. 5248+00 To Sta. 5259+00  
 Scale 1 in. = 100 ft.

June 20th 1915  
 Office of Valuation Engineer, Cincinnati, O.

W420  
 5259+71

5289+71 (Match Mark for Next Sheet) PUBLIC ROAD 1218 to 14 1/2 ft. 85+32 N 87°03'W - 5289+71.7

LAKE TWP.  
 LIBERTY TWP.

5289+71.7

81+44  
 81+45  
Storage Yards

BELLEFONTAINE O.

5th Sec 33

NEW Sec 33



PS 1, 81+67

PS 1, 81+67

NW 1/4 Sec 34

NE 1/4 Sec 34

BELLEFONTAINE O.

NE 1/4 Sec 33

 




**RIGHT-OF-WAY AND TRACK MAP**  
 THE CINCINNATI, CLEVELAND & ST. LOUIS RY. CO.  



 

See No 15 Sheet 26  
 25  
 26  
 27

NUMBER	GANTER	GRANTEE	INSTRUMENT	DATE	RECORD	CUSTOMER
1	Alber Back	M.R.L.R.R.	Court Decision	May Term 1839	L/33	19
2	Uziel Yoder	C.C.R.R.	Passession	7/21/04	104/44	80
3						
4	Right to cross Deaneff Public Road	M.R.L.R.R.	None Found	5/1/79	F/30	81
5	John Paddock		Condemnation	May Term 1839	F/21	73
6	David Snider et al		Release	4/27/35	F/35	77
7	Thos. Deaneff		Court Decision	May Term 1839	F/35	77
8	Thos. Deaneff		Released	4/27/35	81/15	92
9	Thos. Deaneff					
10	Sold					
11						
12						
13						
14						
15						
16	Uziel Yoder			2/4/76	131/62	144
17	Chas. Bohner			3/29/76	131/713	147
18	Adin Hudson Street			4/15/76	131/713	147
19	Mary E. Hill			4/15/76	131/713	147
20	David Cook			3/11/76	131/158	146
21	David Cook			3/8/76	131/158	146
22	Mary Green			6/5/76	131/158	146
23	Mary Green			4/8/76	131/158	146
24	David Cook			3/8/76	131/158	146
25	R.W. Basing			12/18/75	130/592	147
26	B. Stutzman			1/8/76	130/577	134
27	Edw. Ricketts			5/31/76	131/221	152
28	C. Oryster et al.			2/15/76	130/554	152
29	J. Mast et al.			3/19/76	110/133	119/195
30	Sho. Mussler et al.			12/29/75	110/154	74
31	David W. Com.			3/29/76	89/213	109/171
32	O.S. Candlish & Hubbard			12/19/75		158
33						
34						
35						


RIGHT-OF-WAY AND TRACK MAP  
 OF THE  
 M&O RAILROAD  
 THROUGH  
 LOGAN CO. & CHAMPAIGN CO. OHIO





B

Match Mark for Next Sheet # 25

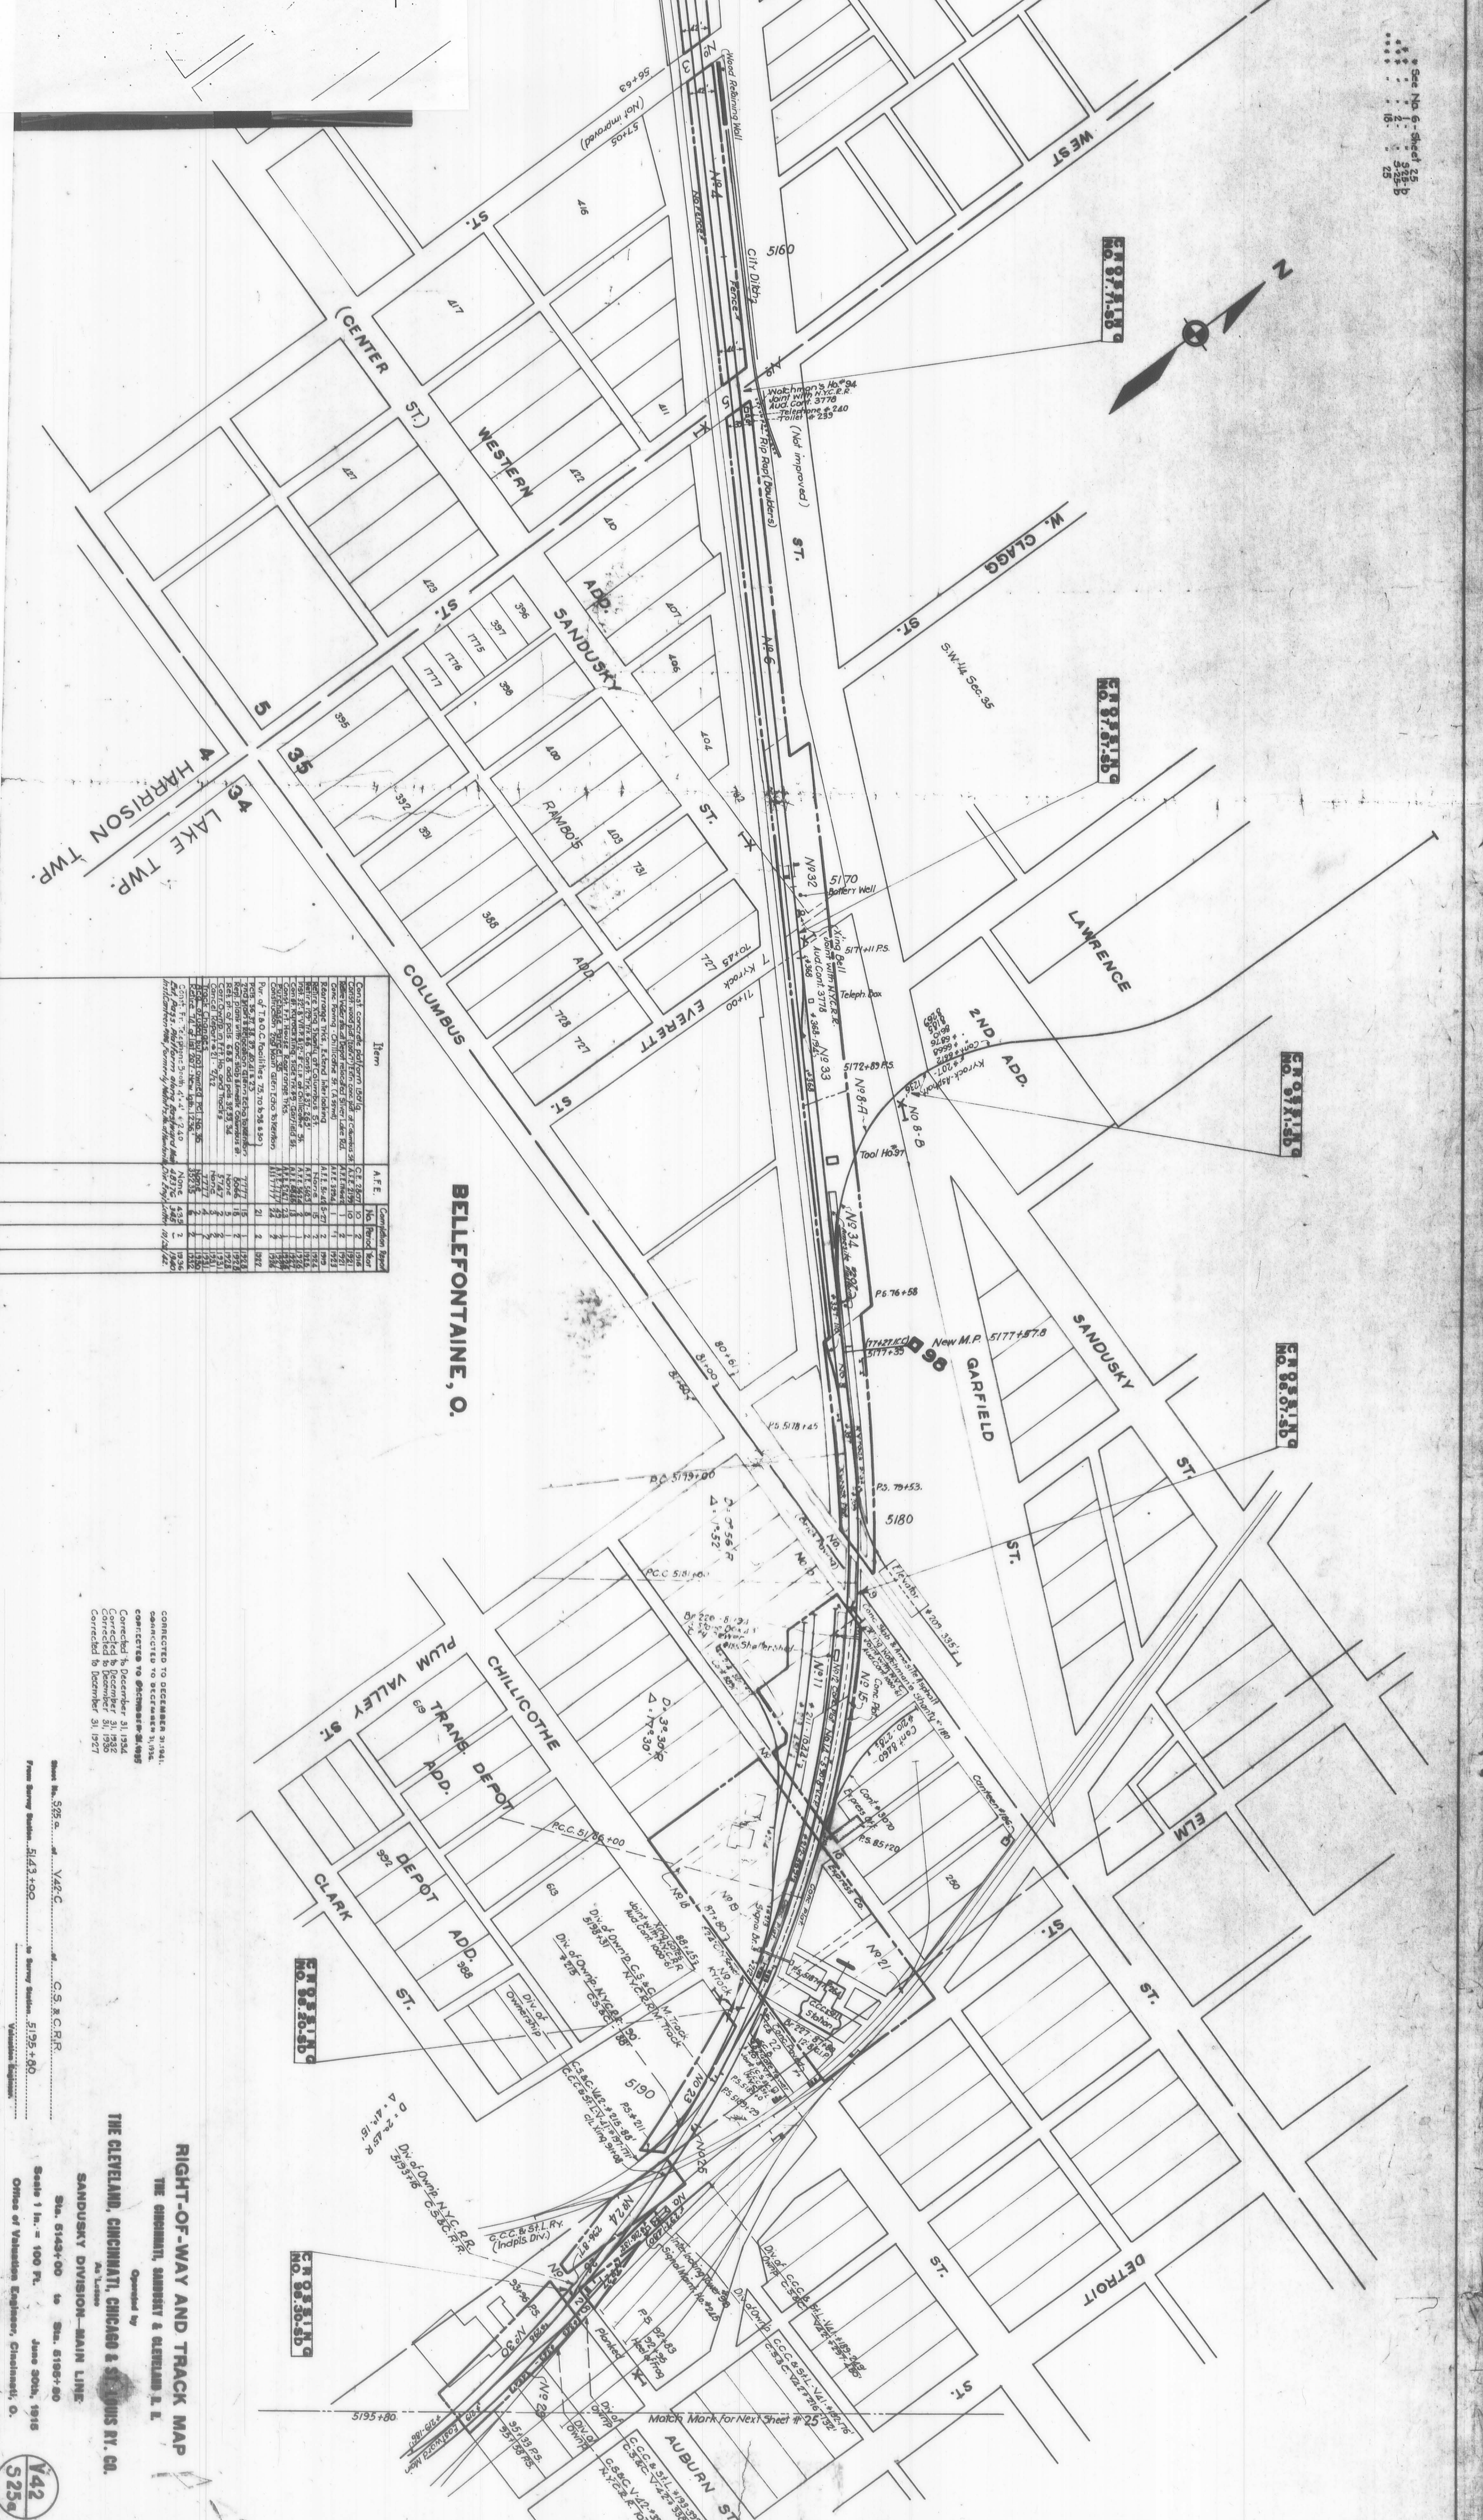


RIGHT-OF-WAY AND TRACK MAP  
 THE CLEVELAND, CINCINNATI, CHICAGO & ST. LOUIS RY. CO.  

