


Match Mark for Sheet #22.


100.6600-03

 

CROSSING  
NO. 125, 20-IN.

CROSSING  
NO. 125, 30-IN.

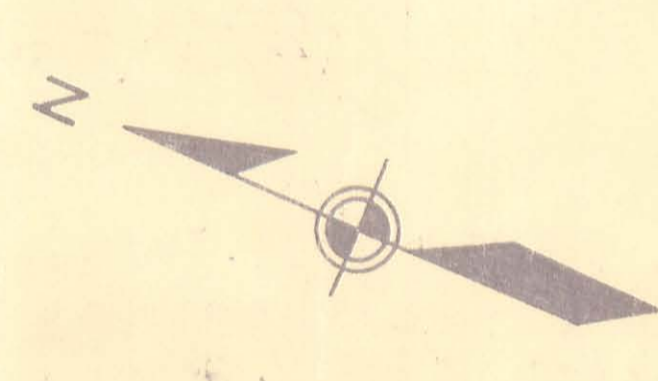

1951	4-27-53
1952	No Change
1953	"
1954	"
1955	"
1956	11-3-58
1957	2-5-60
1958	No Change

R-46

RIGHT-OF-WAY AND TRACK MAP  
 THE CLEVELAND, CINCINNATI, CHICAGO & ST. LOUIS RY. CO.  
 THE CLEVELAND, CINCINNATI, CHICAGO & ST. LOUIS RY.  
 OPERATED BY  
 THE CLEVELAND, CINCINNATI, CHICAGO & ST. LOUIS RY. CO.  
 INDIANAPOLIS DIVISION—MAIN LINE  
 Sta. 6600+00 To Sta. 6705+00  
 Scale 1 in. = 200 Ft.  
 June 30th, 1915.  
 Office of Valuation Engineer, Cincinnati, O.

\* See No. 5, Sheet 22  
 \* See No. 16, Sheet 24  
 \* See No. 17, Sheet 24  
Match Mark for Sheet #26.

7022+40.

133-20 Br #101  
42" 18" Conc Pipe  
18" 18" Conc Pipe Ext

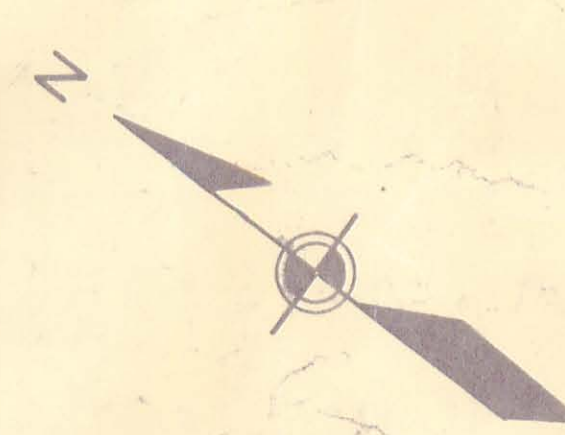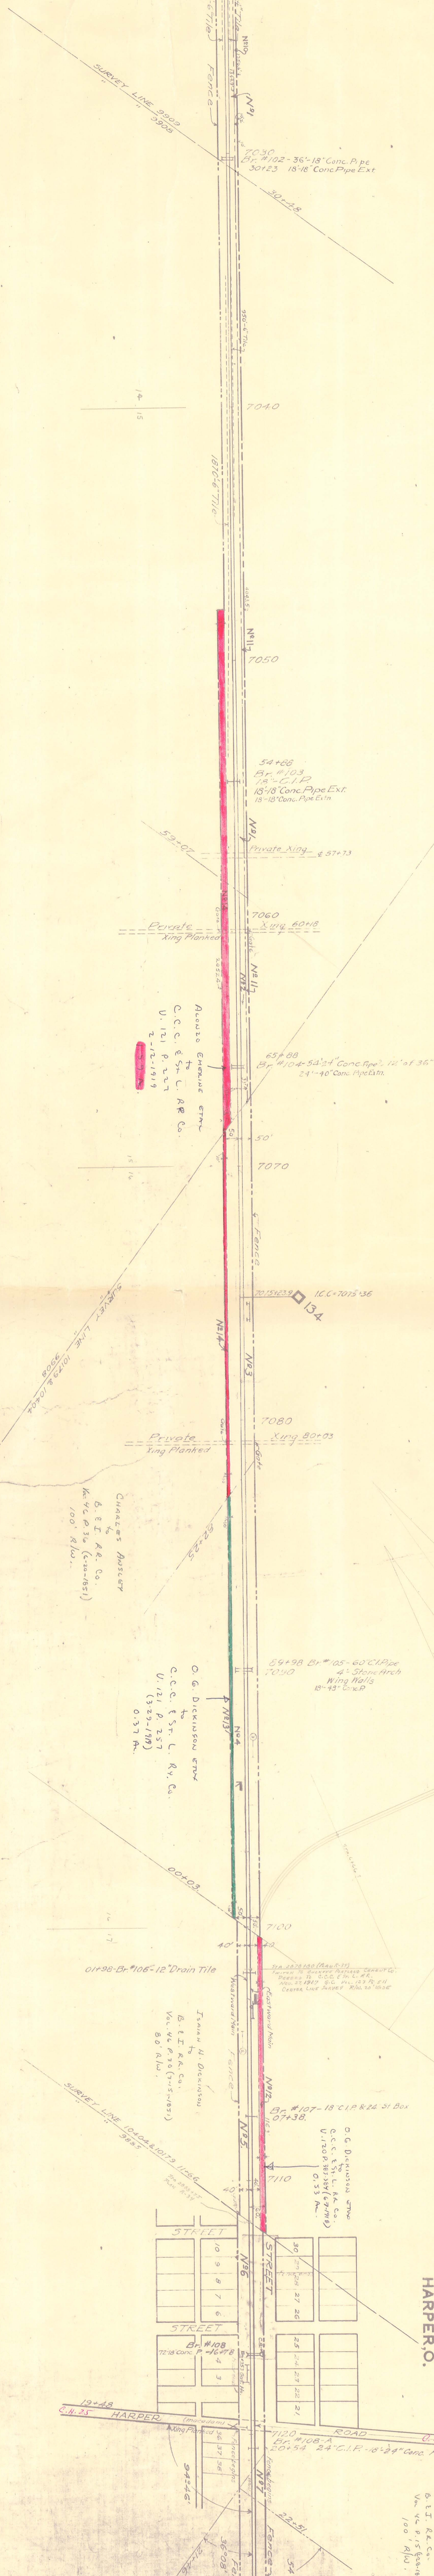


See No. 26 - Sheet 26  
 .. 20 - 1 - 25  
 .. 20 - 1 - 25

Date	Description
1951	No Change
1952	" "
1953	" "
1954	" "
1955	" "
1956	" "
1957	2-5-60
1958	1/2-2-8-61

CONNECTED TO DECEMBER 1950  
 CONNECTED TO DECEMBER 1954  
 CONNECTED TO DECEMBER 1954

Sheet No. 27 of X-14  
 from Survey Station 7022+40  
 to Station 7120+00  
 Office of Valuation Engineers, Cincinnati, O.

**RIGHT-OF-WAY AND TRACK MAP**  
 THE CLEVELAND, CINCINNATI, CHICAGO & ST. LOUIS RR.  
 INDIANAPOLIS DIVISION - MAIN LINE  
 Opened by  
 THE CLEVELAND, CINCINNATI, CHICAGO & ST. LOUIS RR. CO.  
 Scale 1 in. = 200 ft.  
 June 30th, 1915

**HARPER O.**

**CROSSING**  
 NO. 134 841 IN

Match Mark for Sheet #28.

7120+00.

V-41  
 27