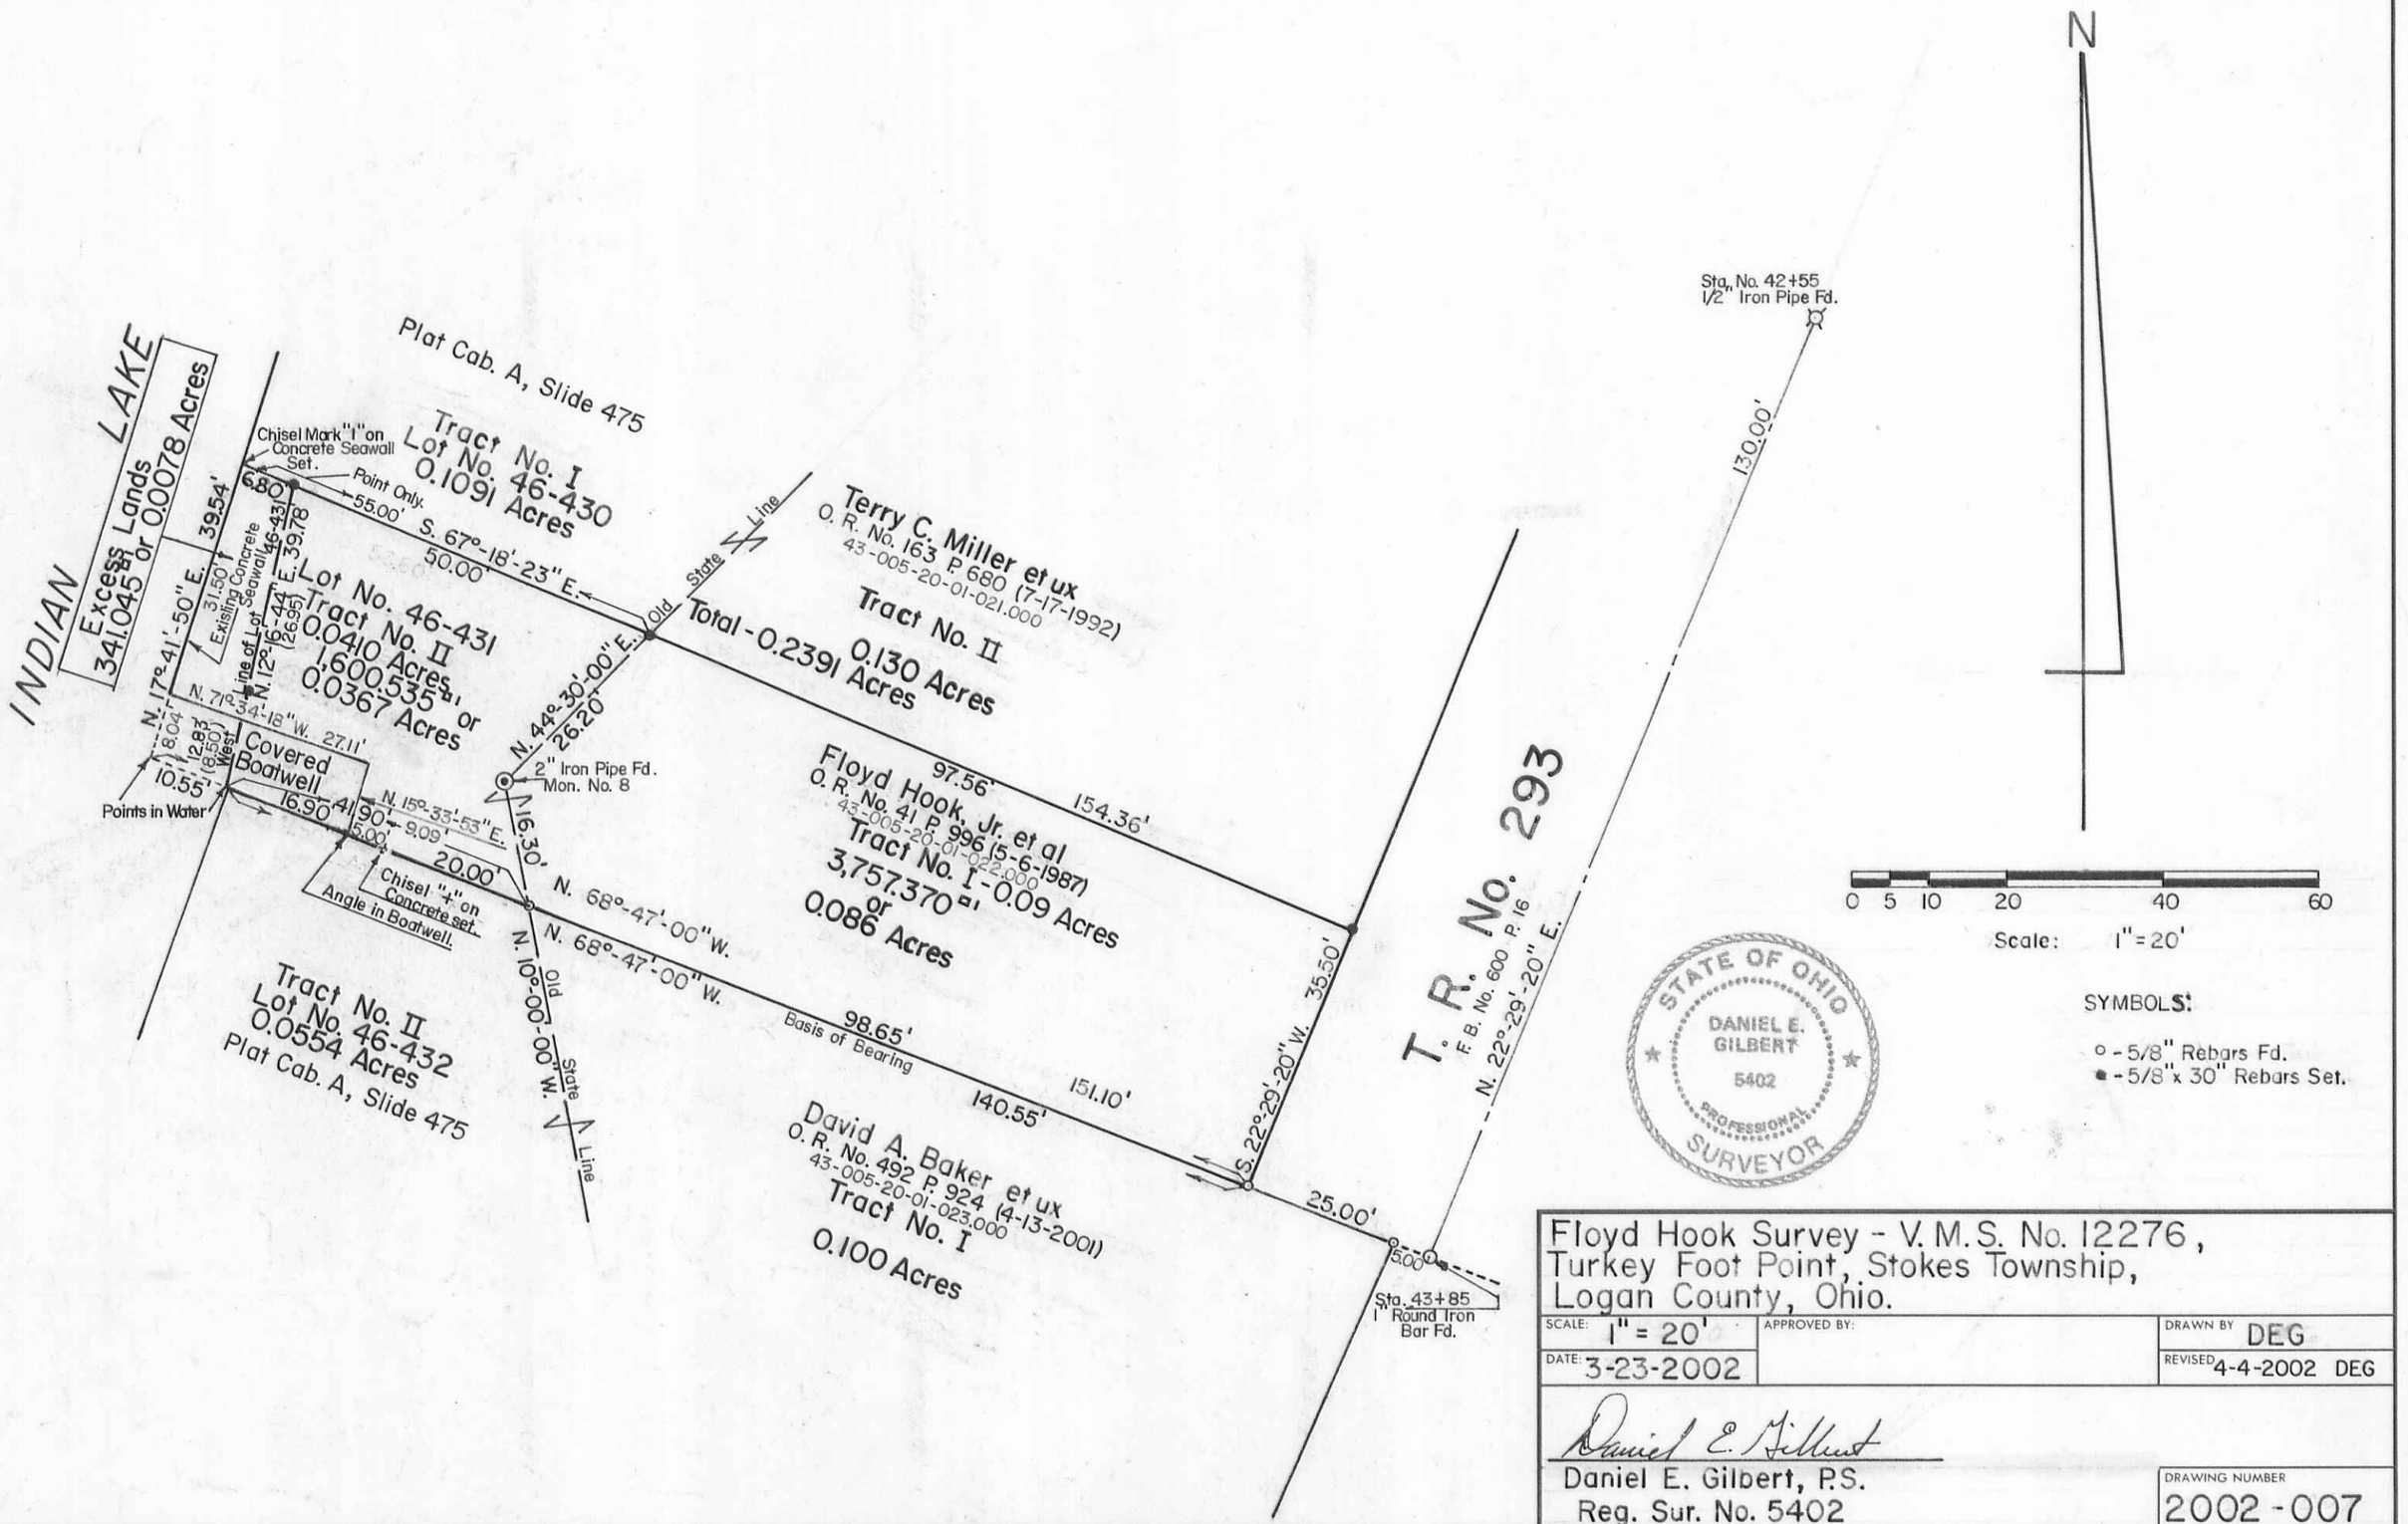

Floyd Hook Survey - V.M.S. No. 12276,
Turkey Foot Point, Stokes Township,
Logan County, Ohio.

SCALE: 1" = 20'	APPROVED BY:	DRAWN BY DEG
DATE: 3-23-2002		REVISED 4-4-2002 DEG

Daniel E. Gilbert

Daniel E. Gilbert, P.S.
Reg. Sur. No. 5402

DRAWING NUMBER
2002 - 007

INDEXED ON MAP
5899

S-422