

To whom it may concern:

I, Daniel E. Gilbert, P.S., Reg. Sur. No. 5402, do hereby certify to The Huntington National Bank and the Ohio Bar Title Insurance Co. that on October 10, 1995, I personally located the improvements as shown on the accompanying plat and that I did not find any encroachments.

Daniel E. Gilbert
Daniel E. Gilbert, P.S.
Reg. Sur. No. 5402
400 N. Park St.
Bellefontaine, Ohio
43311-2448
Phone: 1 (513) 593-1428





East Liberty Real Estate Co.
O.R. No. 121 P. 26 (1-29-1991)
32-112-00-00-031.000
22.828 Acres


Richard W. Radlinski et al
O.R. No. 246 P. 51 (12-9-1994)
32-112-00-00-031.002
5.051 Acres

Gary D. Baker et ux
O.R. No. 250 P. 468 (2-25-1995)
32-112-00-00-031.003
29.736 Acres

John A. Raile et ux
O.R. No. 33 P. 163 (12-5-1986)
32-112-00-00-030.000
48.860 Acres

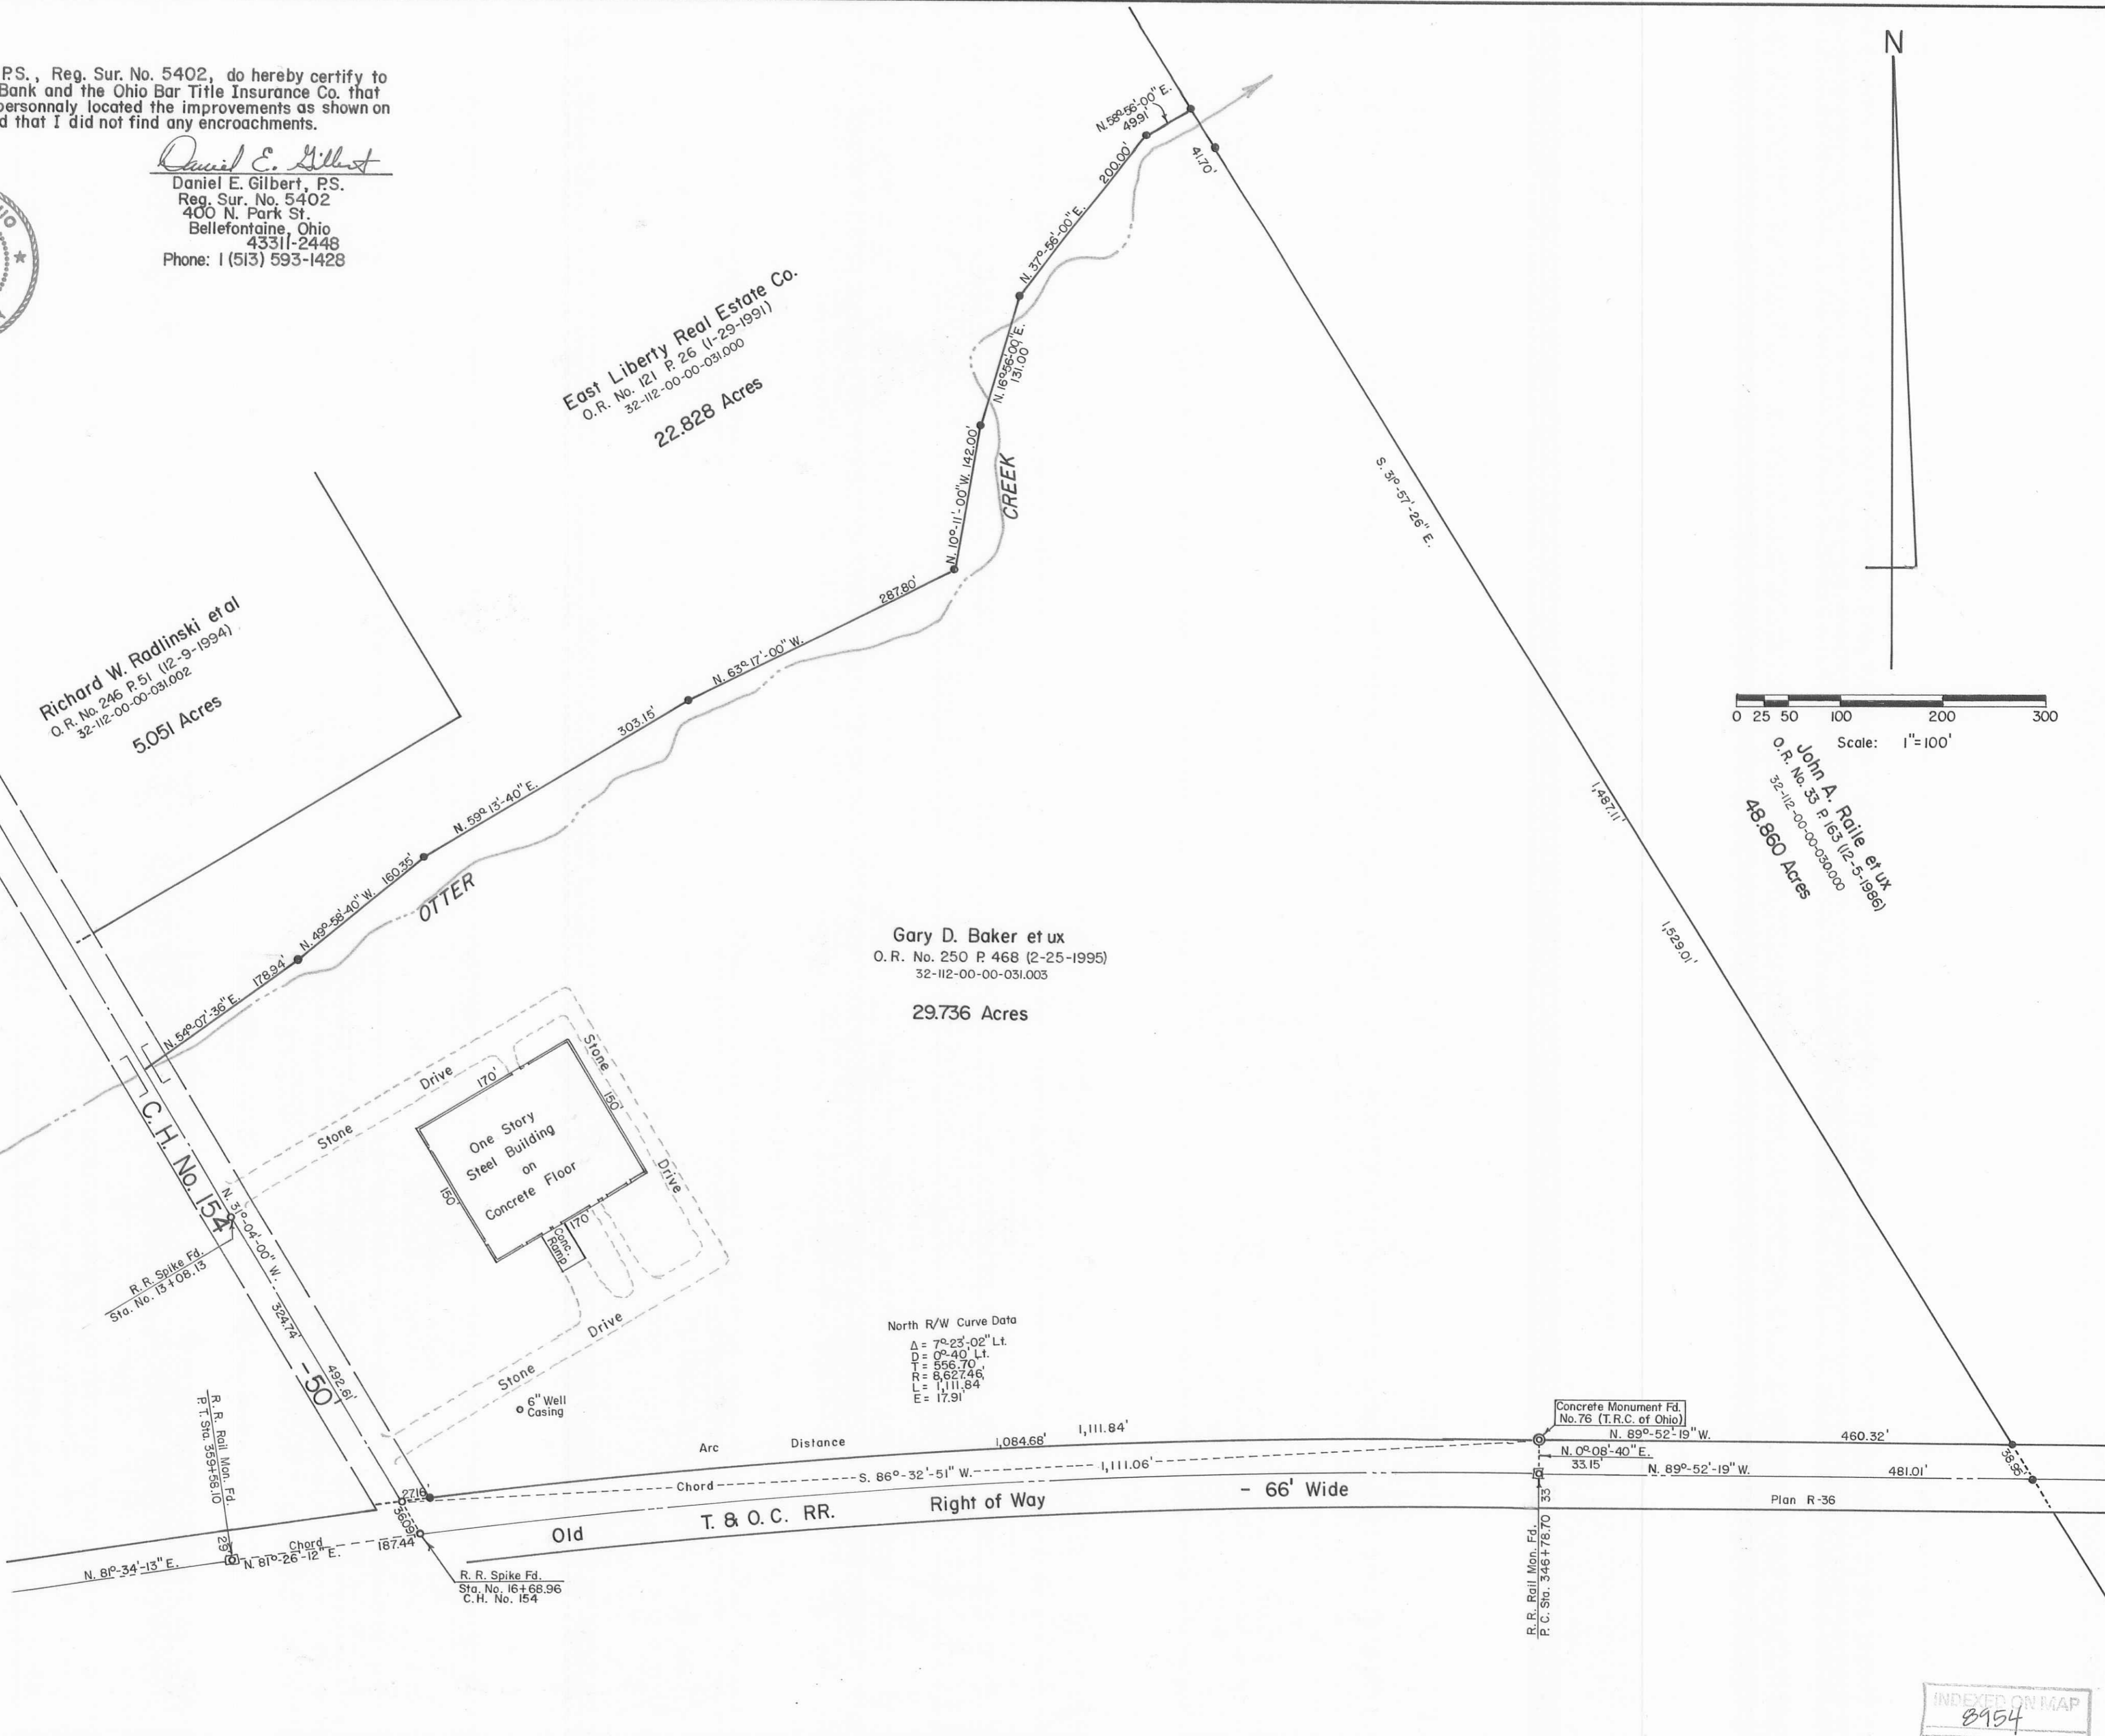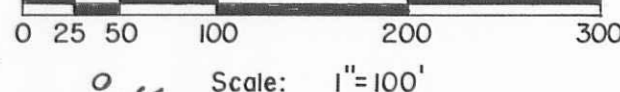

North R/W Curve Data
Δ = 7°23'-02" Lt.
D = 0°40' Lt.
T = 556.70'
R = 8,627.46'
L = 1,111.84'
E = 17.91'

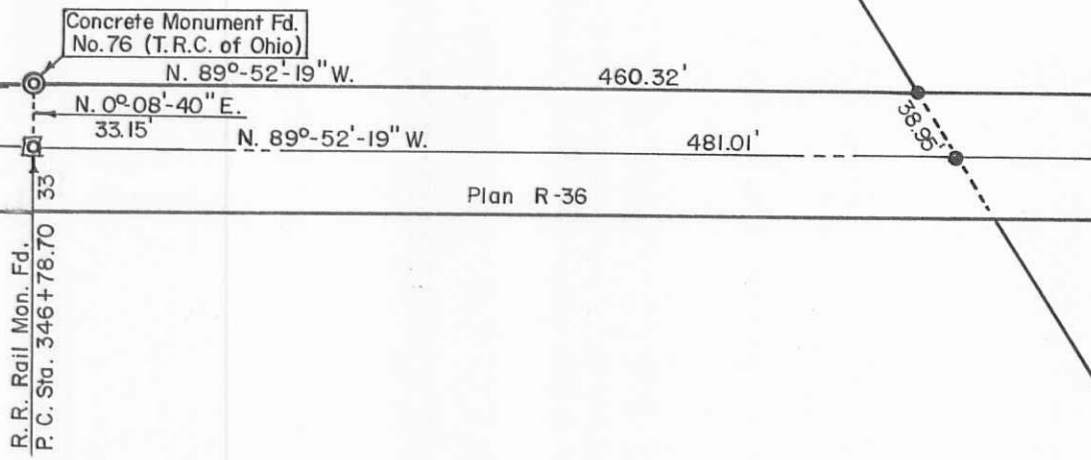

GARY D. BAKER et ux - Mortgage Inspection Survey
V.M.S. No. 4689
Logan County, Ohio,
Perry Township,
Daniel E. Gilbert
Daniel E. Gilbert, P.S.
Reg. Sur. No. 5402

DRAWING NUMBER
095-053

INDEXED ON MAP
8954