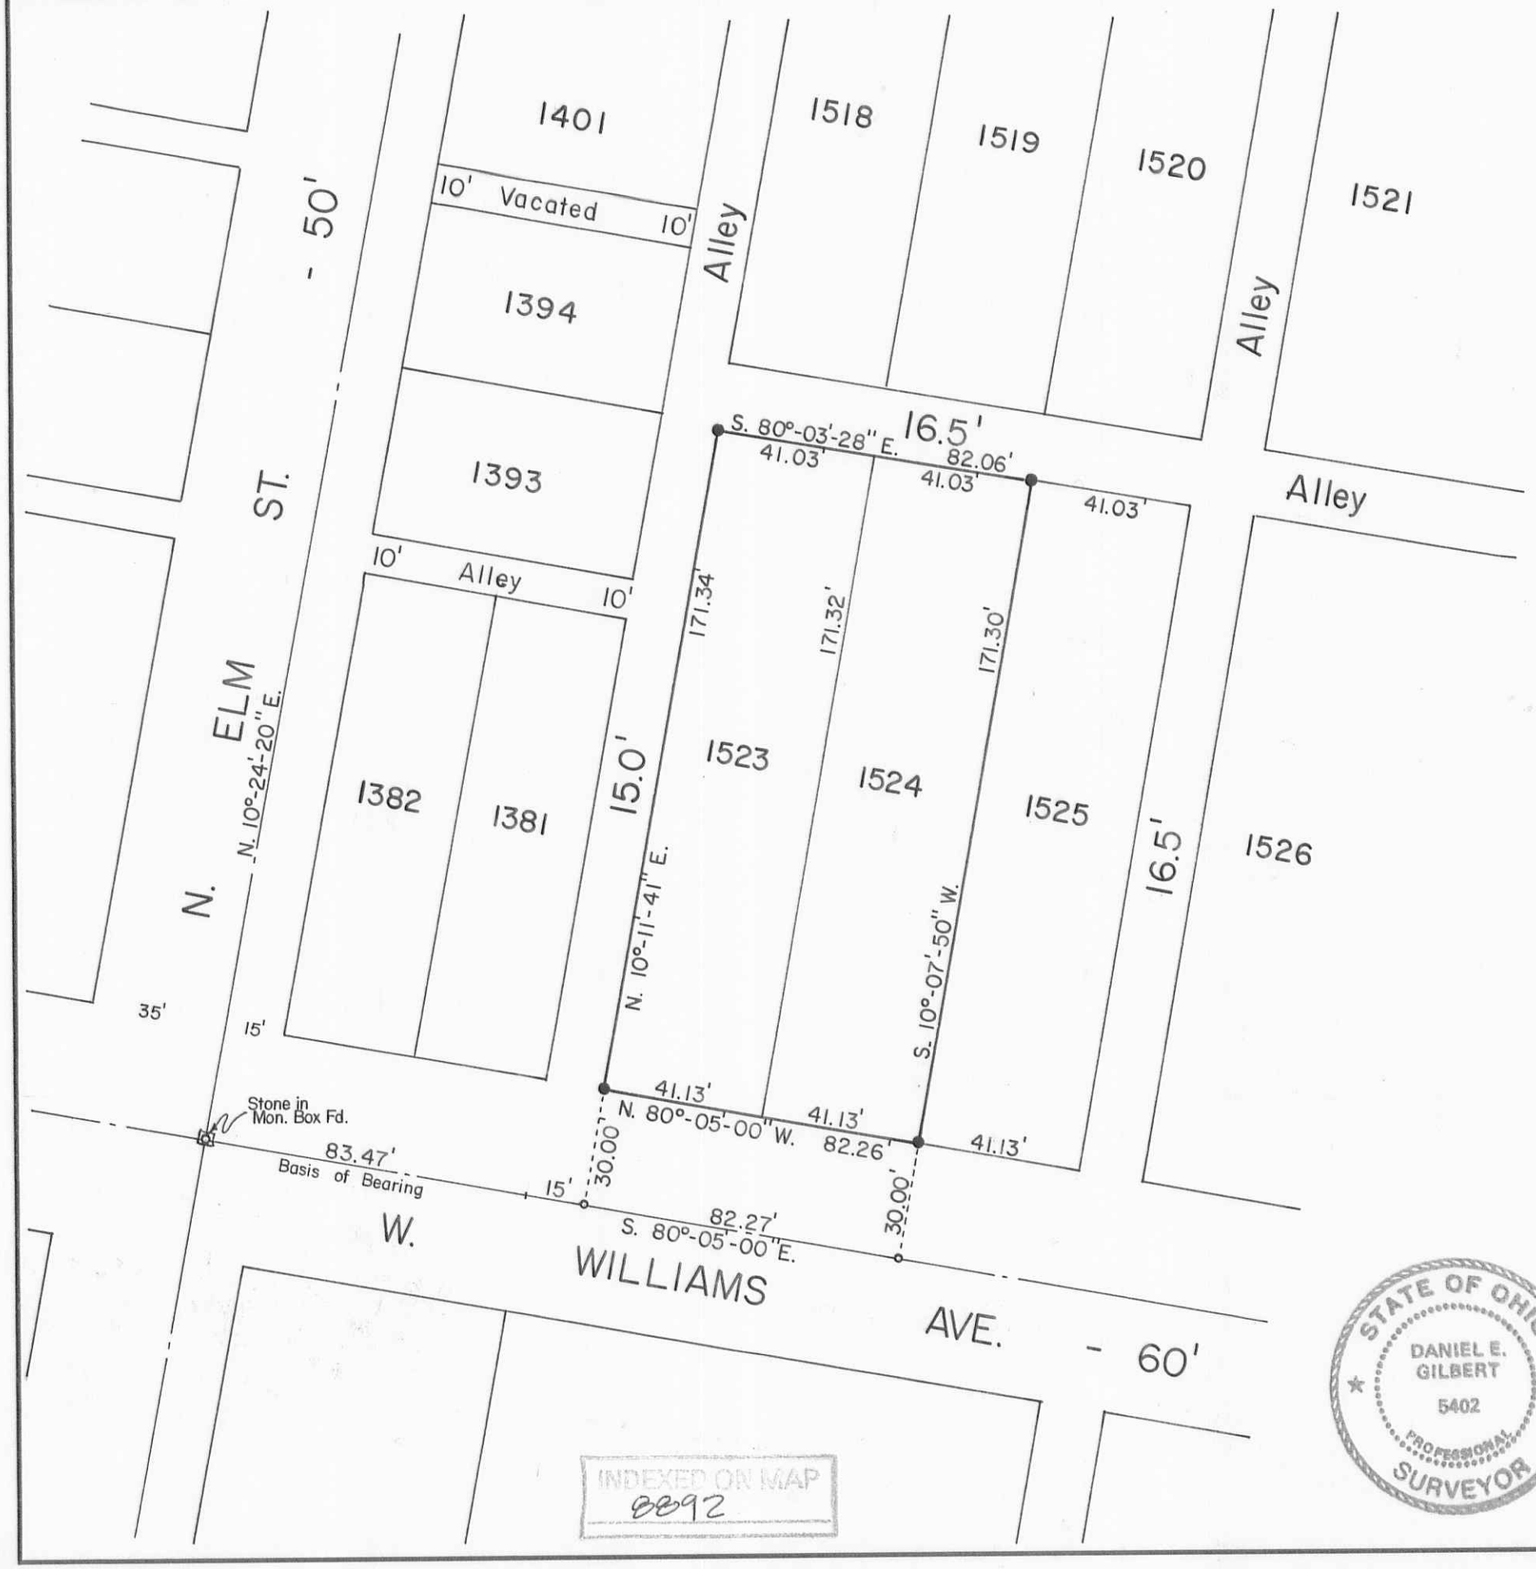

INDEXED ON MAP
8892

STATE OF OHIO
DANIEL E. GILBERT
5402
PROFESSIONAL SURVEYOR

N

0 20 40 80 120
Scale: 1" = 40'

SYMBOLS:
o – P. K. Nails Set.
● – 5/8" x 30" Rebars Set.

BALL SURVEY - Lots No. 1523-1524,
City of Bellefontaine, Lake Township,
Logan County, Ohio.

SCALE: 1" = 40'	APPROVED BY:	DRAWN BY DEG
DATE: 4-11-1994		REVISED

Daniel E. Gilbert
Daniel E. Gilbert, P.S.
Reg. Sur. No. 5402

DRAWING NUMBER
094-011

S-677