


Ross W. Nelson, Jr.  
 Vol. 381 P.349 (1-25-1979) et ux  
 Per. Pat. No. 12-108-00-00-064  
 14.88 Acres

Note:  
 Easement reserved for  
 possible extension to West  
 Carriage Hill Drive.

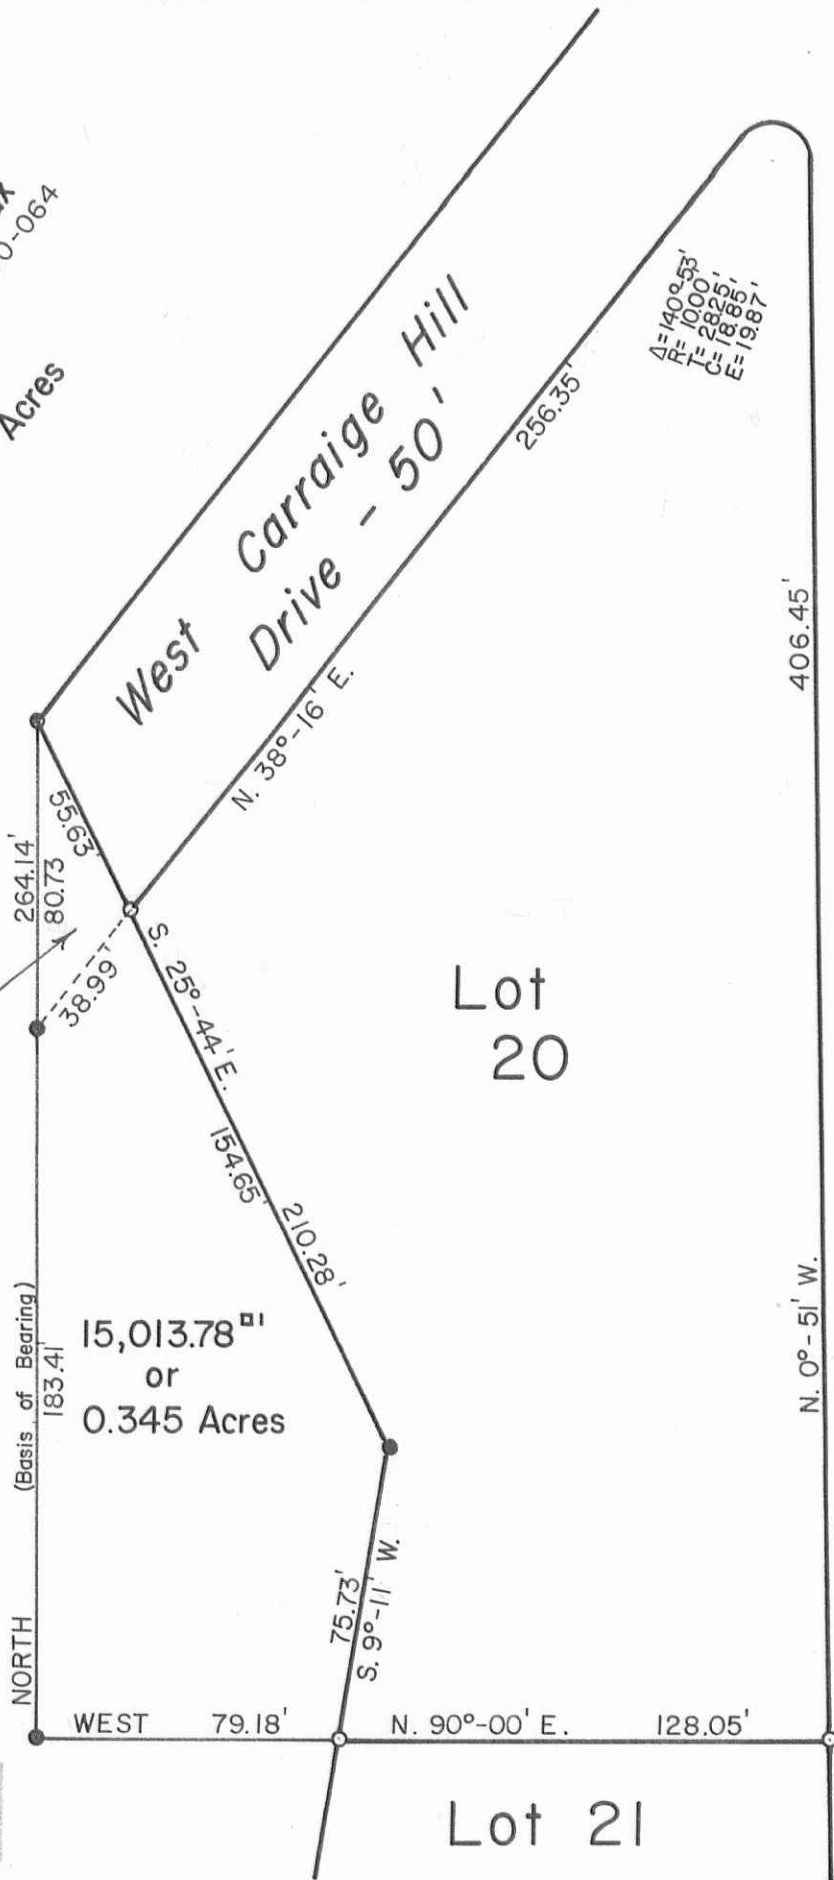

A=140°53'  

INDEXED ON MAP  
 2727

South Carriage Hill Drive - 50'

Lot 18

Lot 17


Lot 16



○ - 3/4" Iron Pipes Fd.  
 ● - 5/8" x 30" Rebars Set.

SURVEY OF LOT NO. 20-Carriage Hill Allotment No. 2 plus  
 Acreage, V.M.S. No. 4477, Jefferson Township,  
 Logan County, Ohio.

SCALE: 1" = 50'	APPROVED BY:	DRAWN BY DEG
DATE: 7-7-1989		REVISED

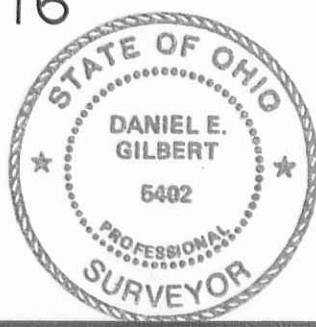

*Daniel E. Gilbert*  
 Daniel E. Gilbert, P.S.  
 Reg. Sur. No. 5402

DRAWING NUMBER  
 089-039

S-694