

Helen I. Bates
O. R. No. 225 P. 675 (4-29-1994)
36-022-00-00-030.000

69.95 Acres

James R. Patton et al
O. R. No. 99 P. 510 (12-21-1989)
36-022-00-00-004.001

13.465 Acres

Robert N. and Virginia R. Johnson, H/W
O. R. No. 224 P. 26 (4-12-1994)
36-022-00-00-005.000



287,078.565^{sq ft}
or
6.590 Acres

Roger Beaverson et al.
O. R. No. 54 P. 891 (12-1-1987)
36-022-00-00-006.000

7.01 Acres

Roger Beaverson et ux
O. R. No. 208 P. 489 (10-28-1993)
36-022-00-00-007.001

4.978 Acres

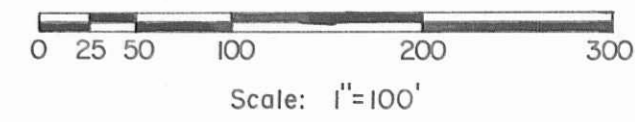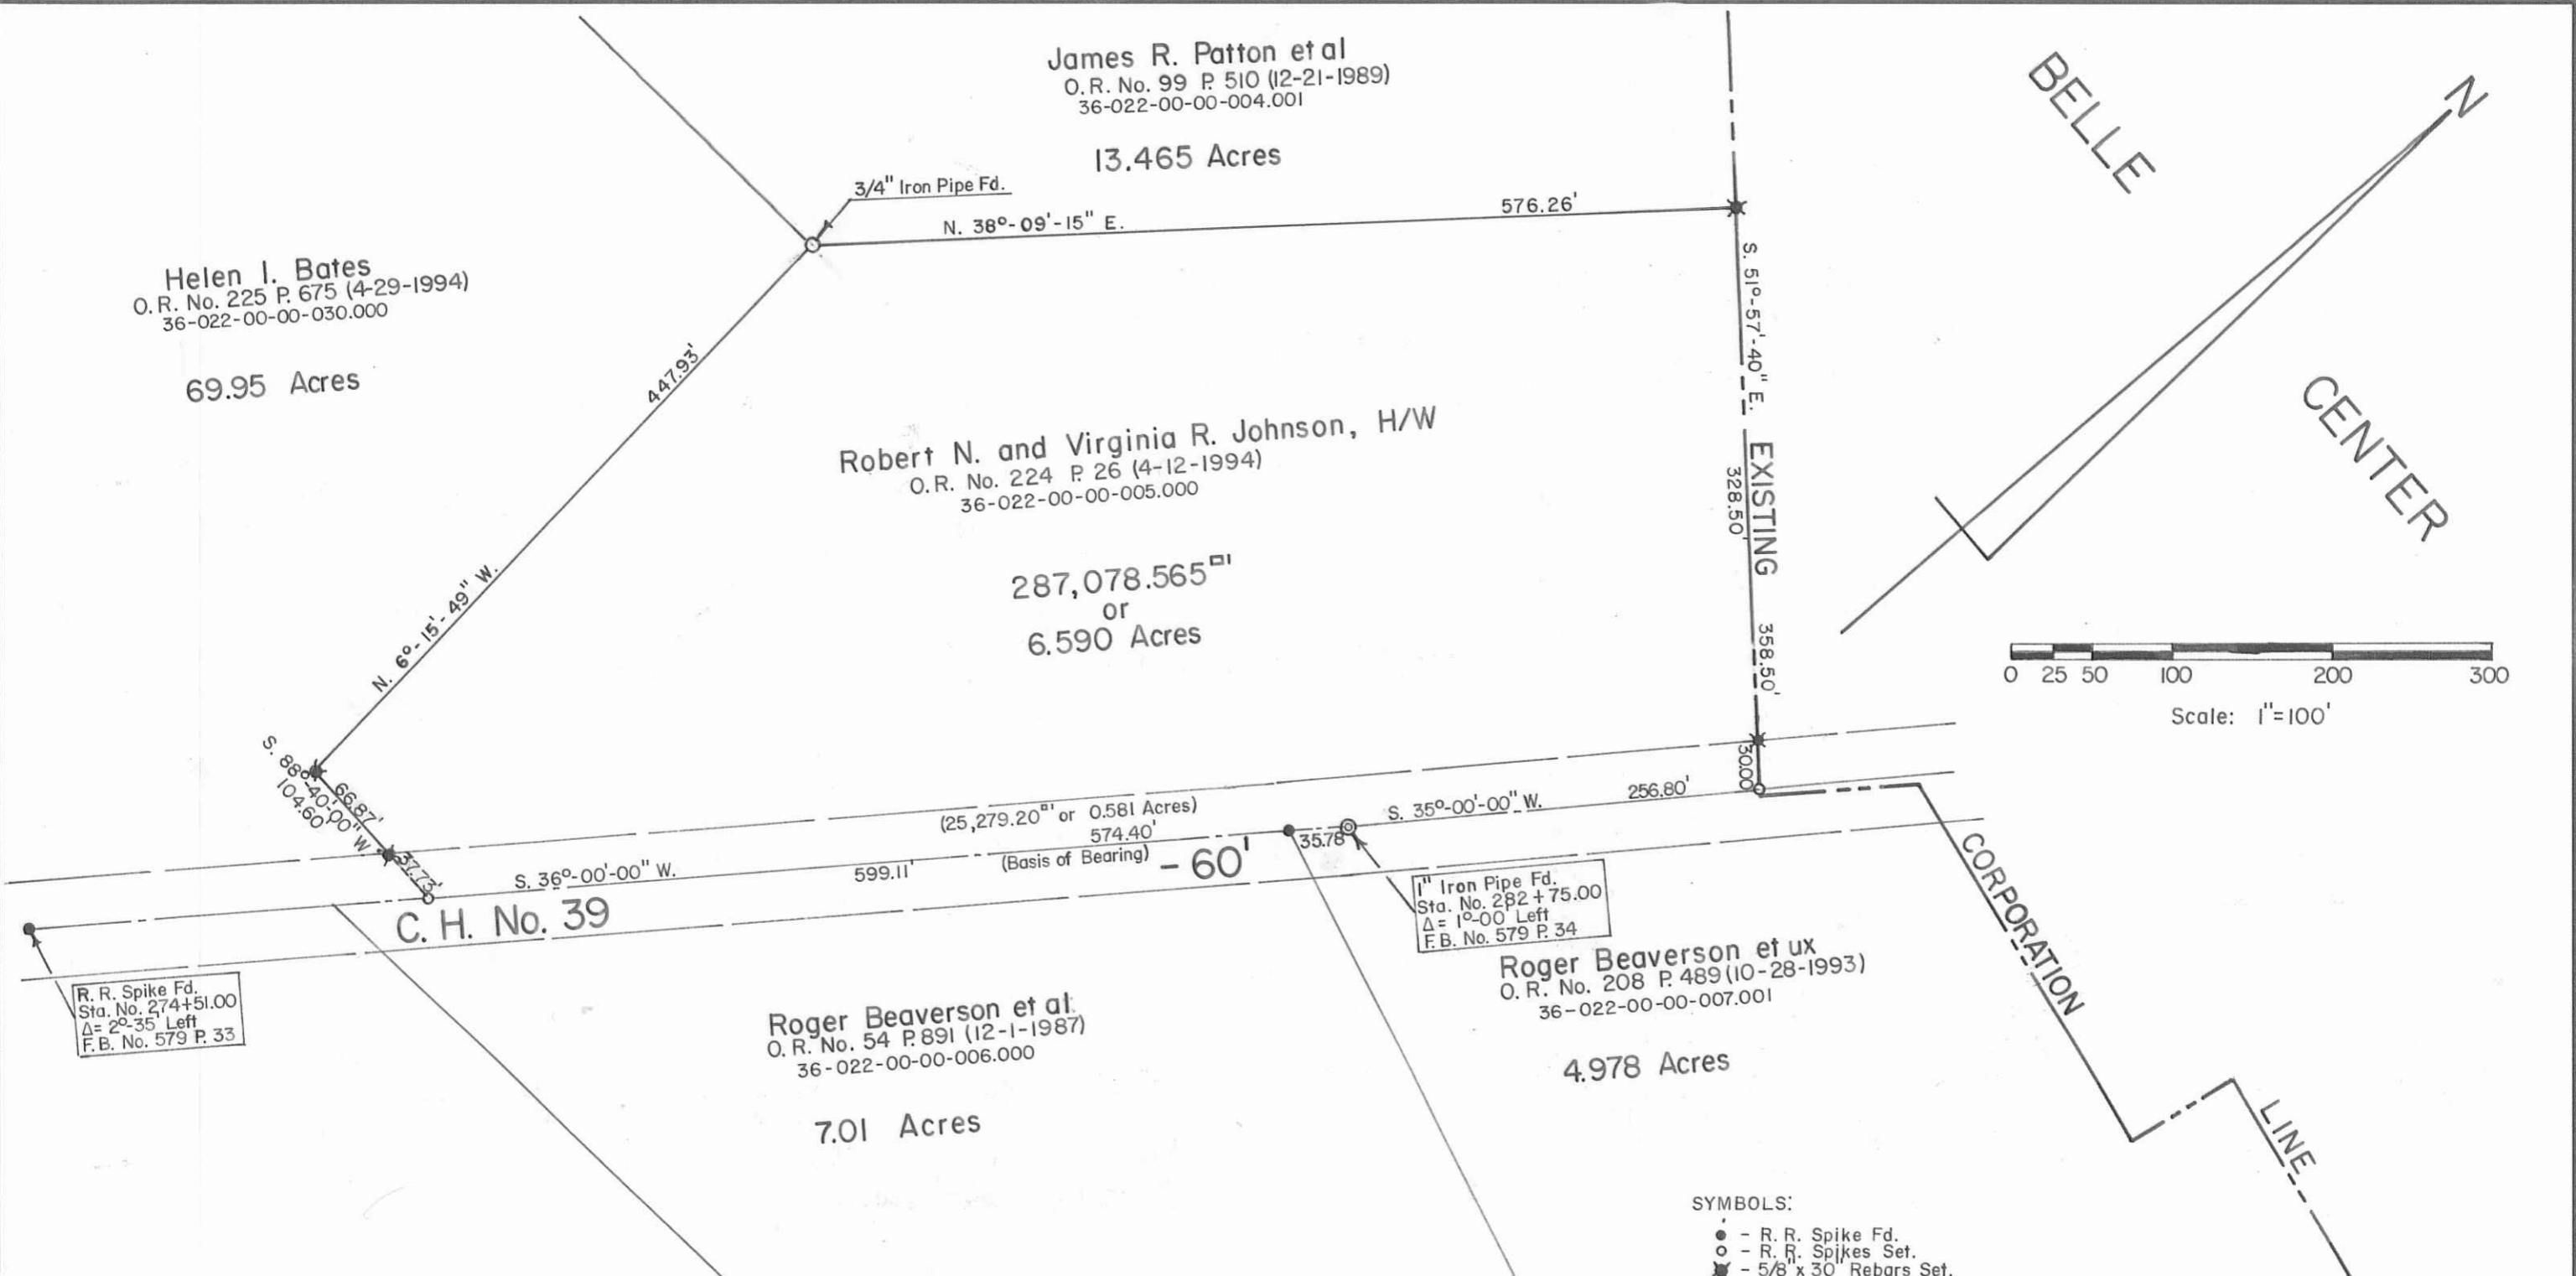

R. R. Spike Fd.
Sta. No. 274+51.00
Δ = 2°-35' Left
F.B. No. 579 P. 33

C. H. No. 39

1" Iron Pipe Fd.
Sta. No. 282+75.00
Δ = 1°-00' Left
F.B. No. 579 P. 34

- SYMBOLS:
- - R. R. Spike Fd.
 - - R. R. Spikes Set.
 - ✱ - 5/8" x 30" Rebars Set.



Resurvey of Robert N. Johnson's present 6.59 Acre Tract,
V. M. S. No. 9972, Richland Township,
Logan County, Ohio.

SCALE: 1" = 100'	APPROVED BY:	DRAWN BY DEG
DATE: 5-6-1995		REVISED

Daniel E. Gilbert
Daniel E. Gilbert, P. S.
Reg. Sur. No. 5402

DRAWING NUMBER
095-014A

INDEXED ON MAP
4092

S-811