


10837 16070
13593 10387
14530 10388

SCALE 10 CHAINS TO THE INCH

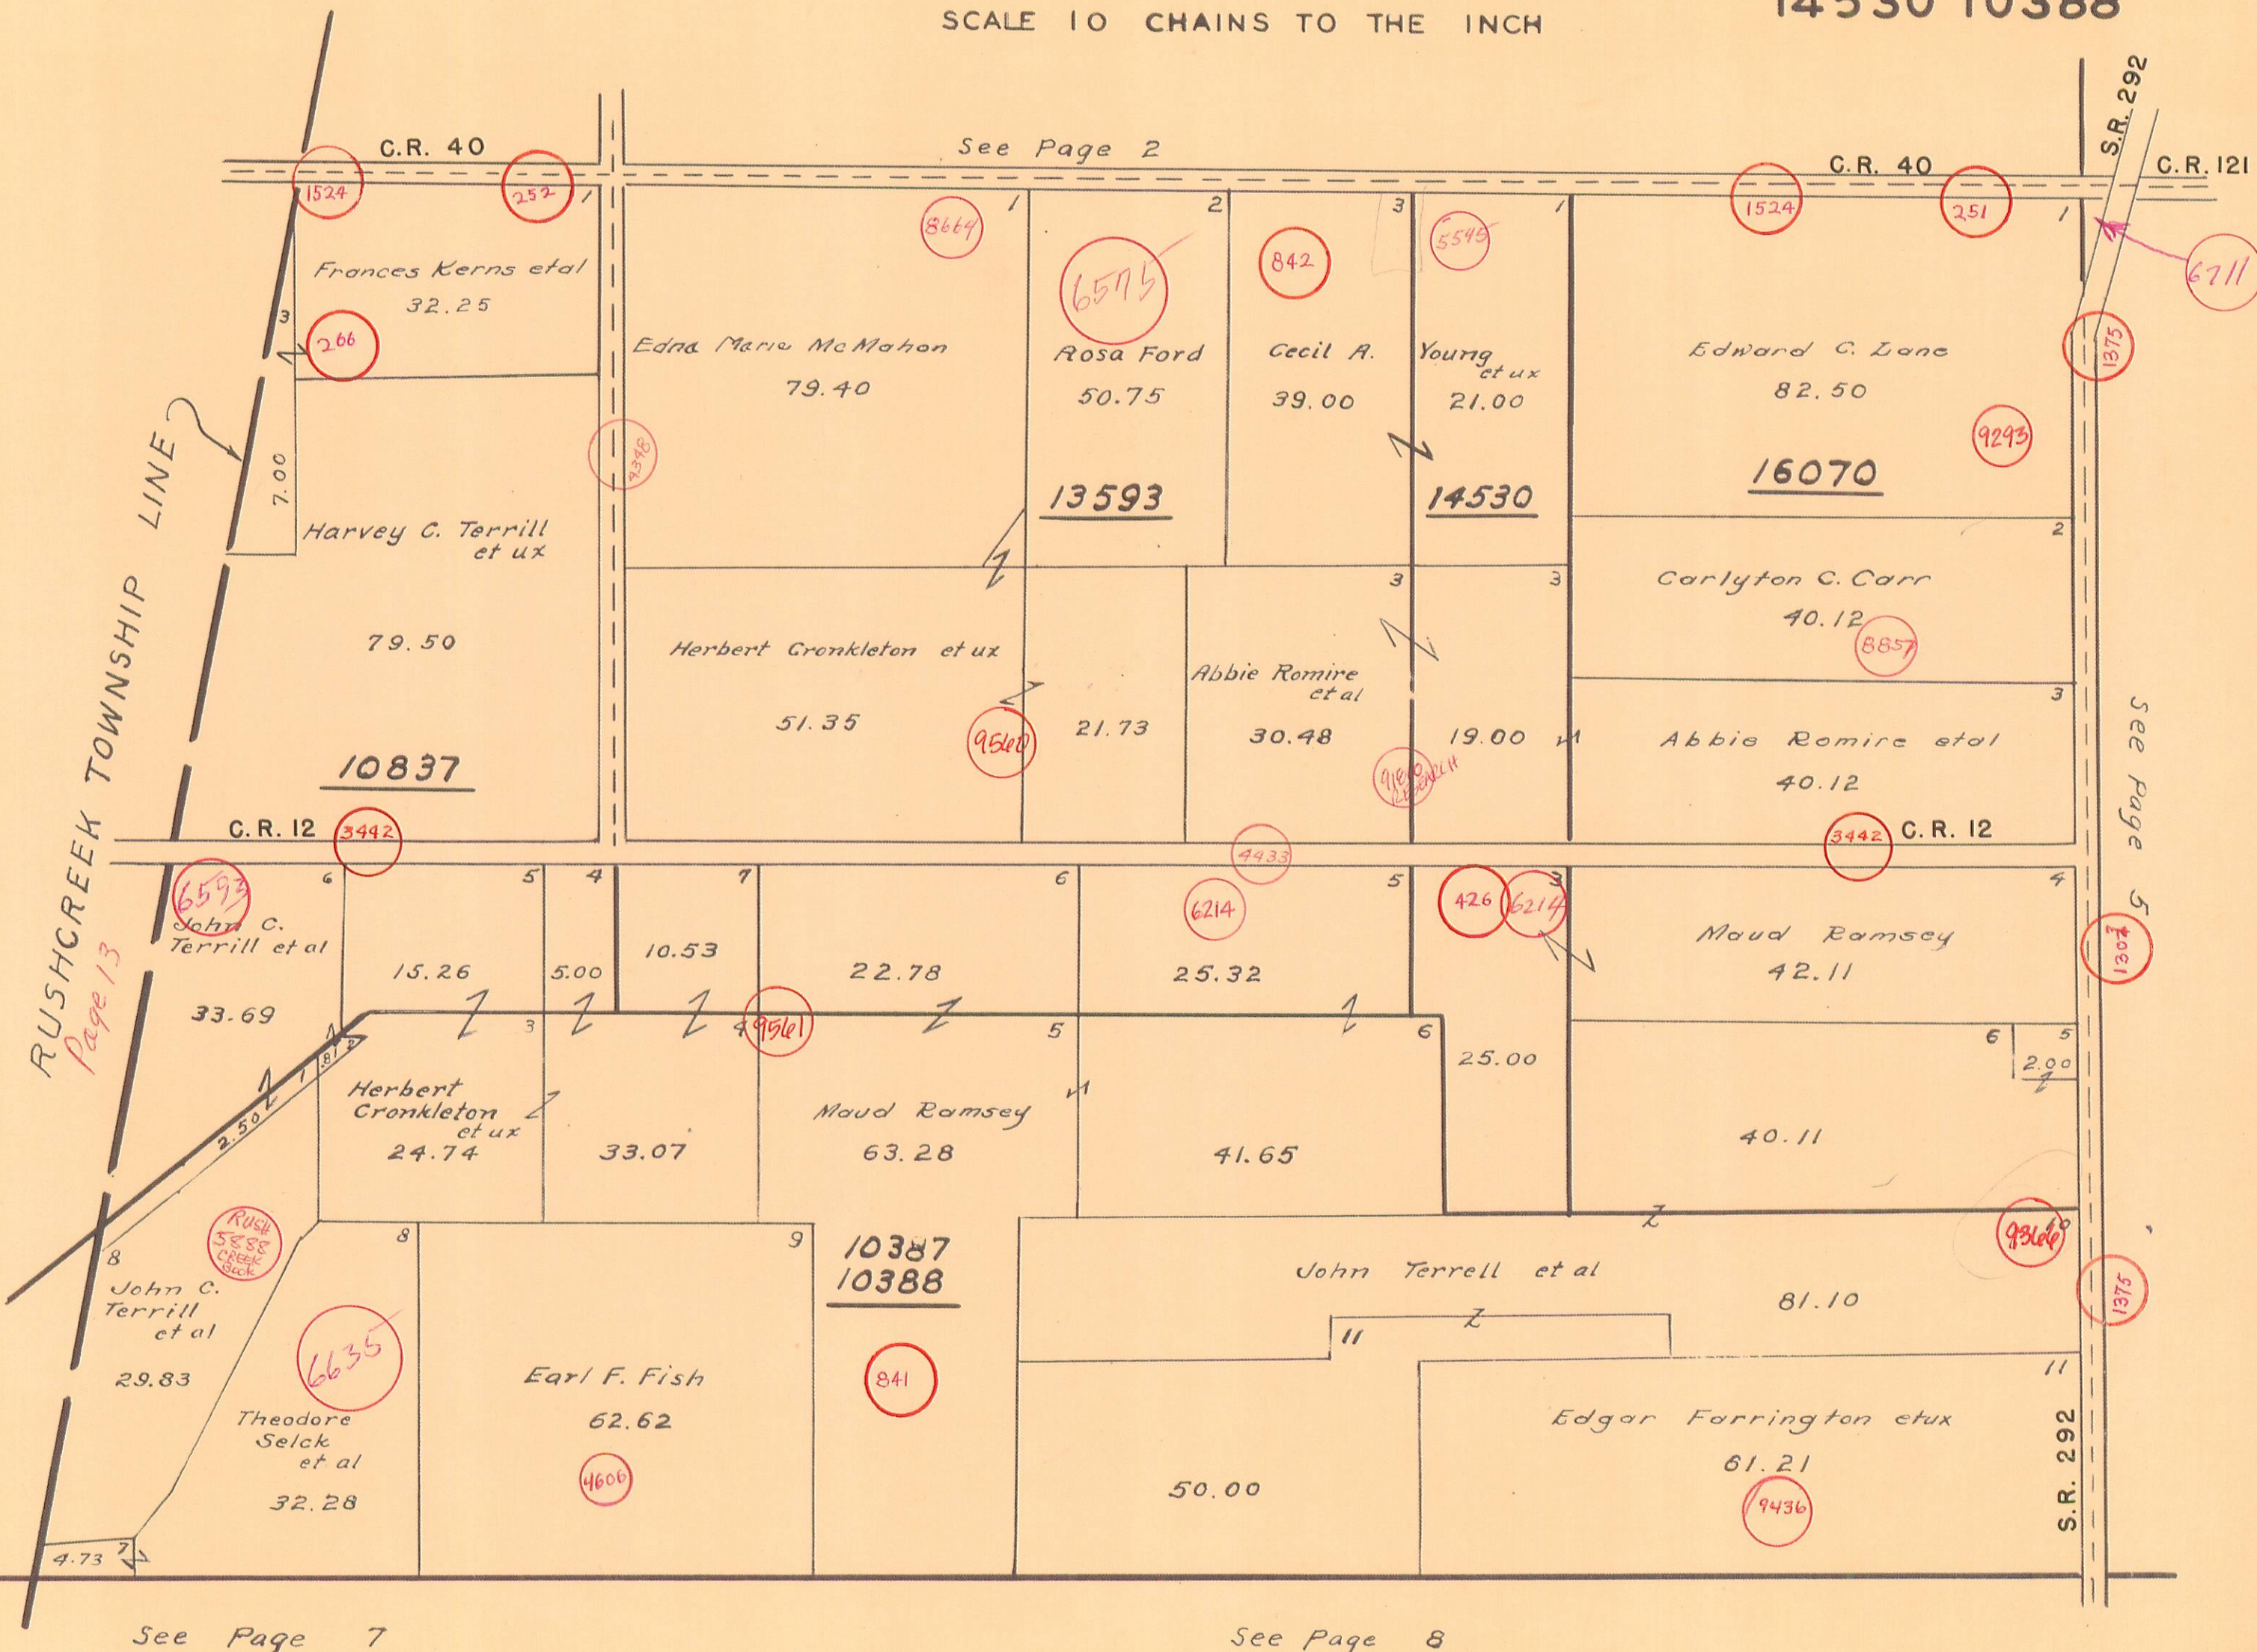

RUSHCREEK TOWNSHIP LINE
Page 13

See Page 7

See Page 8