


VIRGINIA MILITARY SURVEY 9915

SCALE 10 CHAINS TO THE INCH

See Page 10

C. R. 48

T. R. 138

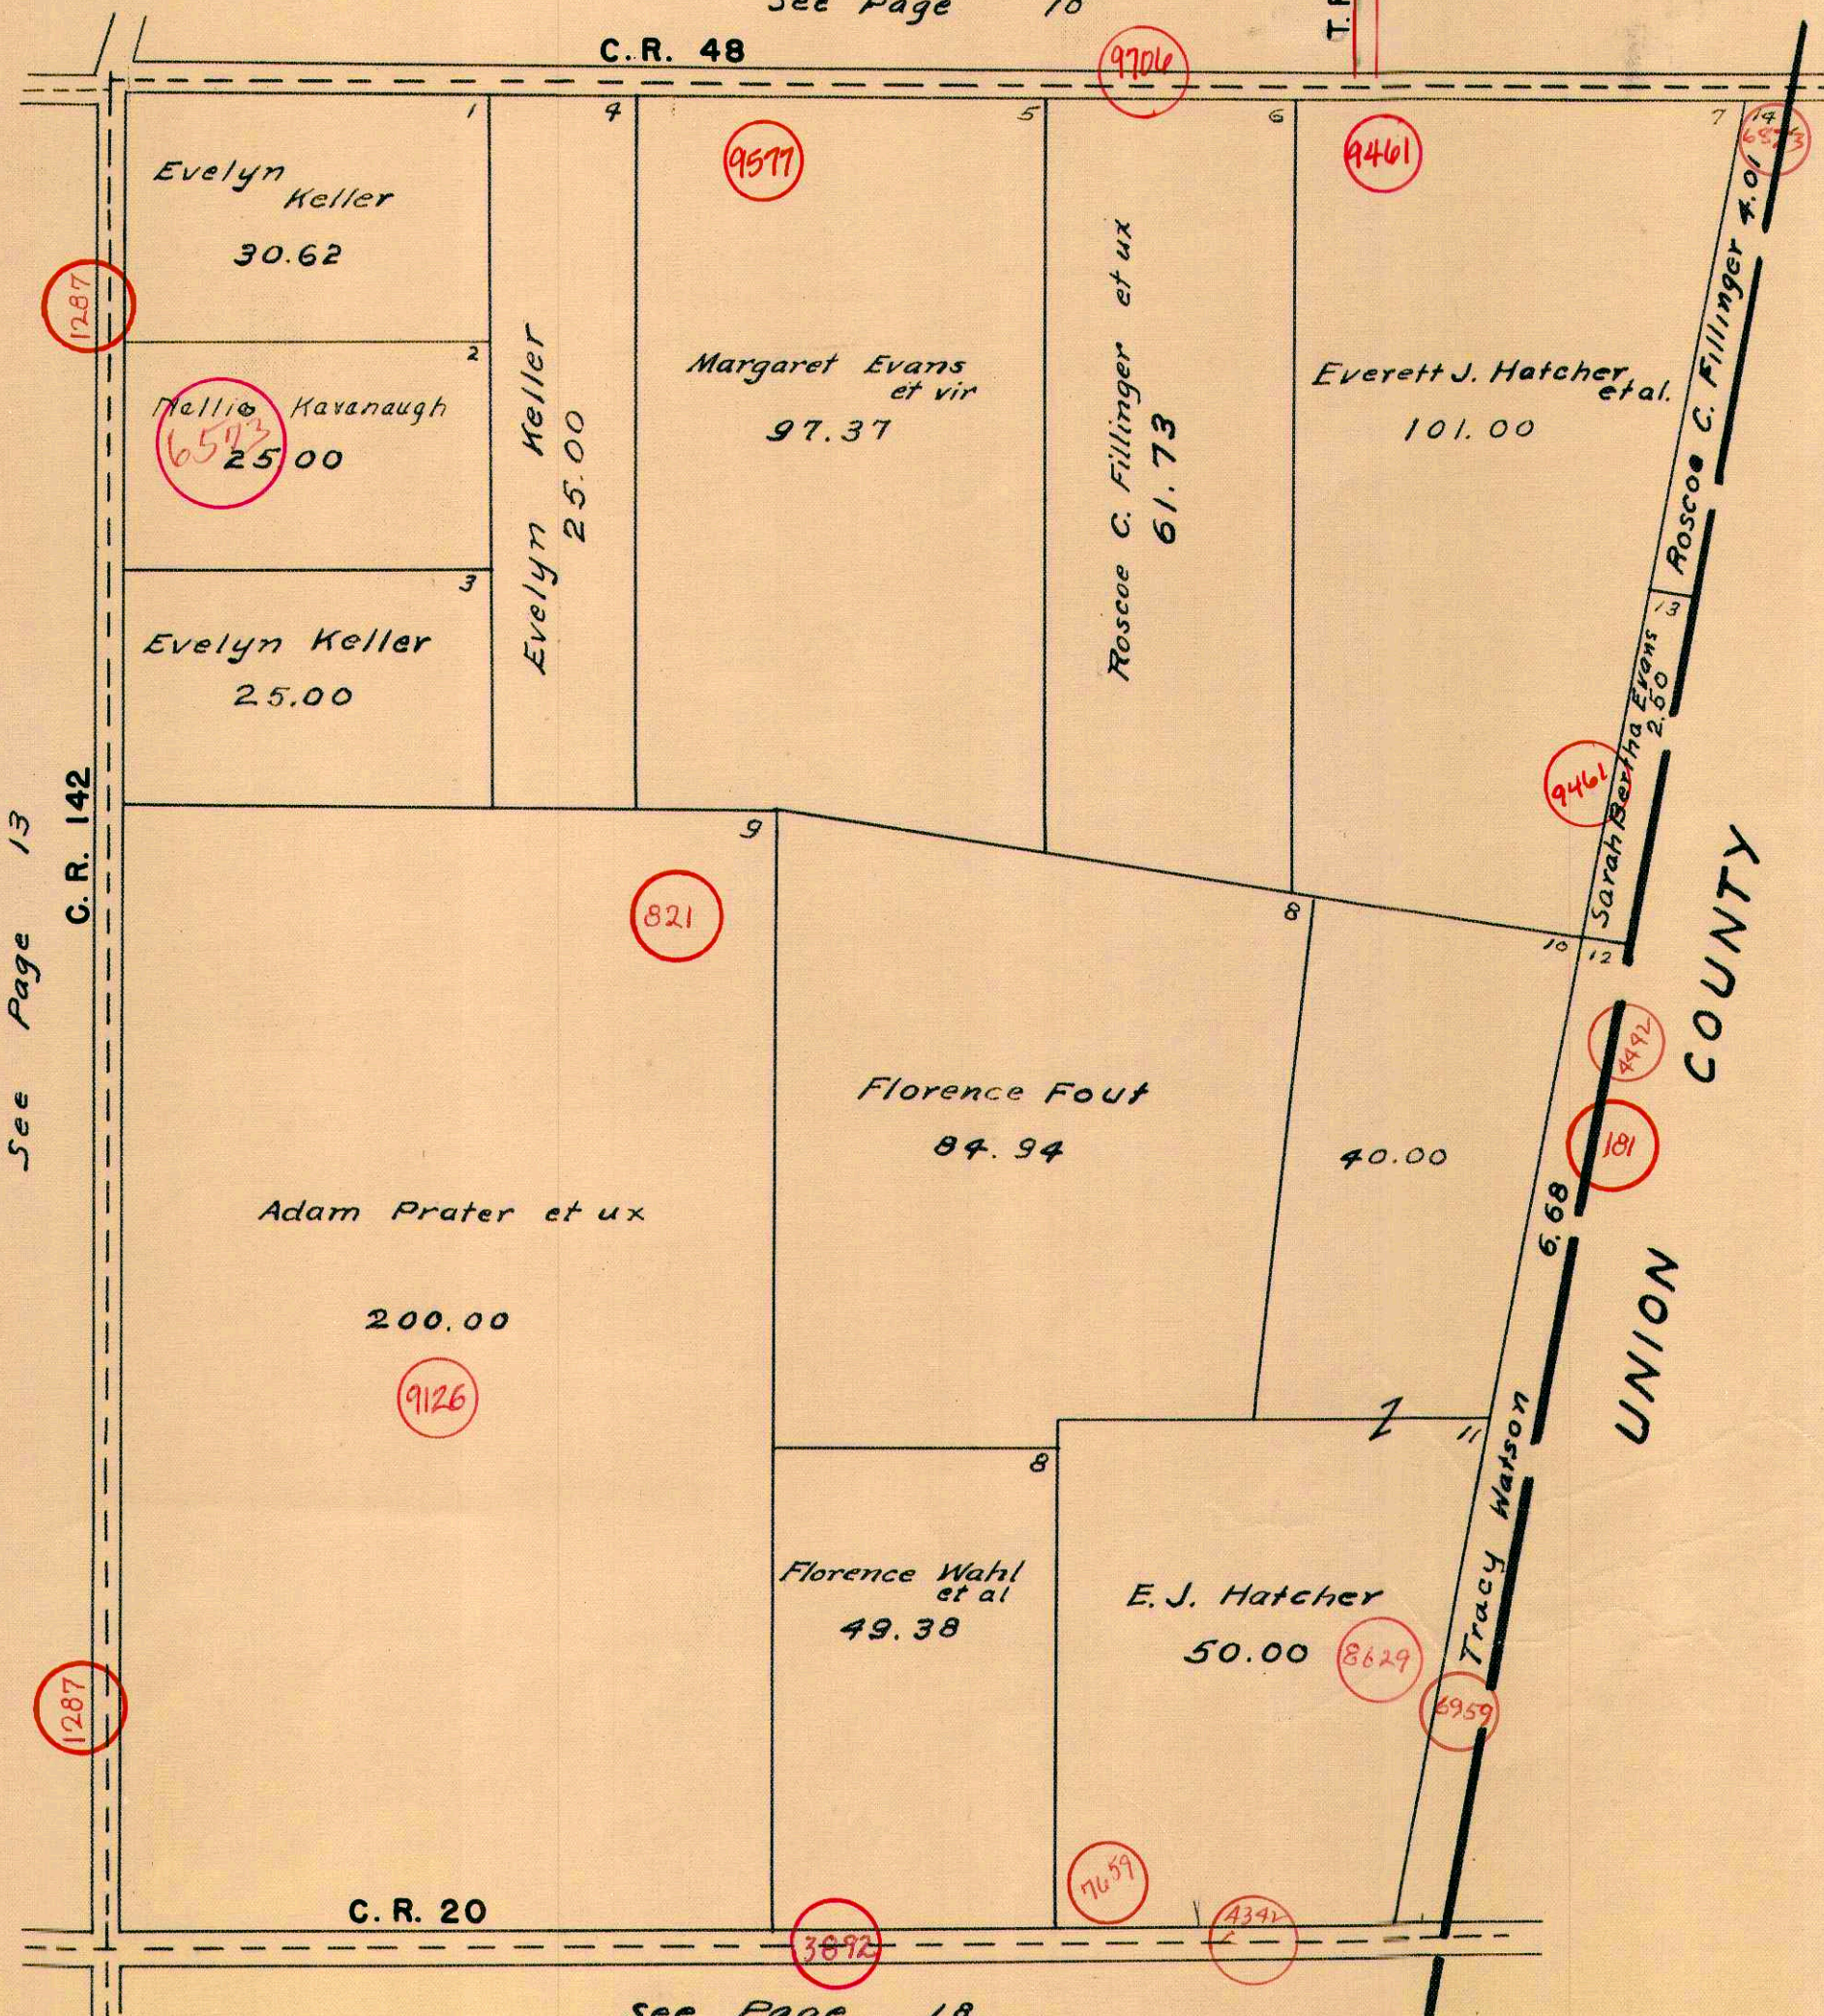

See Page 13

See Page 18