BOKESCREEK TOWNSHIP

VIRGINIA MILITARY SURVEY 9891

SCALE 10 CHAINS TO THE INCH

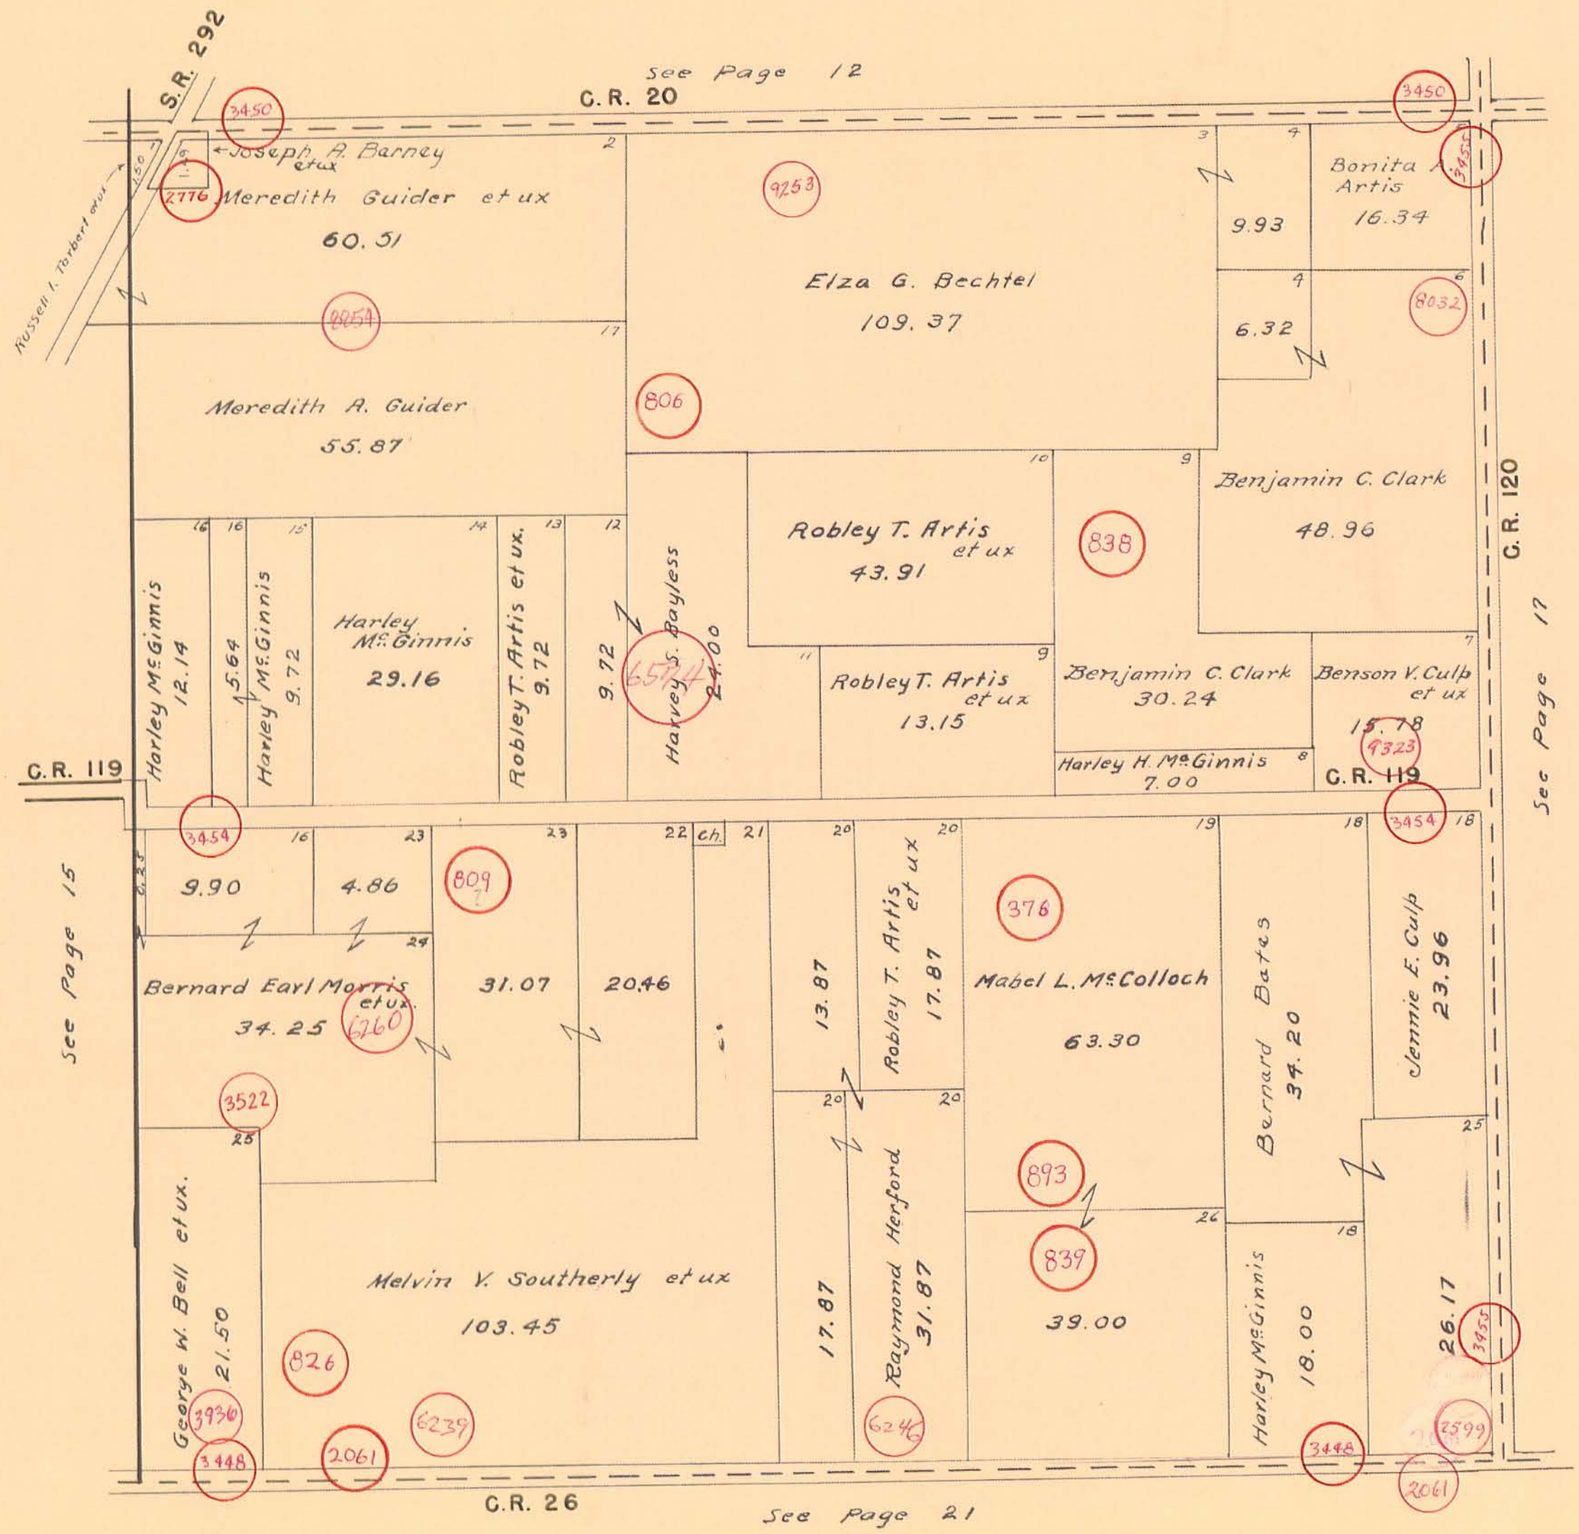

G. W. Wilgus