


HUNTSVILLE CORPORATION NORTH PART

SCALE 200 FEET TO THE INCH

VMS 9928

VMS 9904

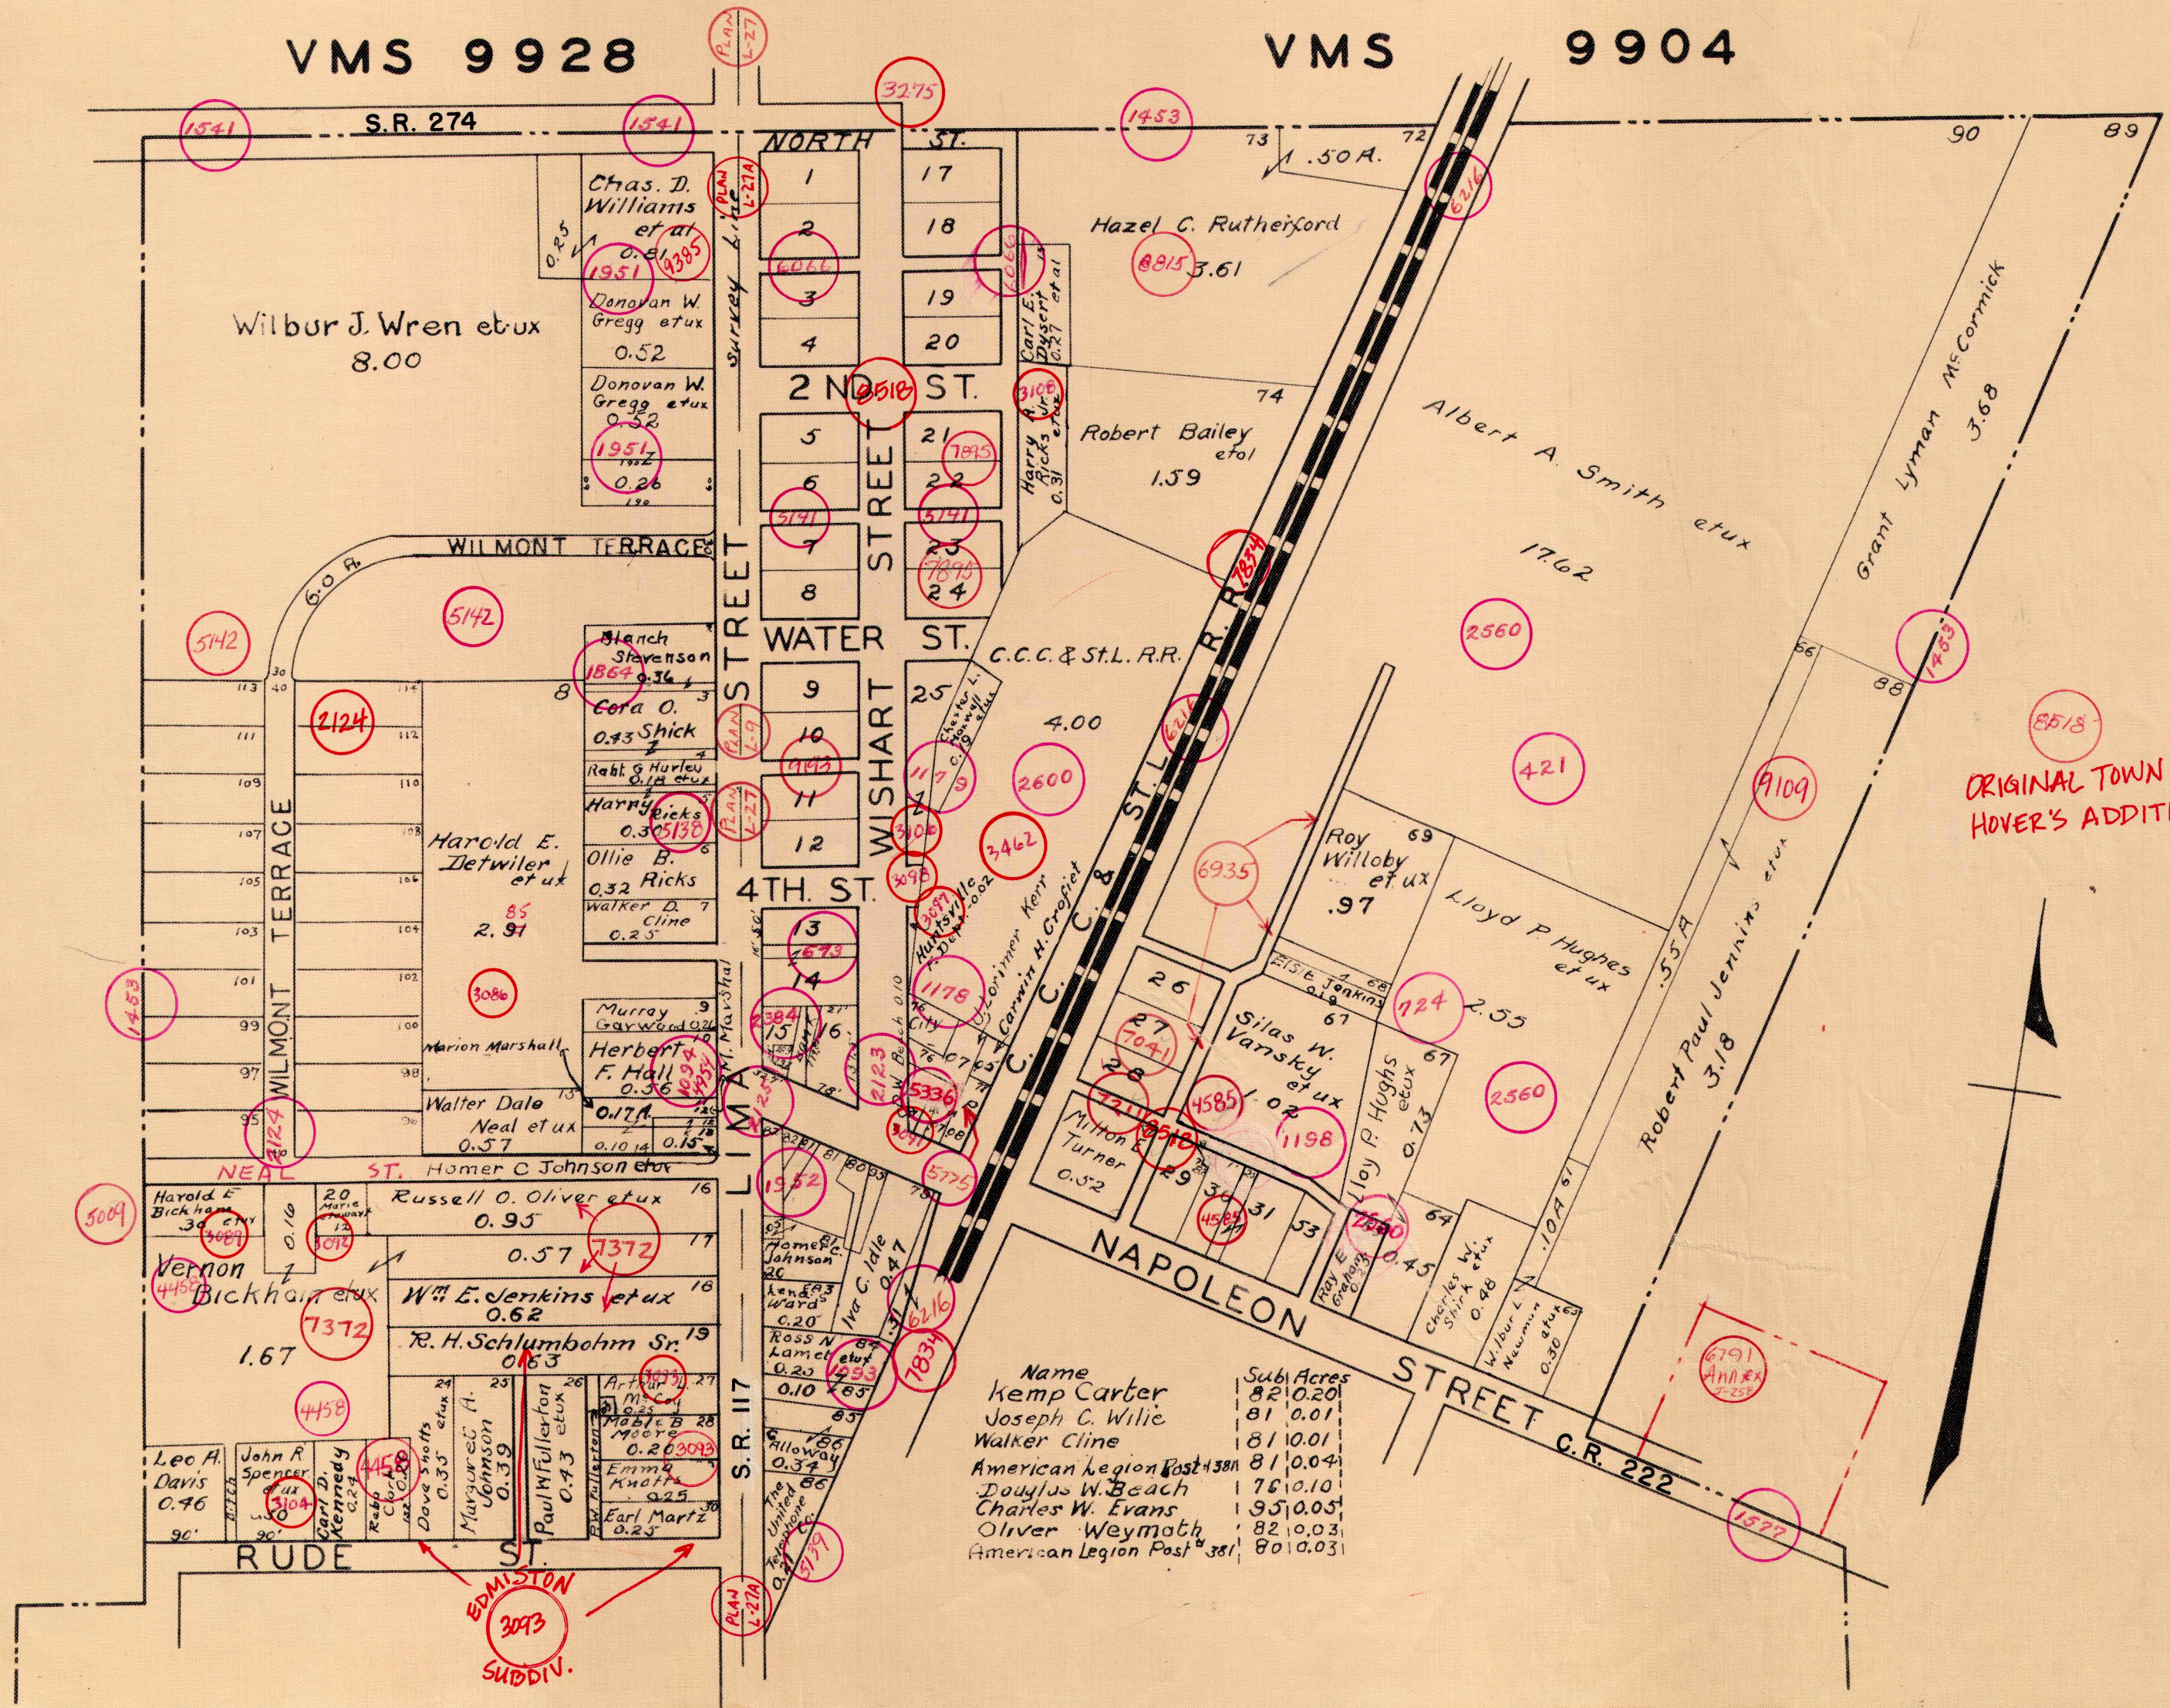

ORIGINAL TOWN PLAT HOVER'S ADDITION

H.E.D.

corrected 1-1-59 D.L.T.