


SCALE 10 CHAINS TO THE INCH

See Page 5

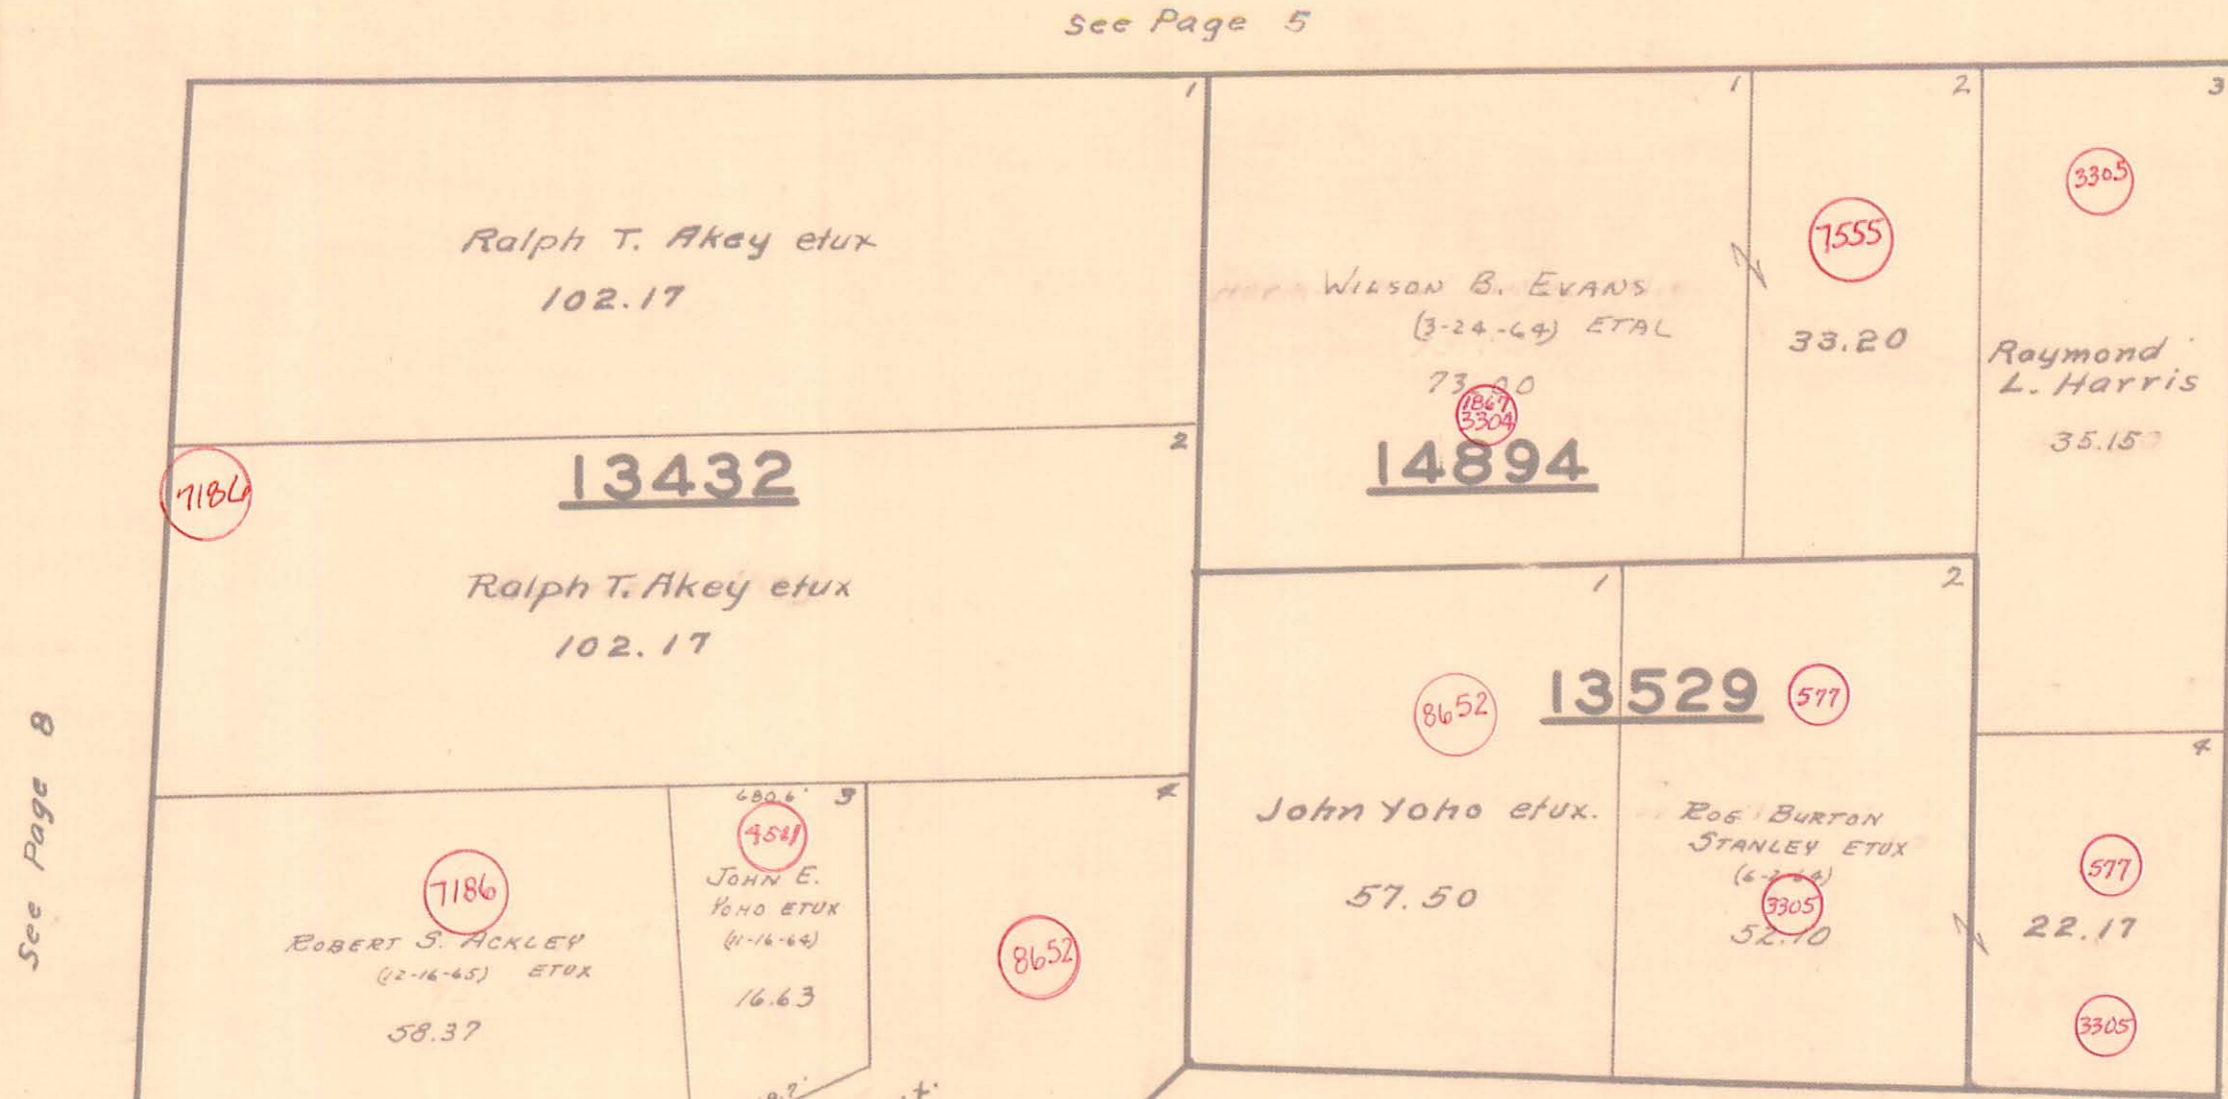

See Page 10

See Page 8

See Page 10

