



NORTH WEST PART EAST LIBERTY

SCALE 200 FEET TO THE INCH

NOTE B: Alley vacation (Res. No. 300-10)
OR 1310 pg. 958
SEE R-5381

NOTE C: Alley vacation (Res. No. 00-22)
OR 1404 pg. 1251 (SEE R-5381)

NOTE D: Alley vacation (Res. No. 159-22)
OR 1407 pg. 4979 (SEE R-5381)

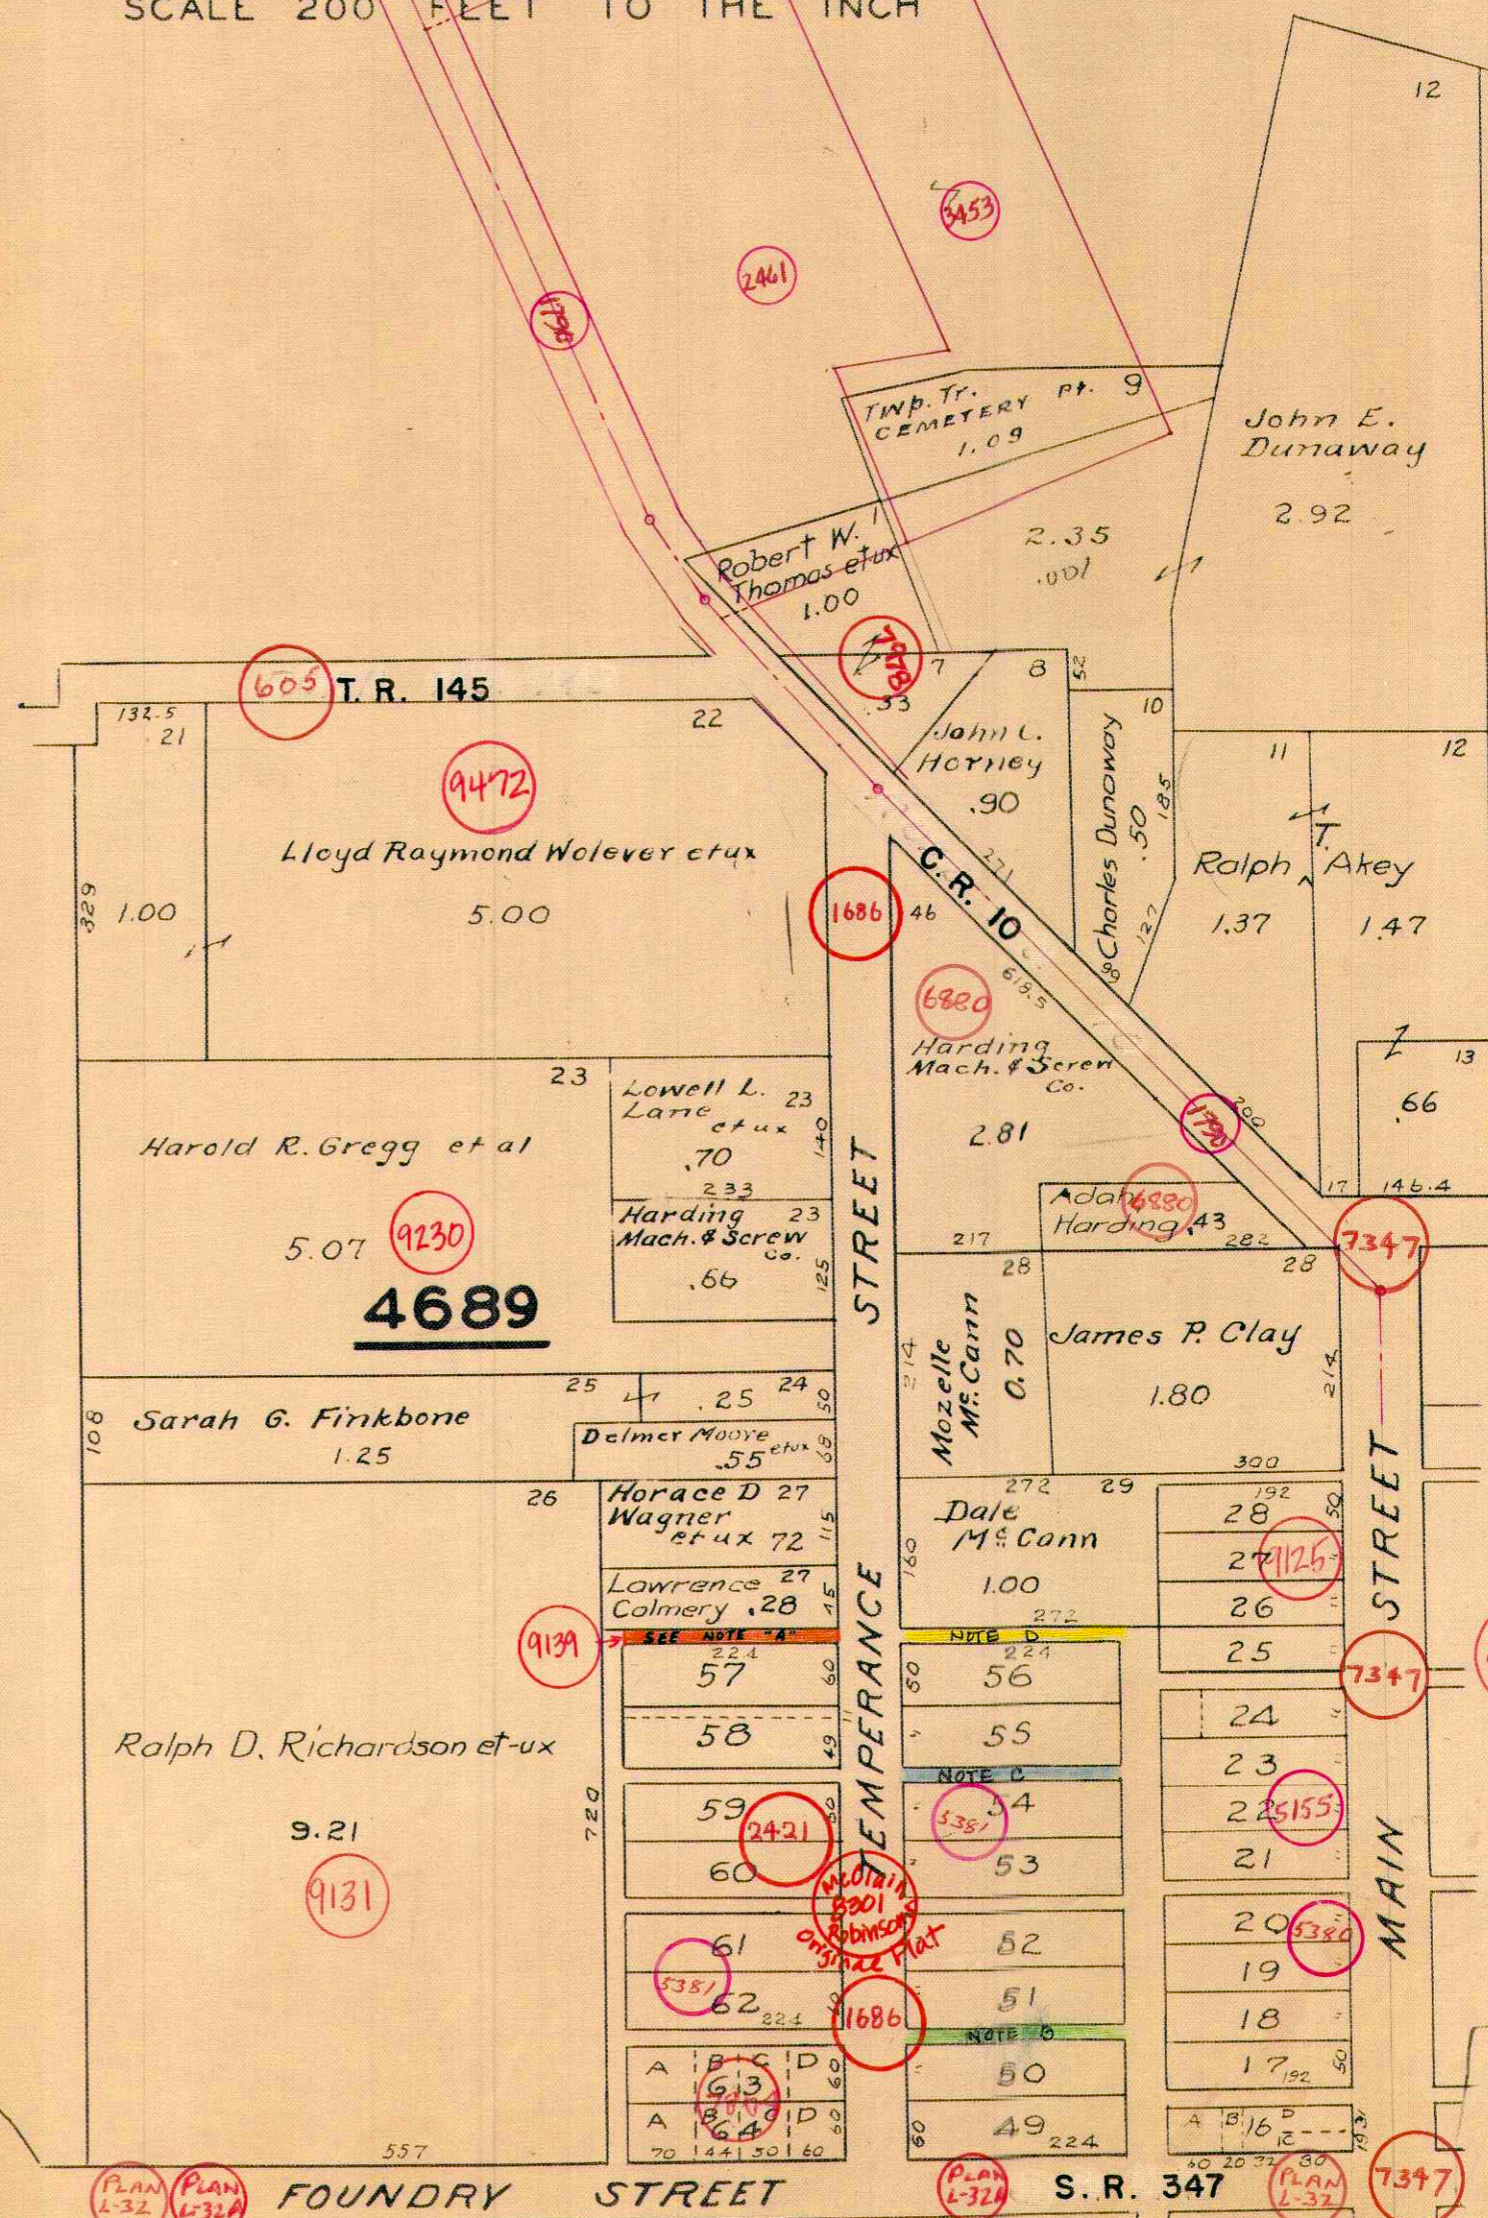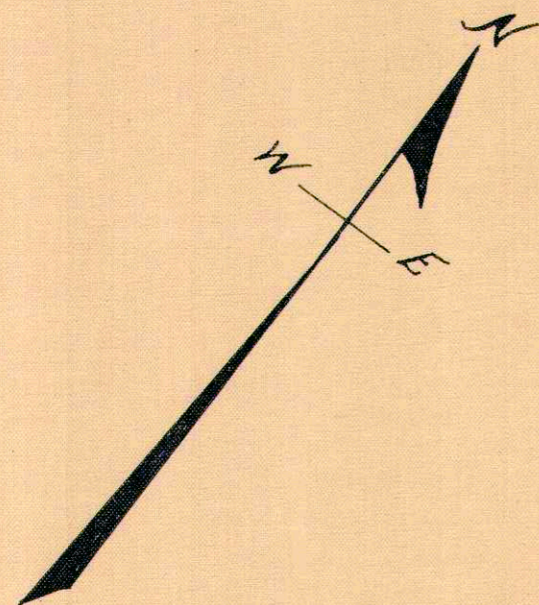

See Page 26

See Page 28

PLAN L-24

PLAN L-23

PLAN L-32

PLAN L-32A

PLAN L-32A

PLAN L-32

S. R. 347