


SCALE 10 CHAINS TO THE INCH

See Page 9  
C.R. 96

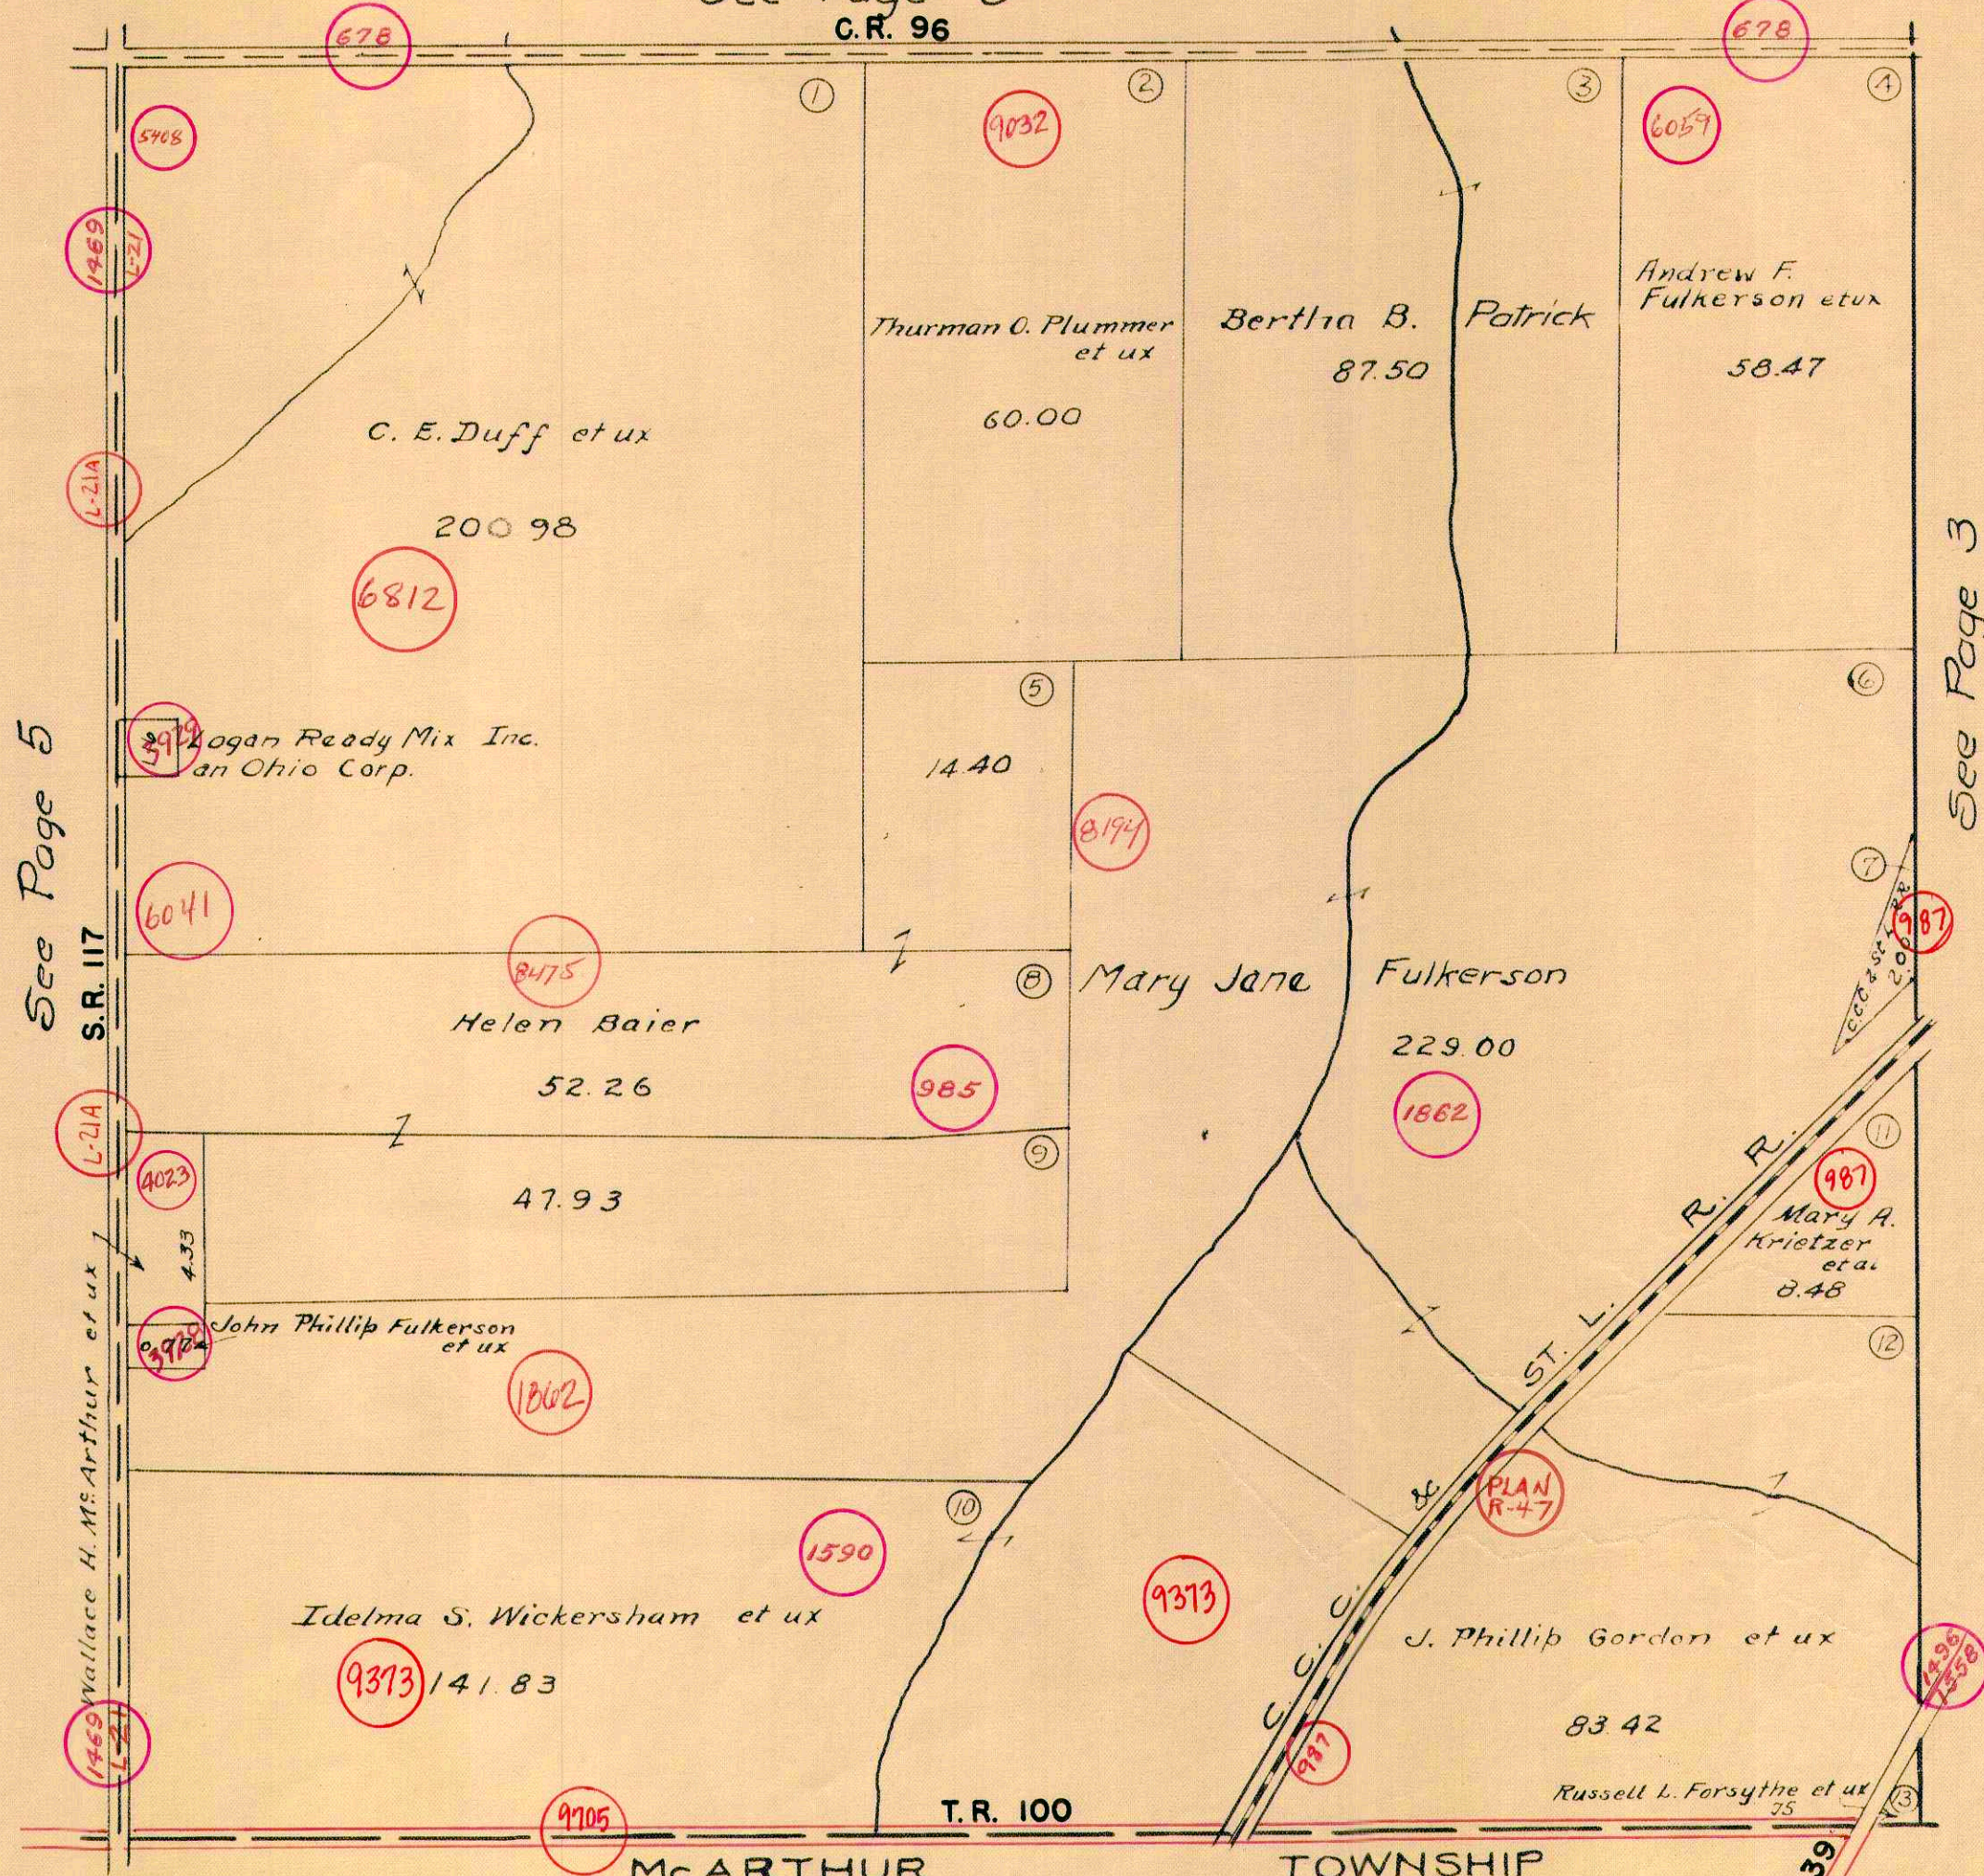

See Page 5

See Page 3