RICHLAND TOWNSHIP

VIRGINIA MILITARY SURVEYS

14032
10502
13079

SCALE 10 CHAINS TO THE INCH

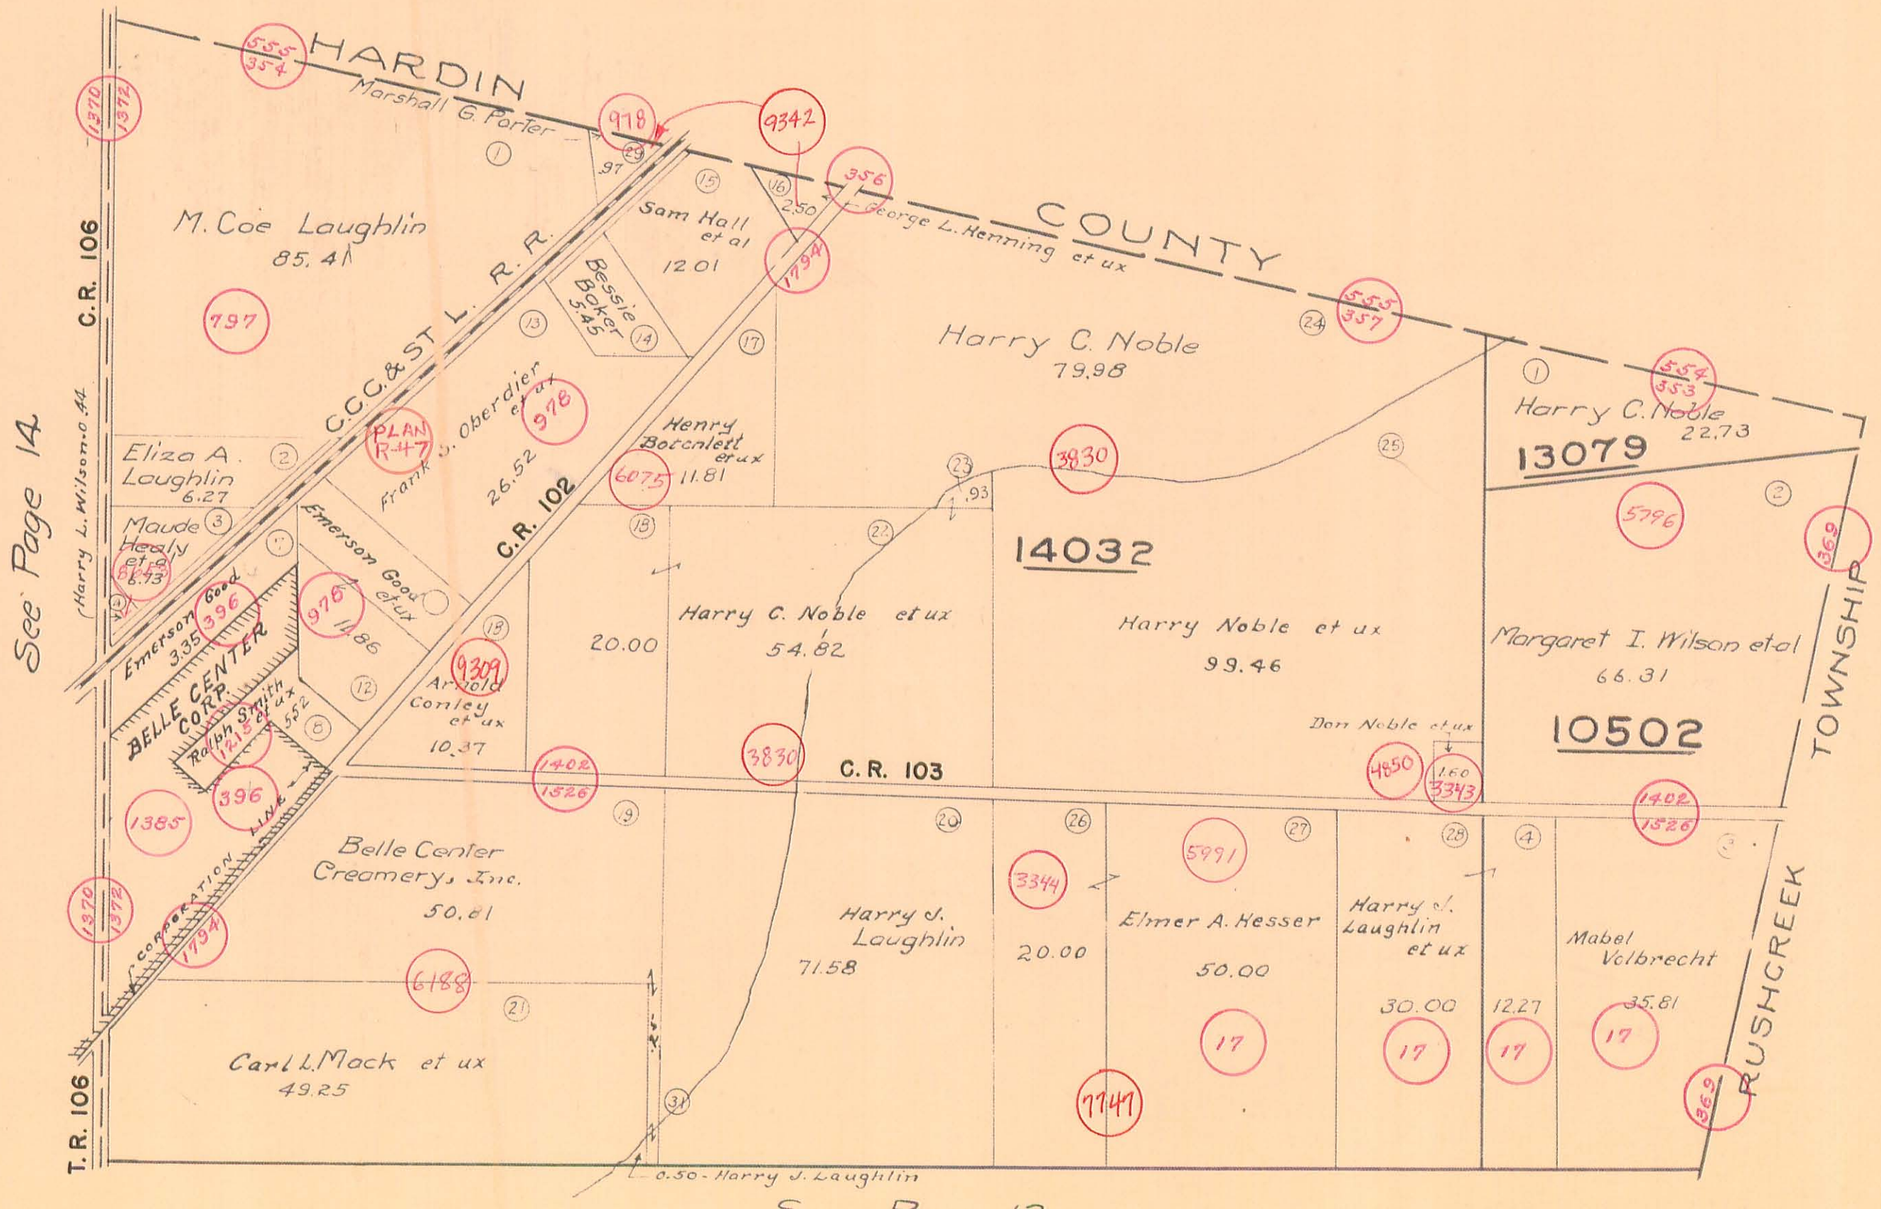

See Page 14

See Page 12

H.S.D.