


SCALE
10 CHAINS TO THE INCH

VIRGINIA MILITARY SURVEYS
HARDIN COUNTY

12277
13393
N-PART

TOWNSHIP AND COUNTY
SURVEY

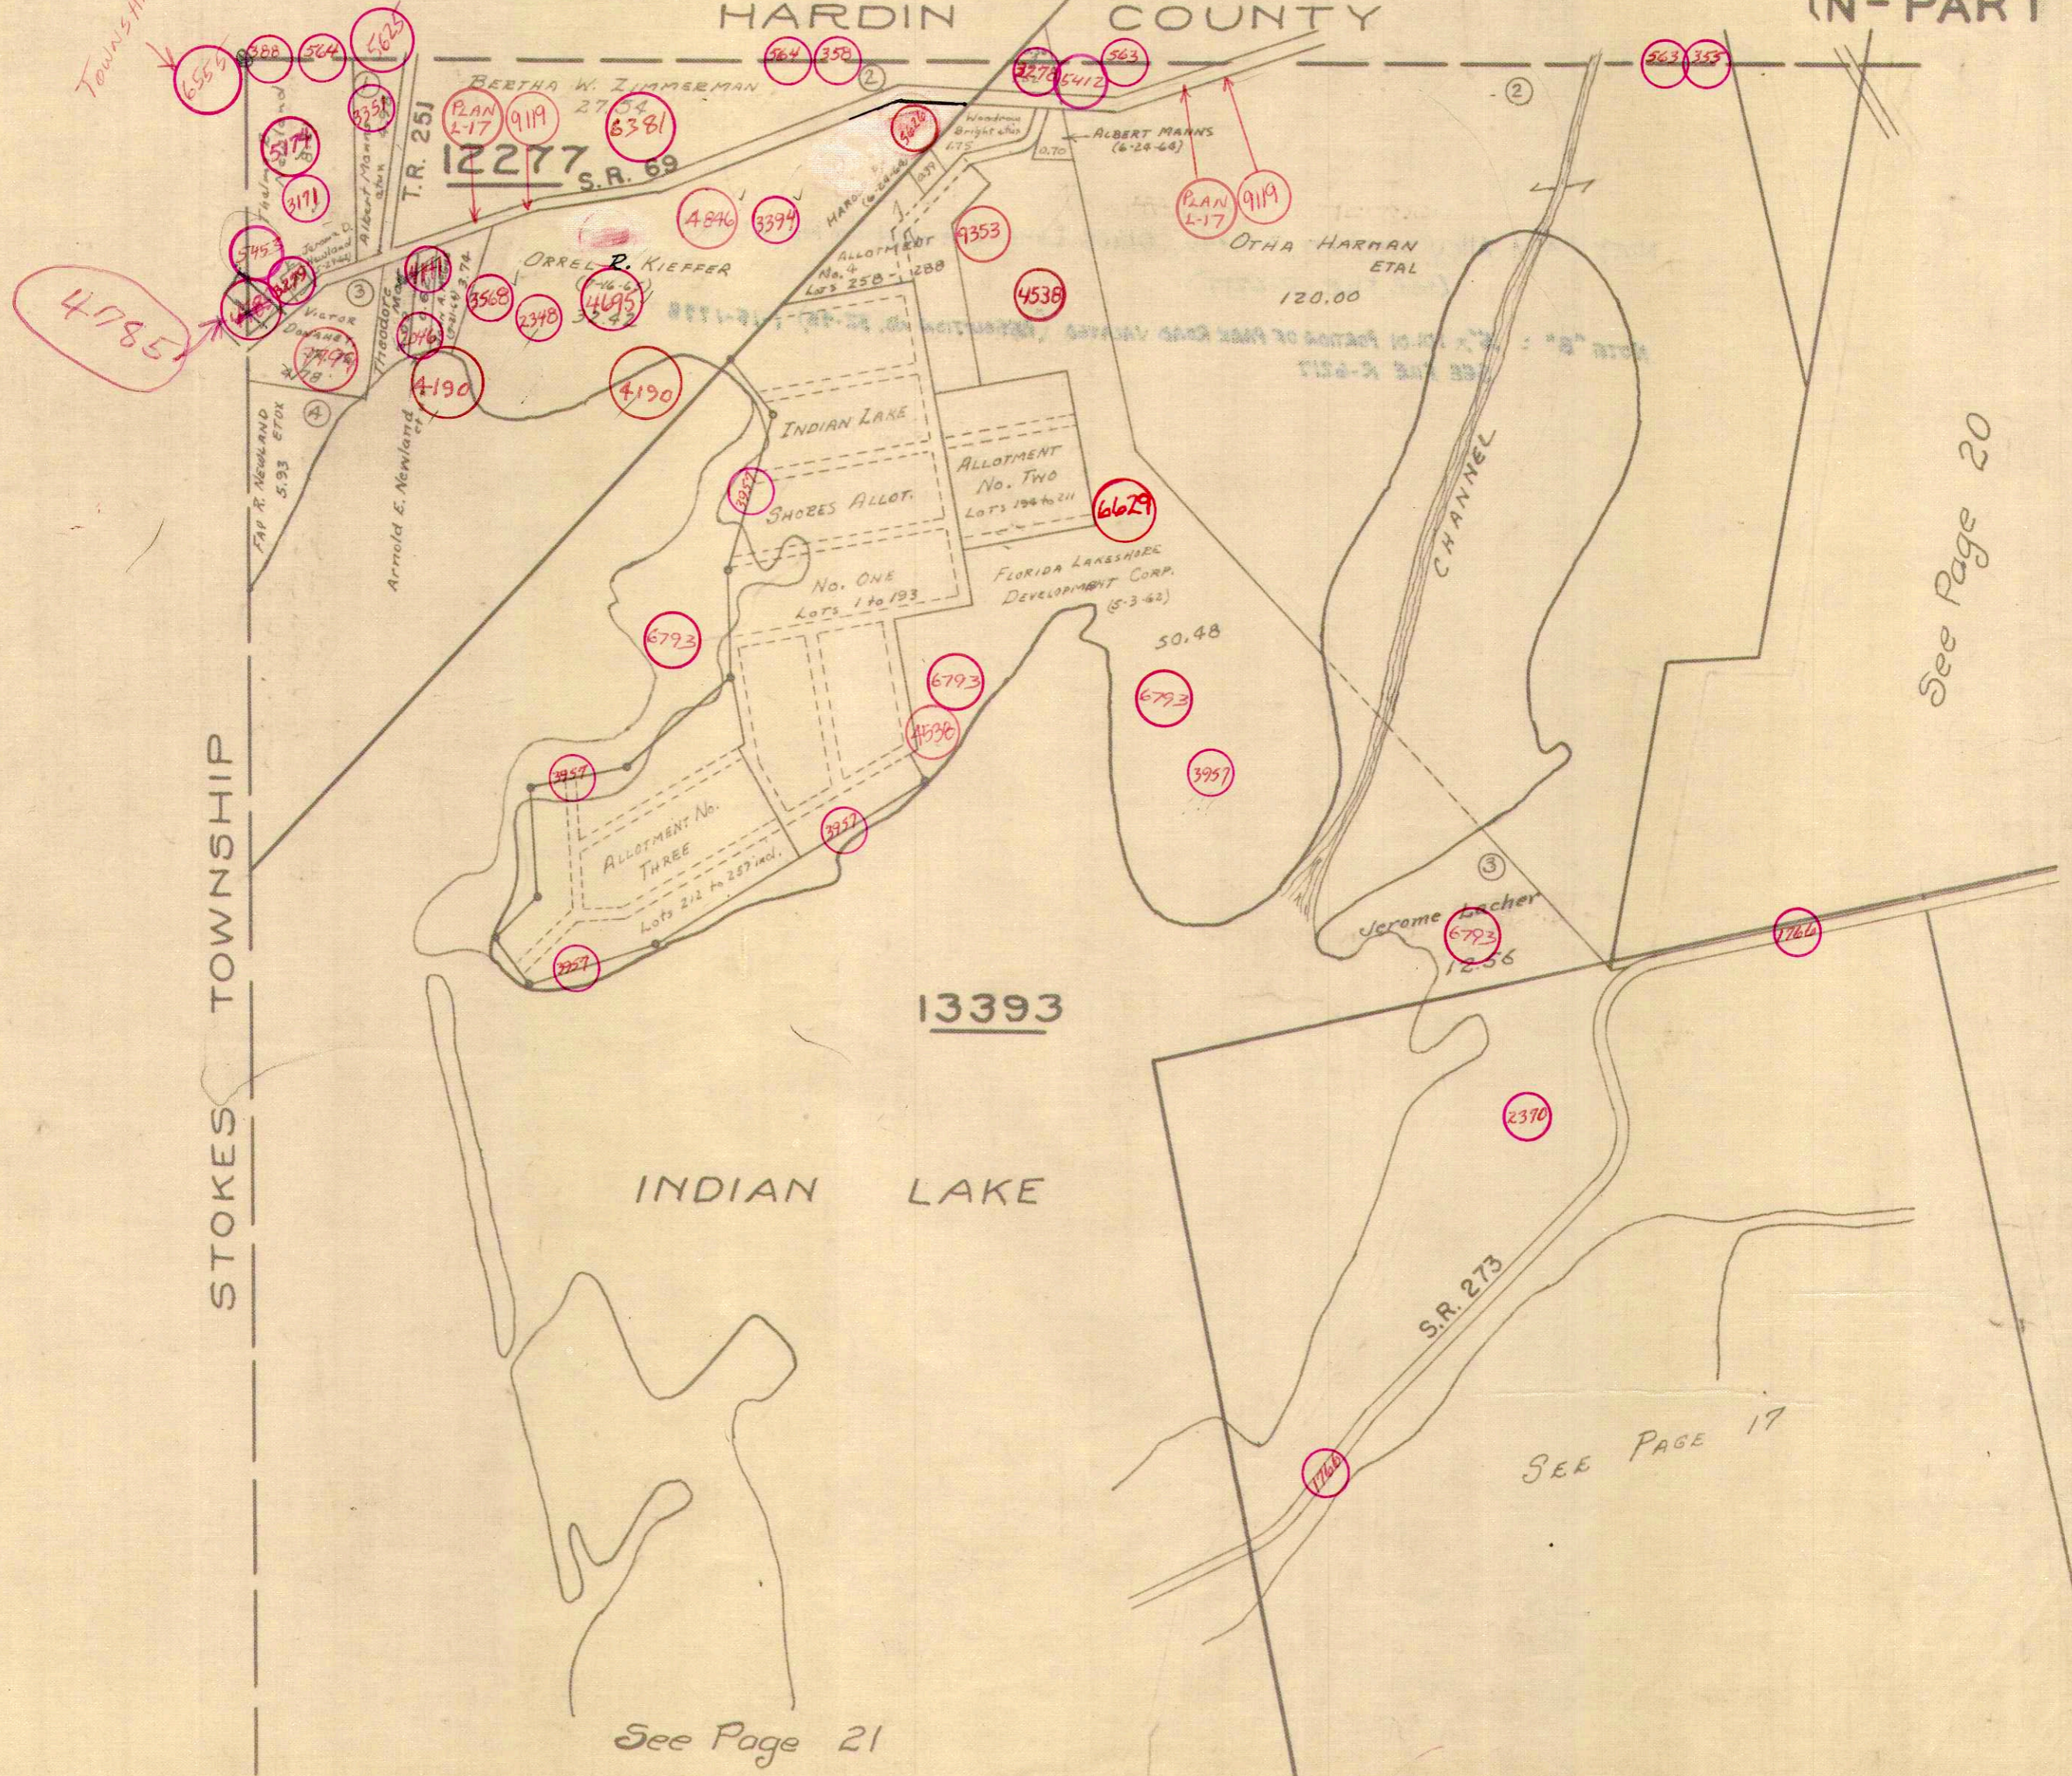

4785

See Page 20

STOKES TOWNSHIP

13393

INDIAN LAKE

Jerome Scher
12-56

2370

S.R. 273

SEE PAGE 17

See Page 21