RICHLAND TOWNSHIP

V. M. S. 13393

FERNWOOD SUBDIVISIONS - LONG ISLAND

SCALE: 1" = 100'

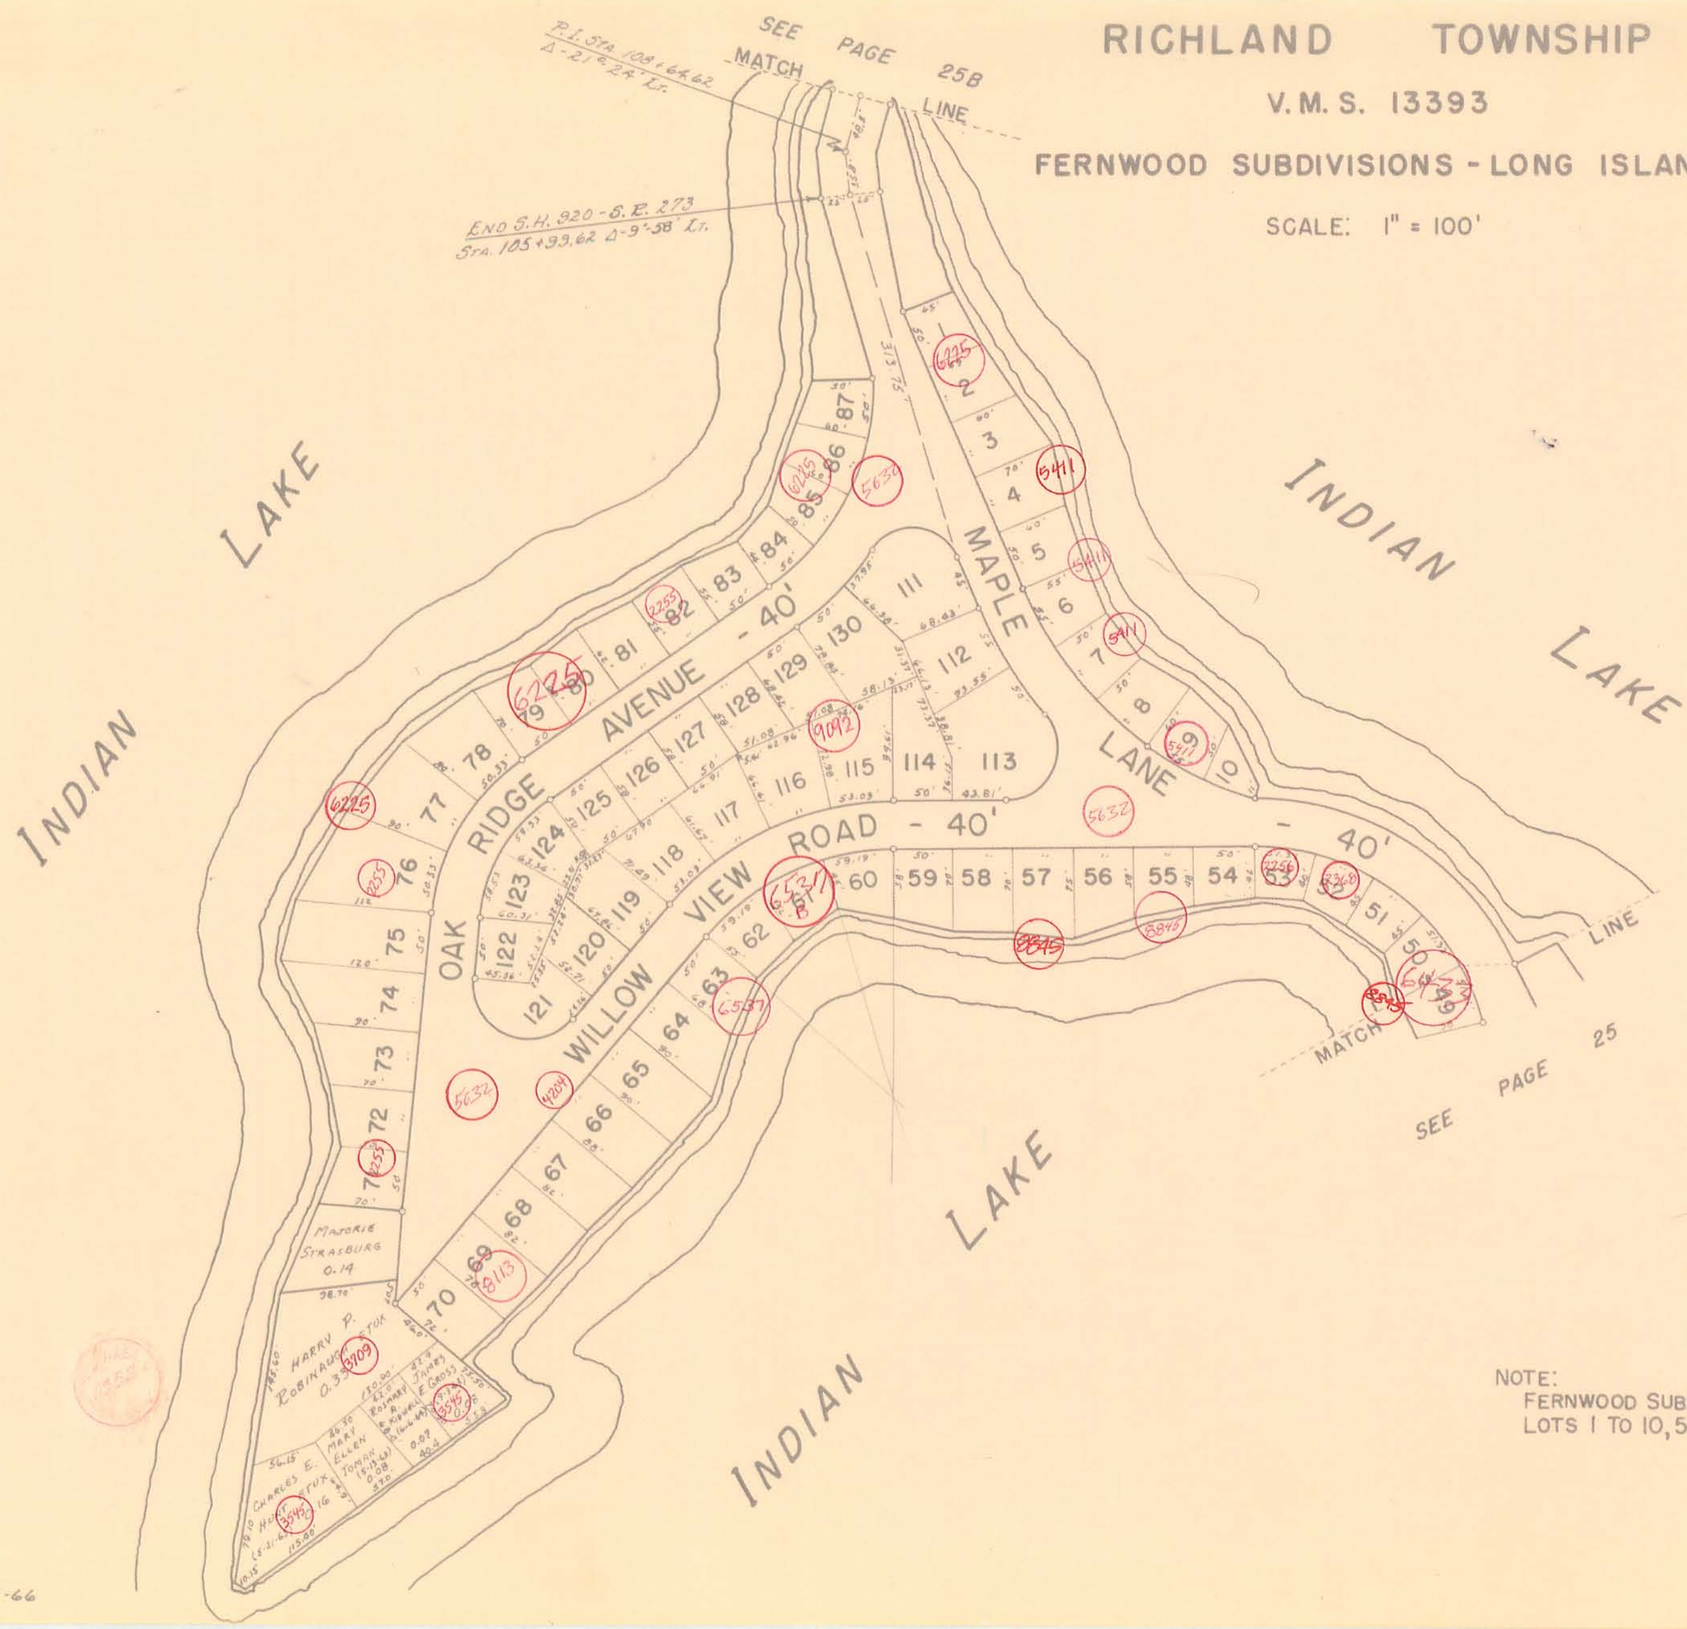

NOTE:
FERNWOOD SUBDIVISION NO. I.
LOTS 1 TO 10, 50 TO 87, 111 TO 130.

DRAWN 1-4-66
D.E.G.