


Note "B" Alley Vacation Resolution No. 412-92 (9-10-92) (R-3618)
 Note "C" Part of Street Vacated 7-8-94 (Resolution 281-94) (SEE FILE R-3618)
 Note "D" Alley Vacation on (Ordinance No) See R-9138

NOTES

"A" LOGAN COUNTY COMMON PLEAS COURT, RECORD BOOK "T" Pg. 56
 Shows that a vacation on lots in this area was ordered by the findings of this court action. Vacated was Lots 9 Thru 16 and Lots 22-29; Willow Street, North of Walnut Street; Railroad St adjacent to the above lots; all alleys adjacent to above lots except Benton Alley of Richland Addition, Plat Cabinet "A" Slide 155.

RICHLAND ADDITION

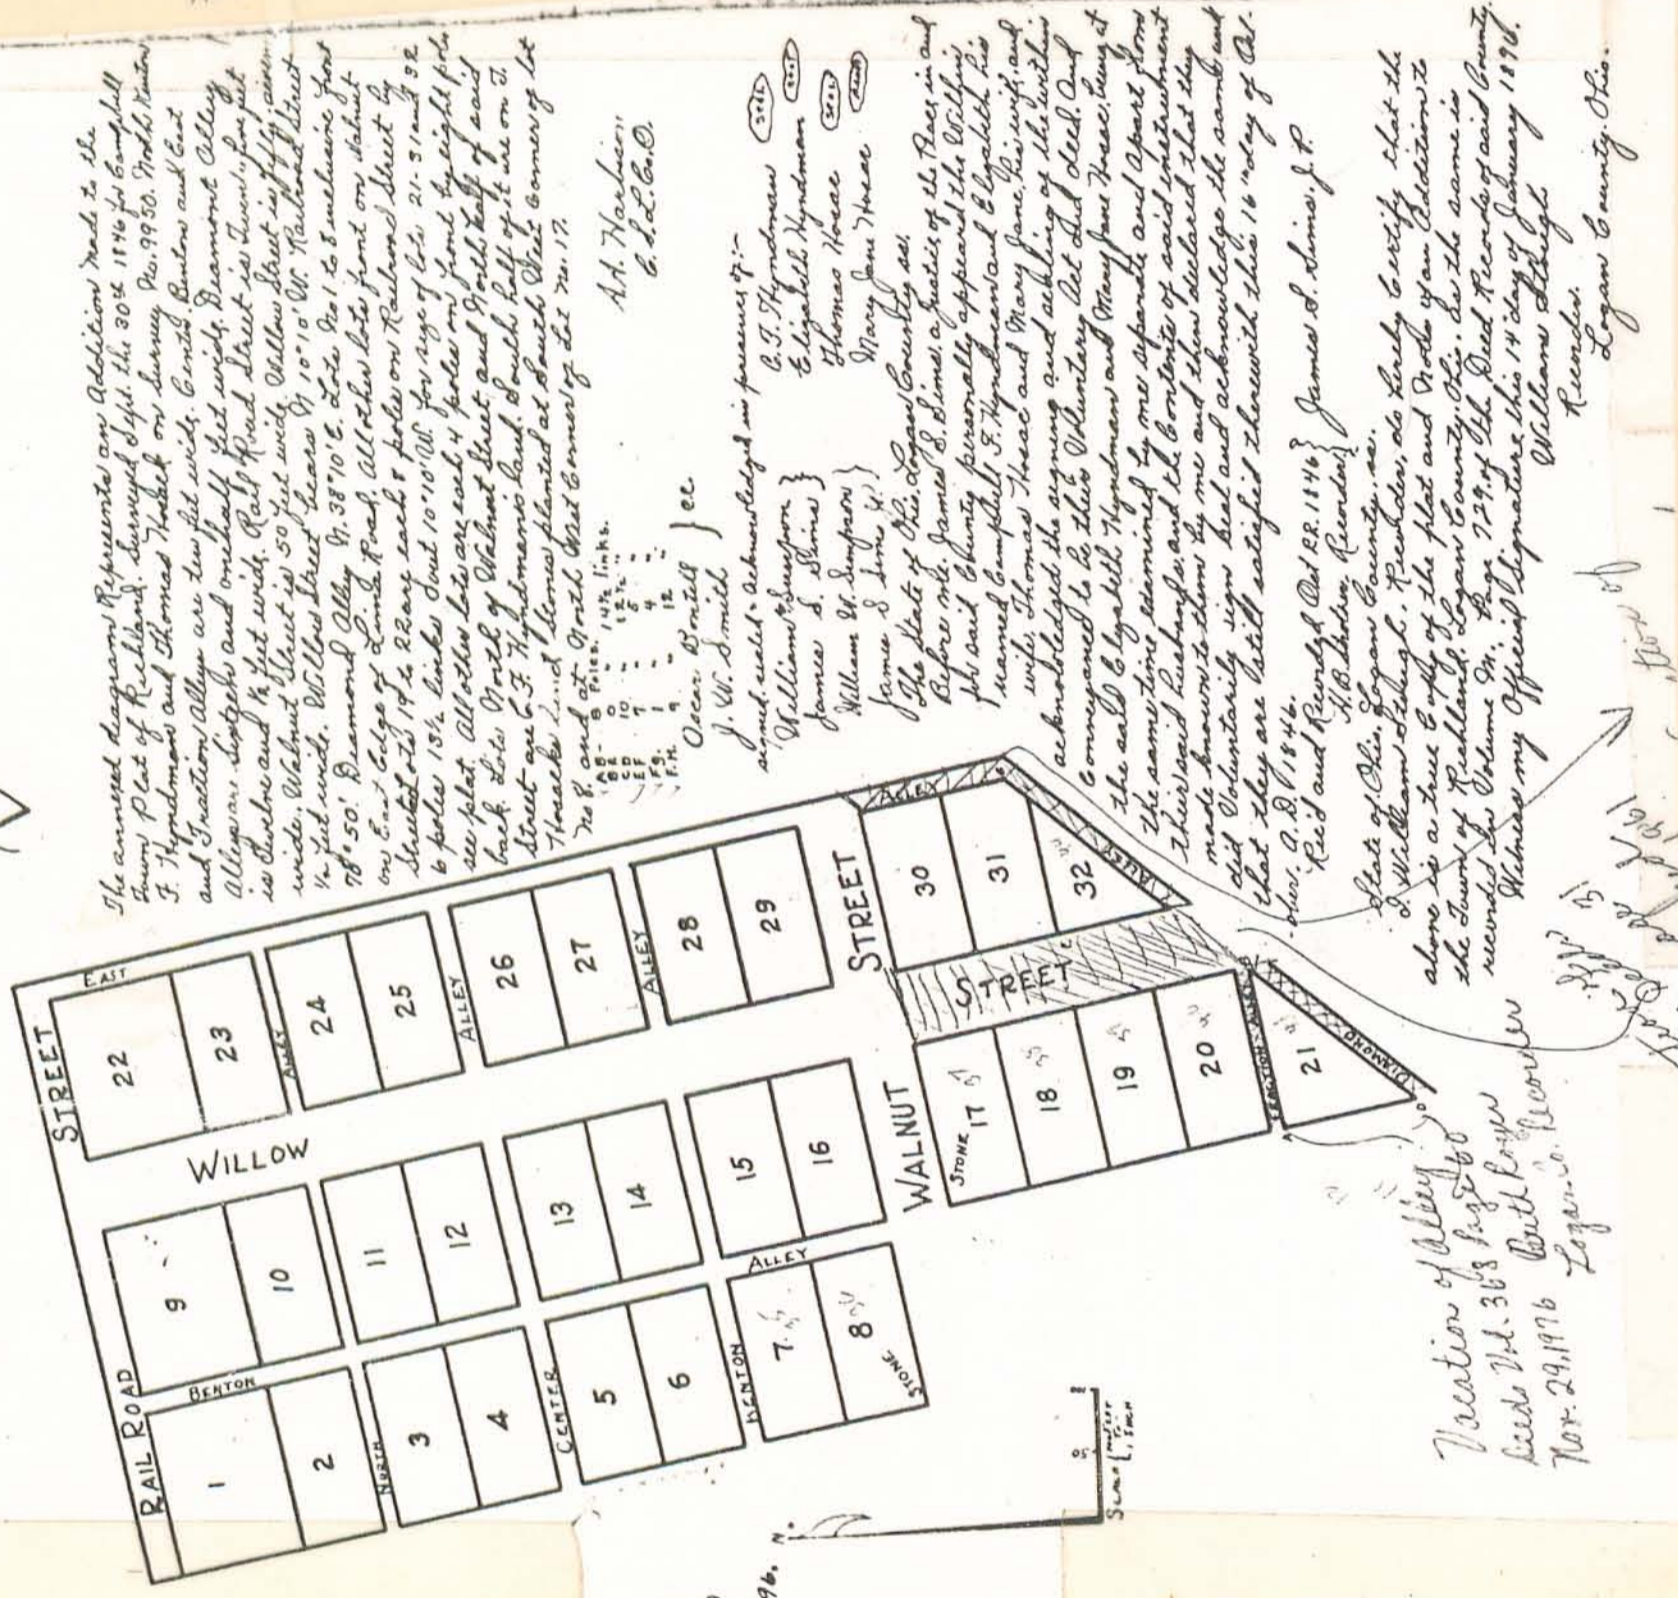



A. H. Hackett,
 C. L. C. O.

Oscar Smith } ec.
 J. W. Smith } ec.

and said, acknowledged in presence of:-
 F. J. Hyattman (S)
 E. J. Hackett (S)
 Thomas Hackett (S)
 Mary Jane Hackett (S)
 James S. Jones (S)

The plat of this Logan County ss.
 Before me, Samuel S. Jones, a Justice of the Peace, in and for said County, personally appeared E. J. Hackett, his named competent F. Hyattman and E. J. Hackett, and wife, Thomas Hackett and Mary Jane Hackett, and acknowledged the signing and asking of the within-mentioned plat to be their voluntary act and deed, and accompanied to be their voluntary act and deed, and the same time, examined by 

 A. B. Hackett, Recorder
 State of Ohio, Logan County, ss.
 S. W. Williams, Clerk
 above is a true copy of the plat and North of Benton Street, the town of Richland, Logan County, Ohio, in the same as recorded in Volume No. Page 124 of the Plat Records of said County, Witness my Official Signature this 14 day of January 1898.
 W. Williams, Clerk
 Recorder
 Logan County, Ohio.

Vacation of Alley
 Logan Co. Recorder