


# STOKES TOWNSHIP VIRGINIA MILITARY SURVEY 12276

SCALE 200 FEET TO THE INCH

See Page 35

NOTE "A" - VACATION - SEE R-7872  
 NOTE "B" - VACATION - SEE R-6652  
 NOTE "C" - VACATION - SEE R-4707

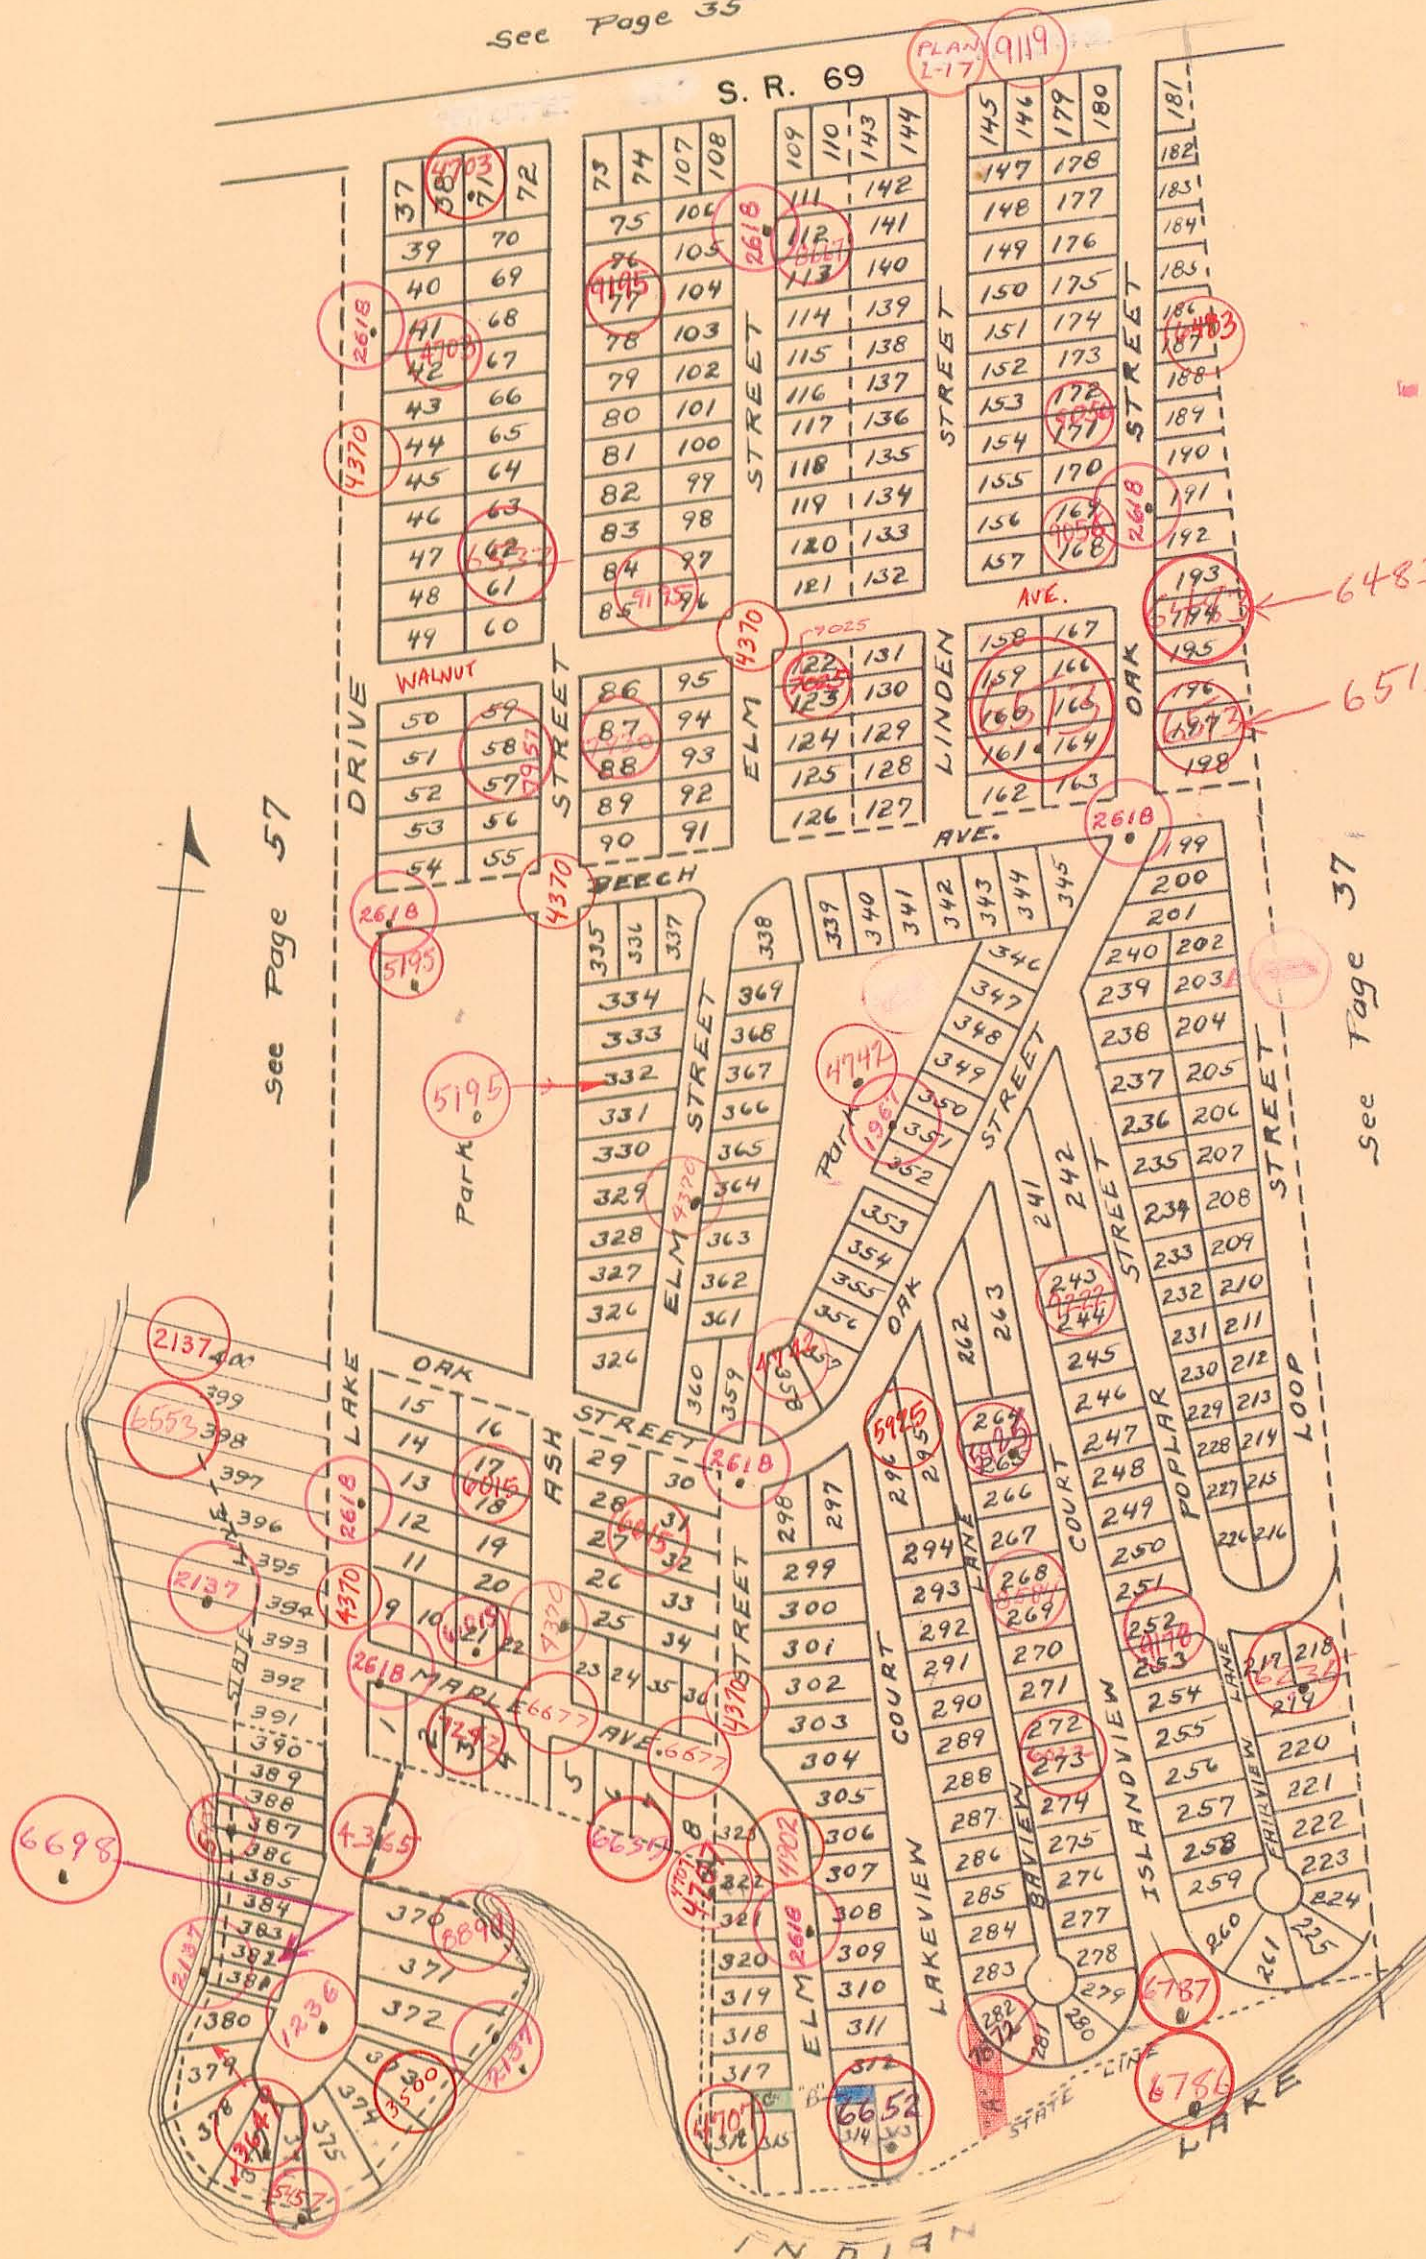

- LOTS 1 TO 36 AVONDALE NO. 1
- LOTS 37 TO 126 AVONDALE NO. 2
- LOTS 199 TO 369 AVONDALE NO. 3
- LOTS 127 TO 198 AVONDALE NO. 4
- LOTS 370 TO 390 AVONDALE NO. 5
- LOTS 390 TO 400 AVONDALE NO. 6

NOTE: FOR ALL LAKE LAND AGREEMENTS SEE

6786