WASHINGTON TOWNSHIP

SECTION 36 TOWN 6 S. RANGE 8 E.
SECTION 31 TOWN 6 S. RANGE 9 E.
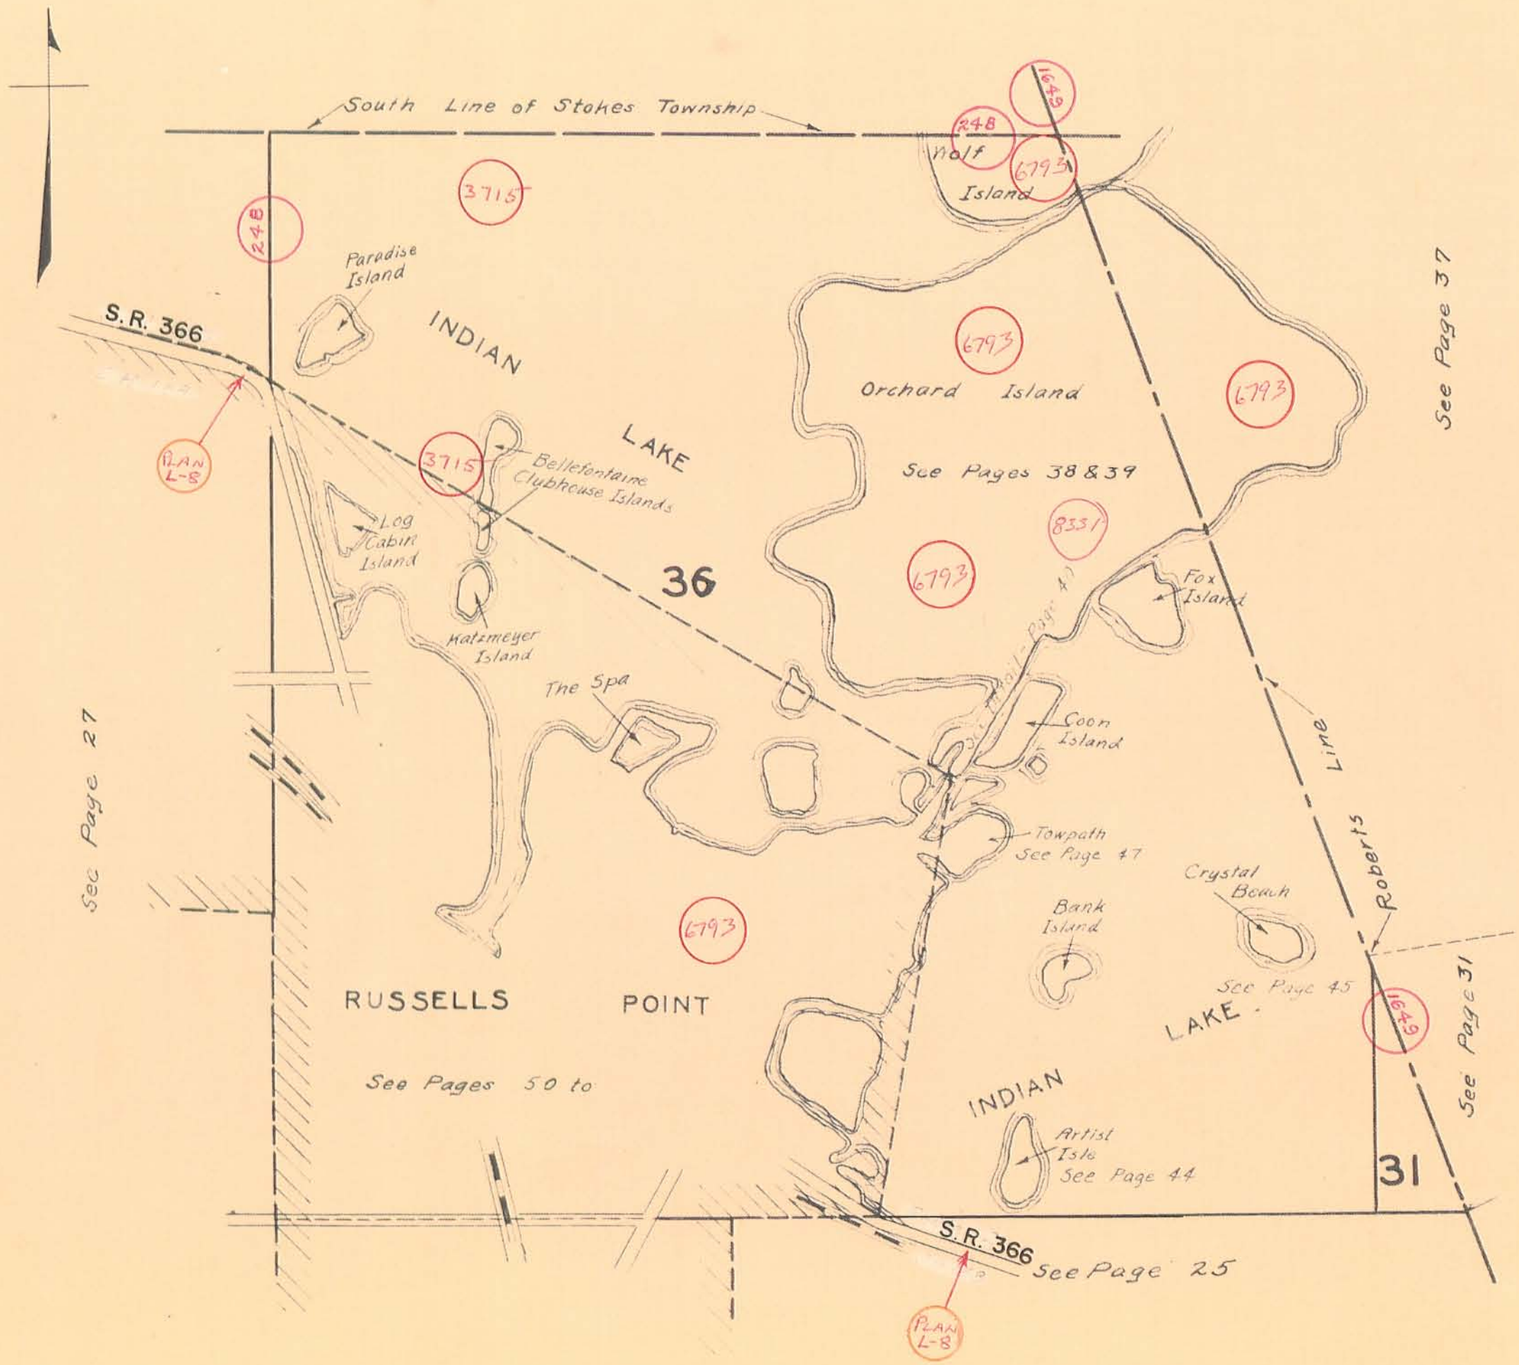
SCALE 10 CHAINS TO THE INCH