

PLUM CEMETERY

LOGAN CO. WASHINGTON TWP.

OFFICIAL PROJECT NOS. 465-42-3-467 & 665-42-3-232

3.6 ACRES


5 PAGES

LEGEND


- ① REVOLUTIONARY WAR
- ⑩ WAR OF 1812
- ⑯ WAR WITH MEXICO
- ⑲ CIVIL WAR
- ⑳ SPANISH AMERICAN WAR
- ㉑ WORLD WAR

HISTORY

47769
SCALE 1"=30'

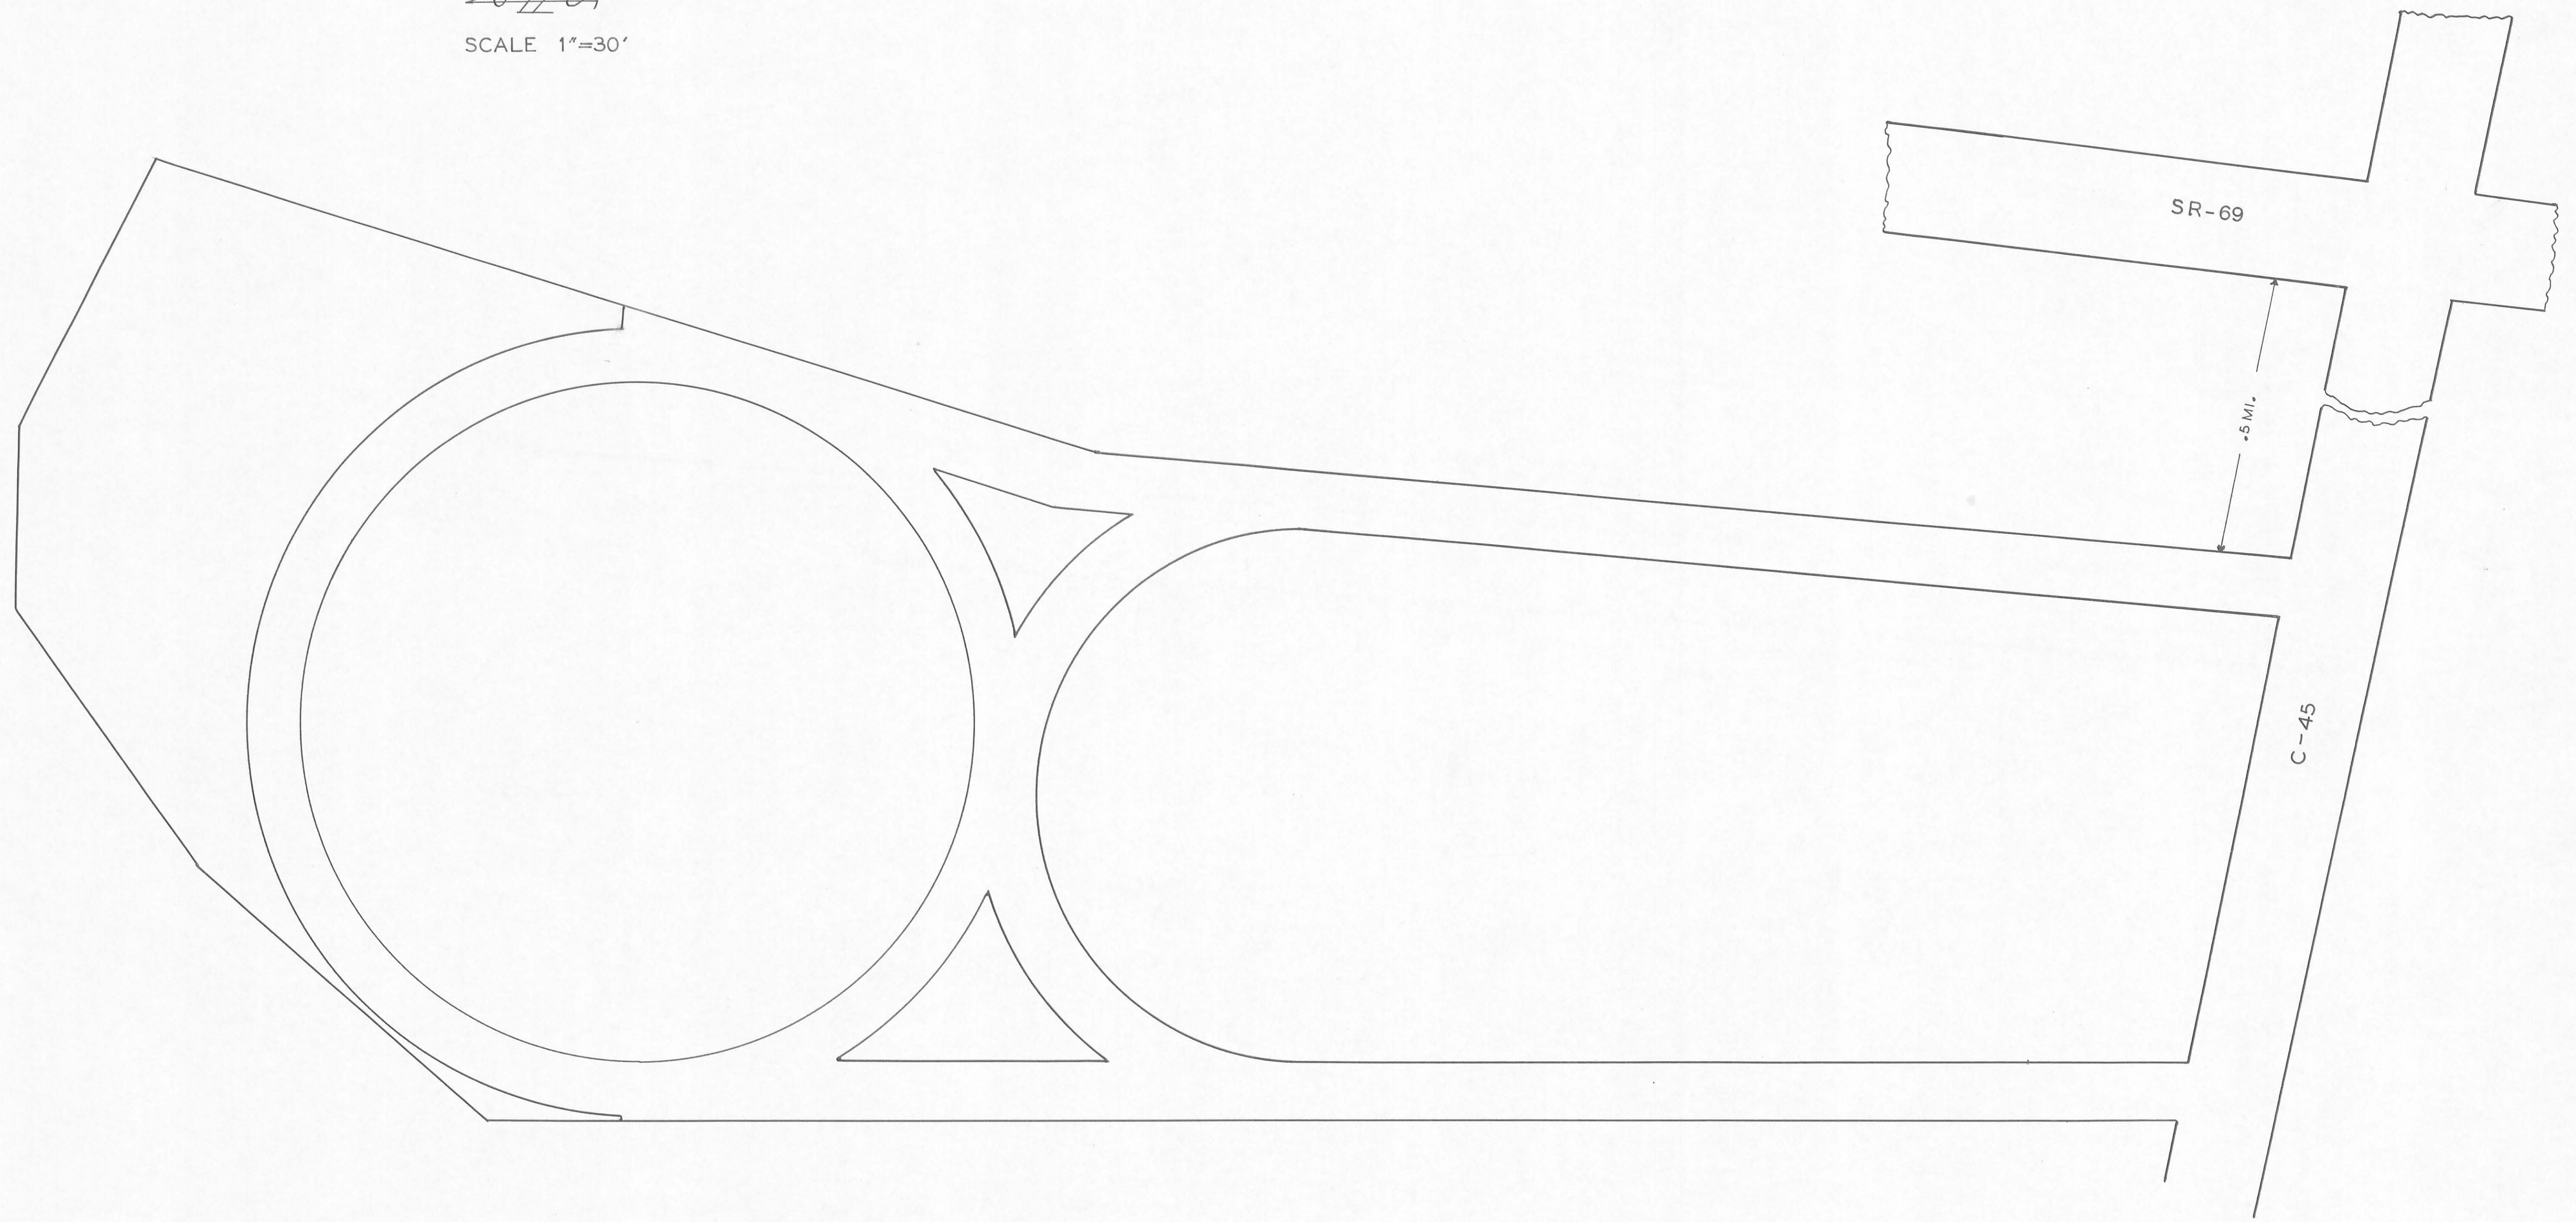


NAME	SEC	L	R	G	W
BROWNLEY ALEX W	80			5	19
COX JOHN			9	9	19
DAY JAMES L	140			2	19
HERNDON ROBERT J	104			2	19
MC KINNON B F	44			3	19
MC KINNON WILLIAM H	6			1	10
PLUM JASPER M	58			2	19
PLUM JOHN A			9	18	19
SHAFFER ABRAHAM			5	18	10
SMITH FRANCIS M	99			2	19
WREN MILTON	77			3	31
WRIGHT JOSEPH J	98			3	19
SUPPLEMENTARY LIST					
FITE WM L	128				3

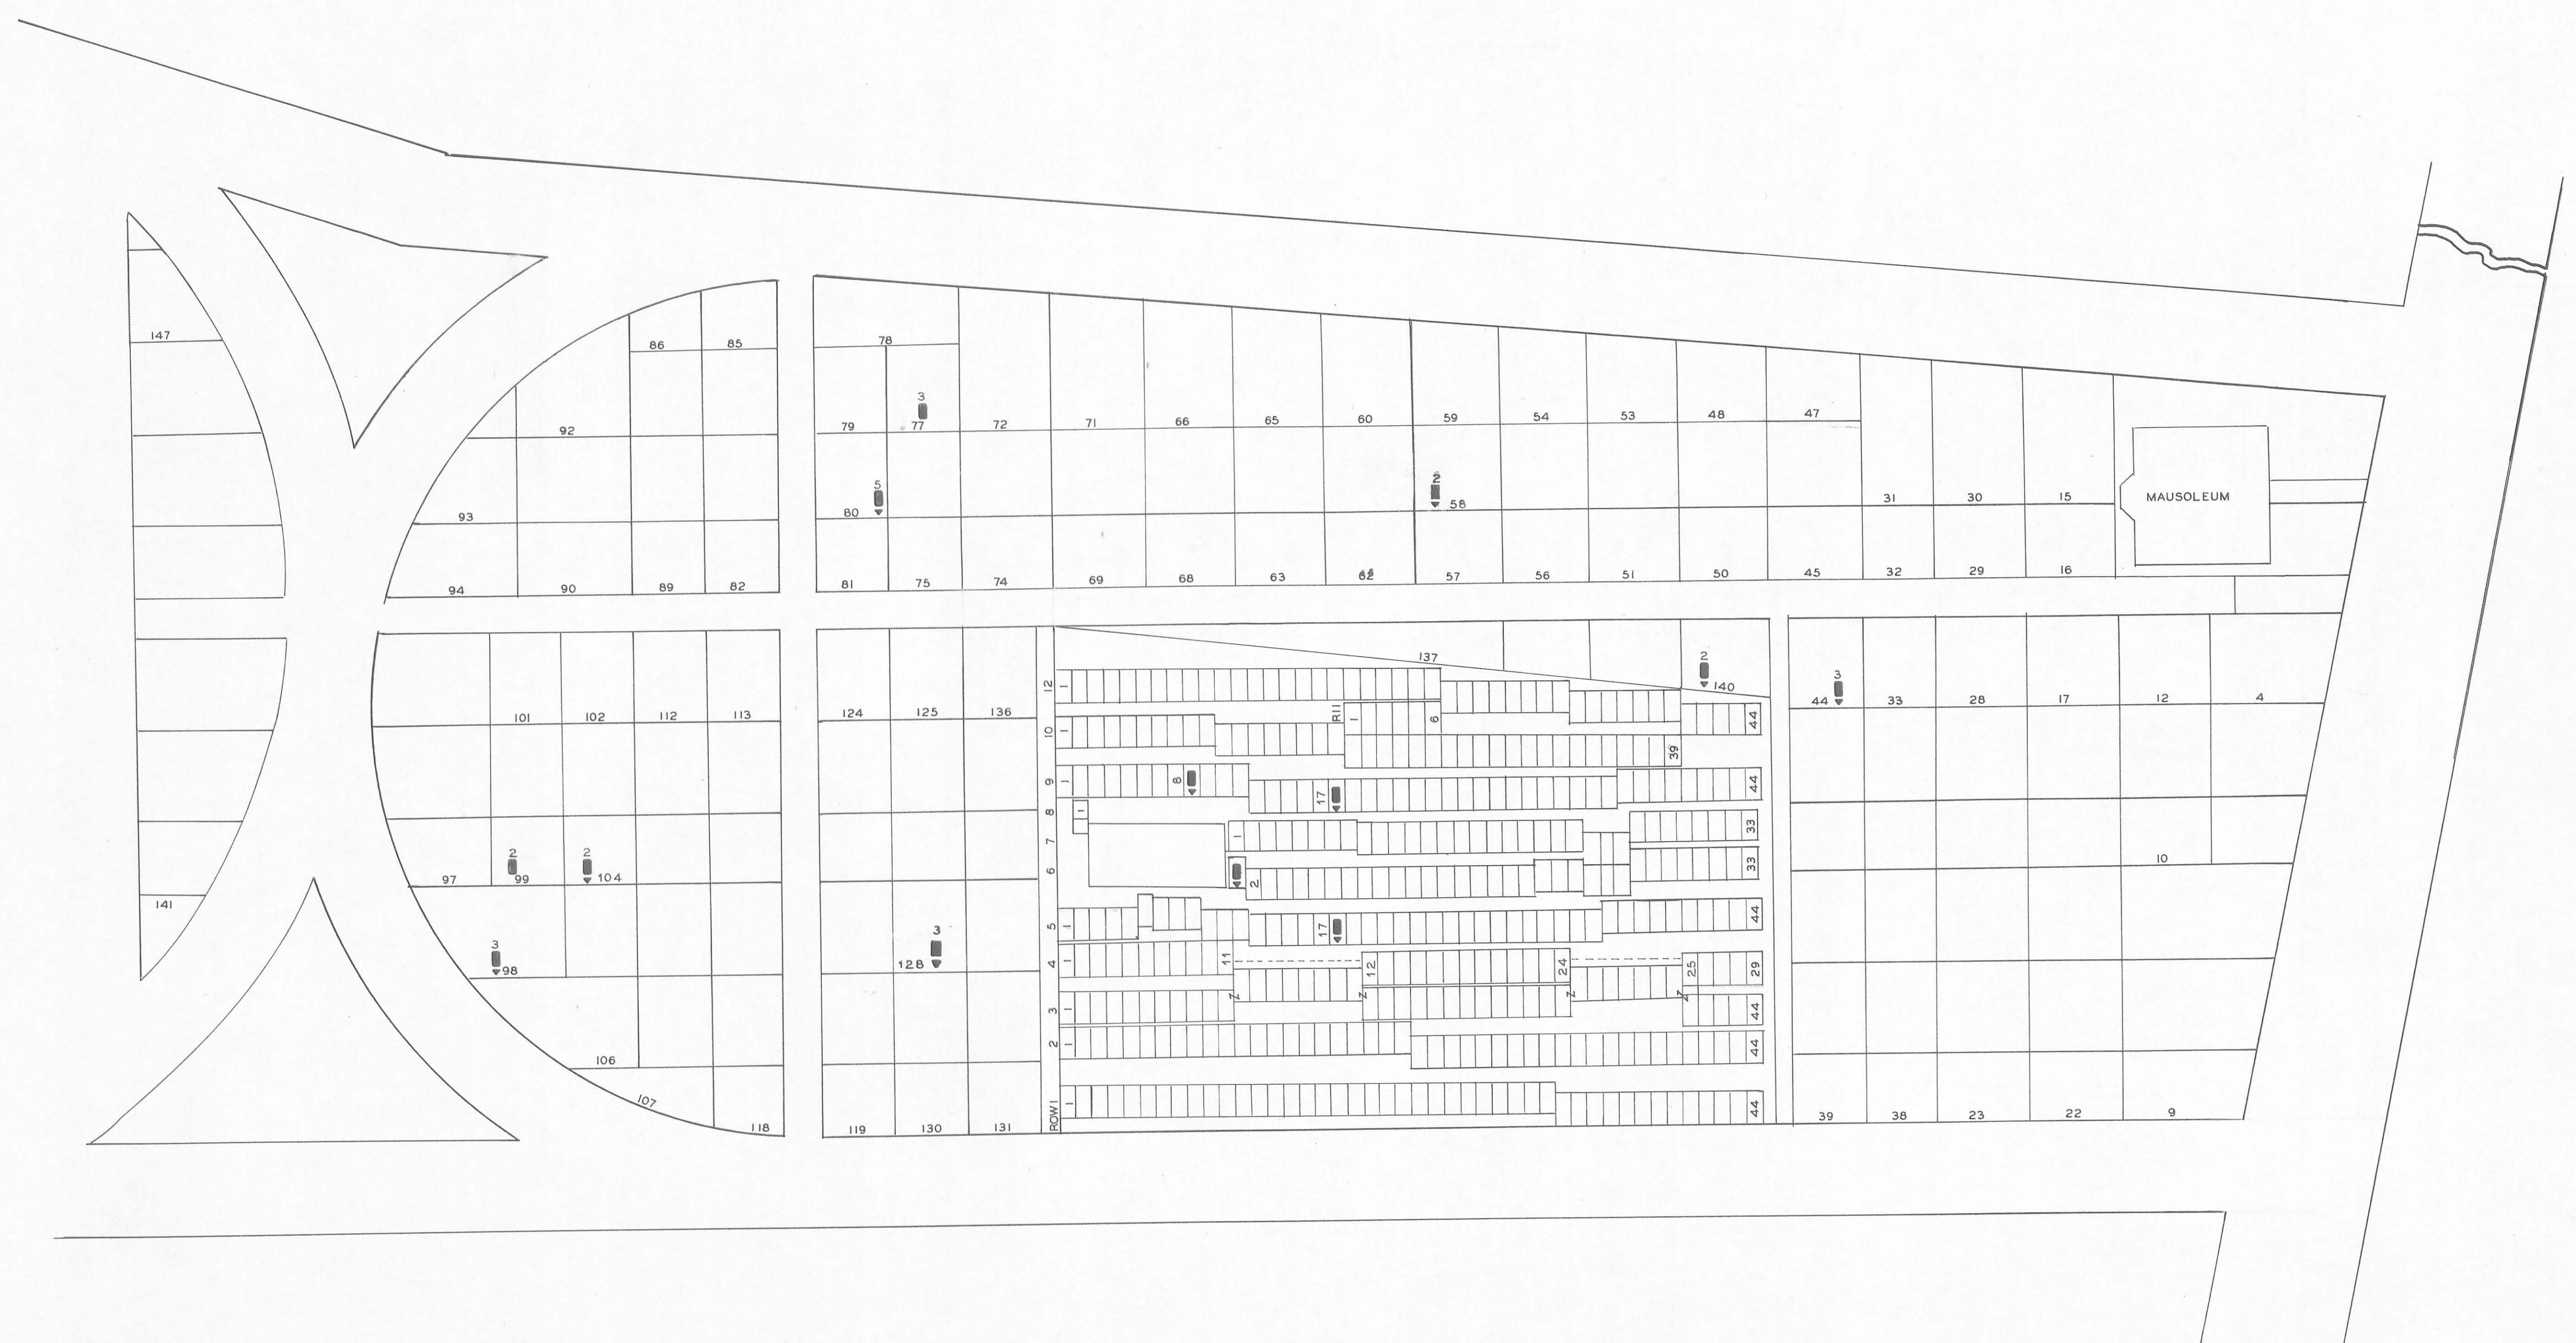




LEGEND
 SEC-SECTION L-LOT R-ROW
 G-GRAVE W-WAR
 * - POSITION UNKNOWN

WZS
 SCALE 1"=20'

NAME	SEC	L	R	G	W
CHERRY AMOS	209			3	19
FITE FRANK	195			5	31
HUBBARD JAMES	164			4	19
MC BRIDE SETH	191			5	19
MILLER JOHN W.	231			2	19
PLUM WILLIAM H.	182			11	19
STROUBLE WILLIAM A.	308			4	
WAGNER JASPER PERRY	205			6	31

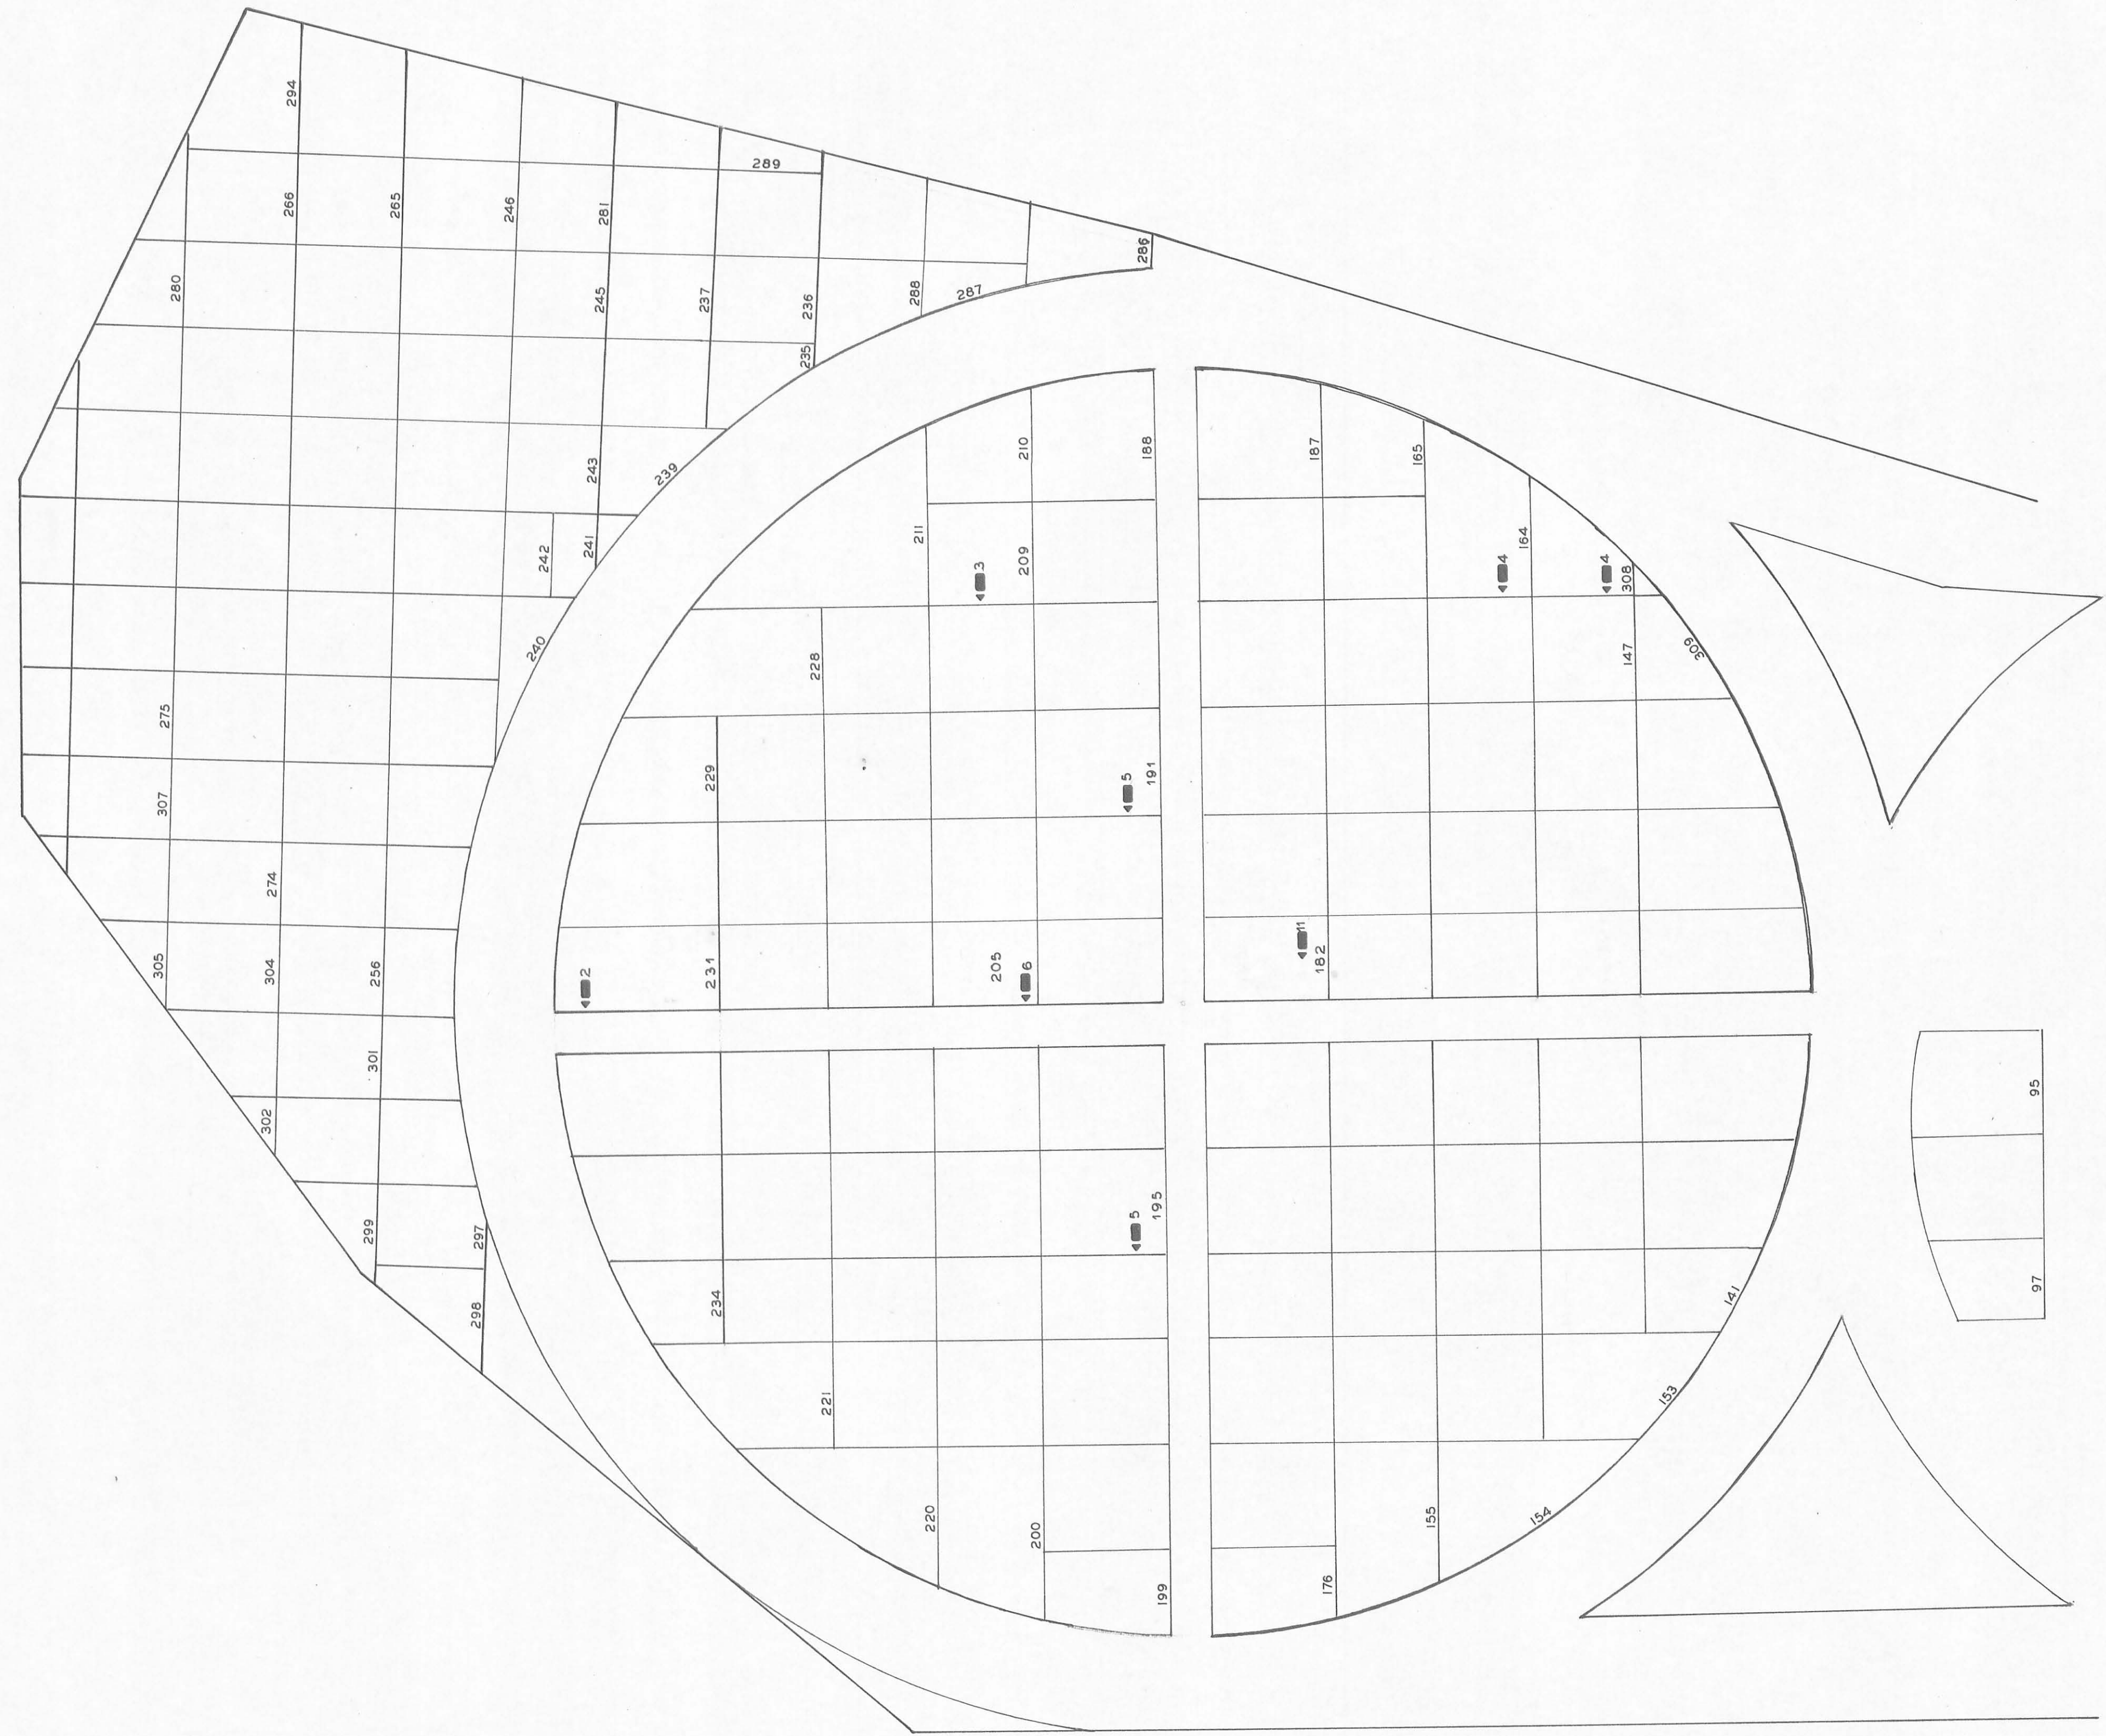

SCALE 1"=20'

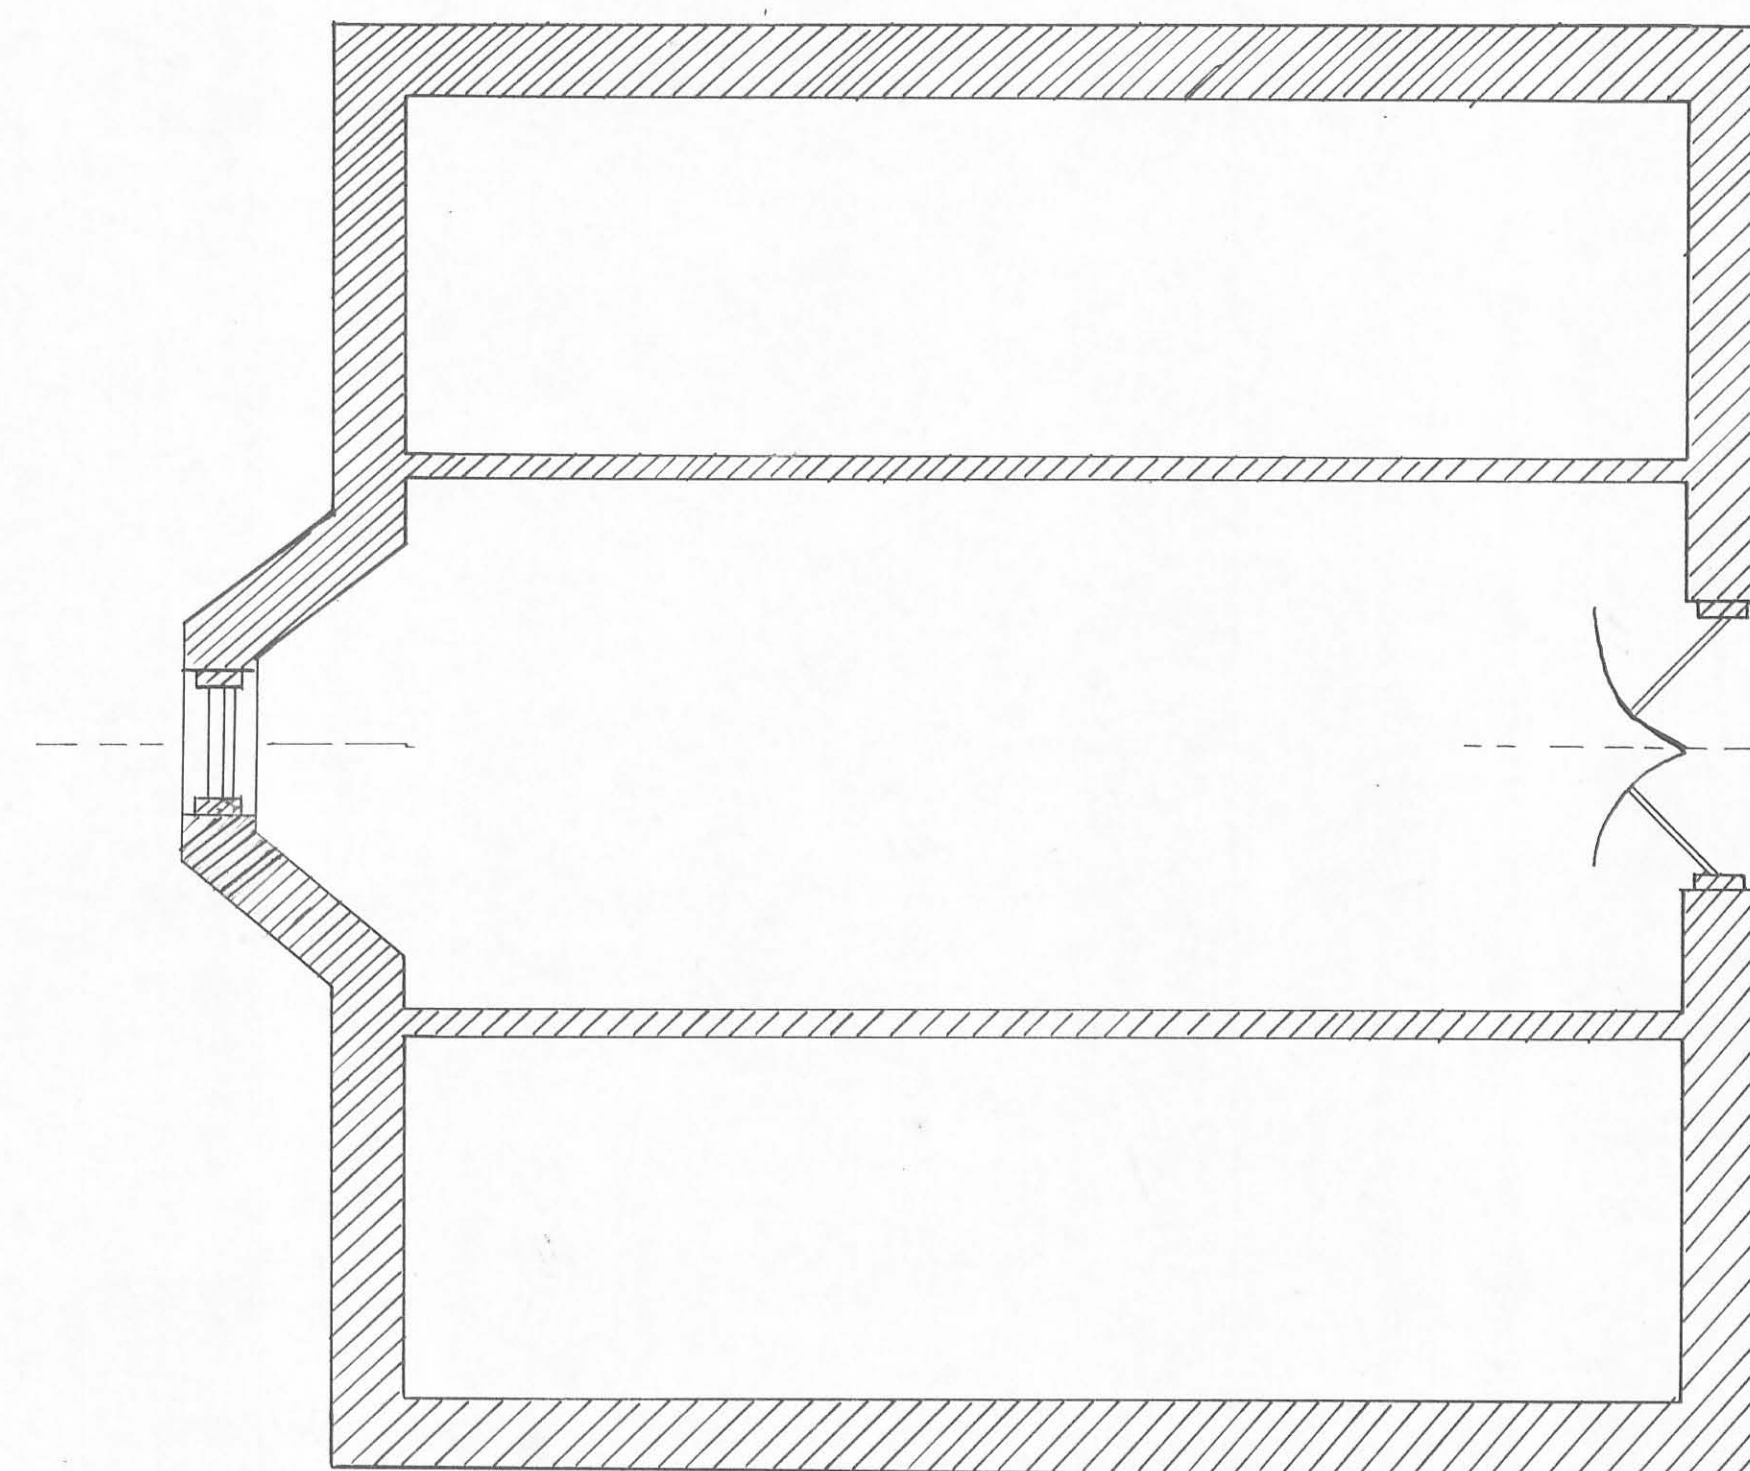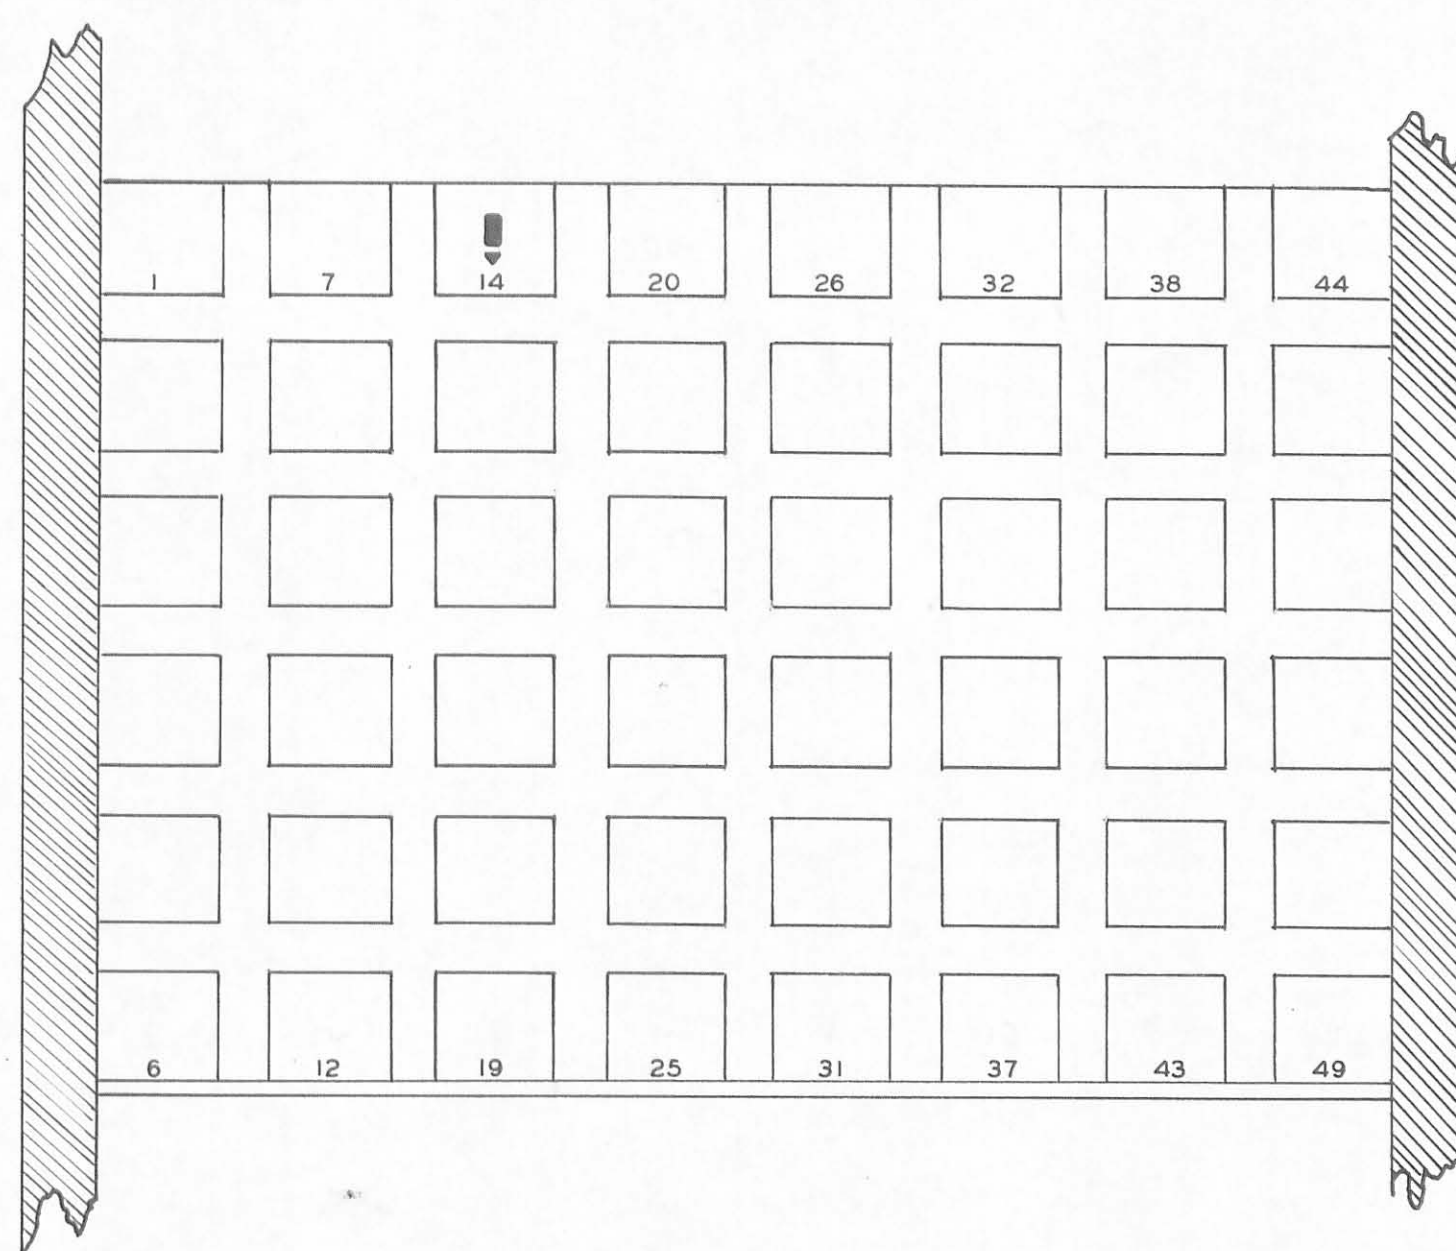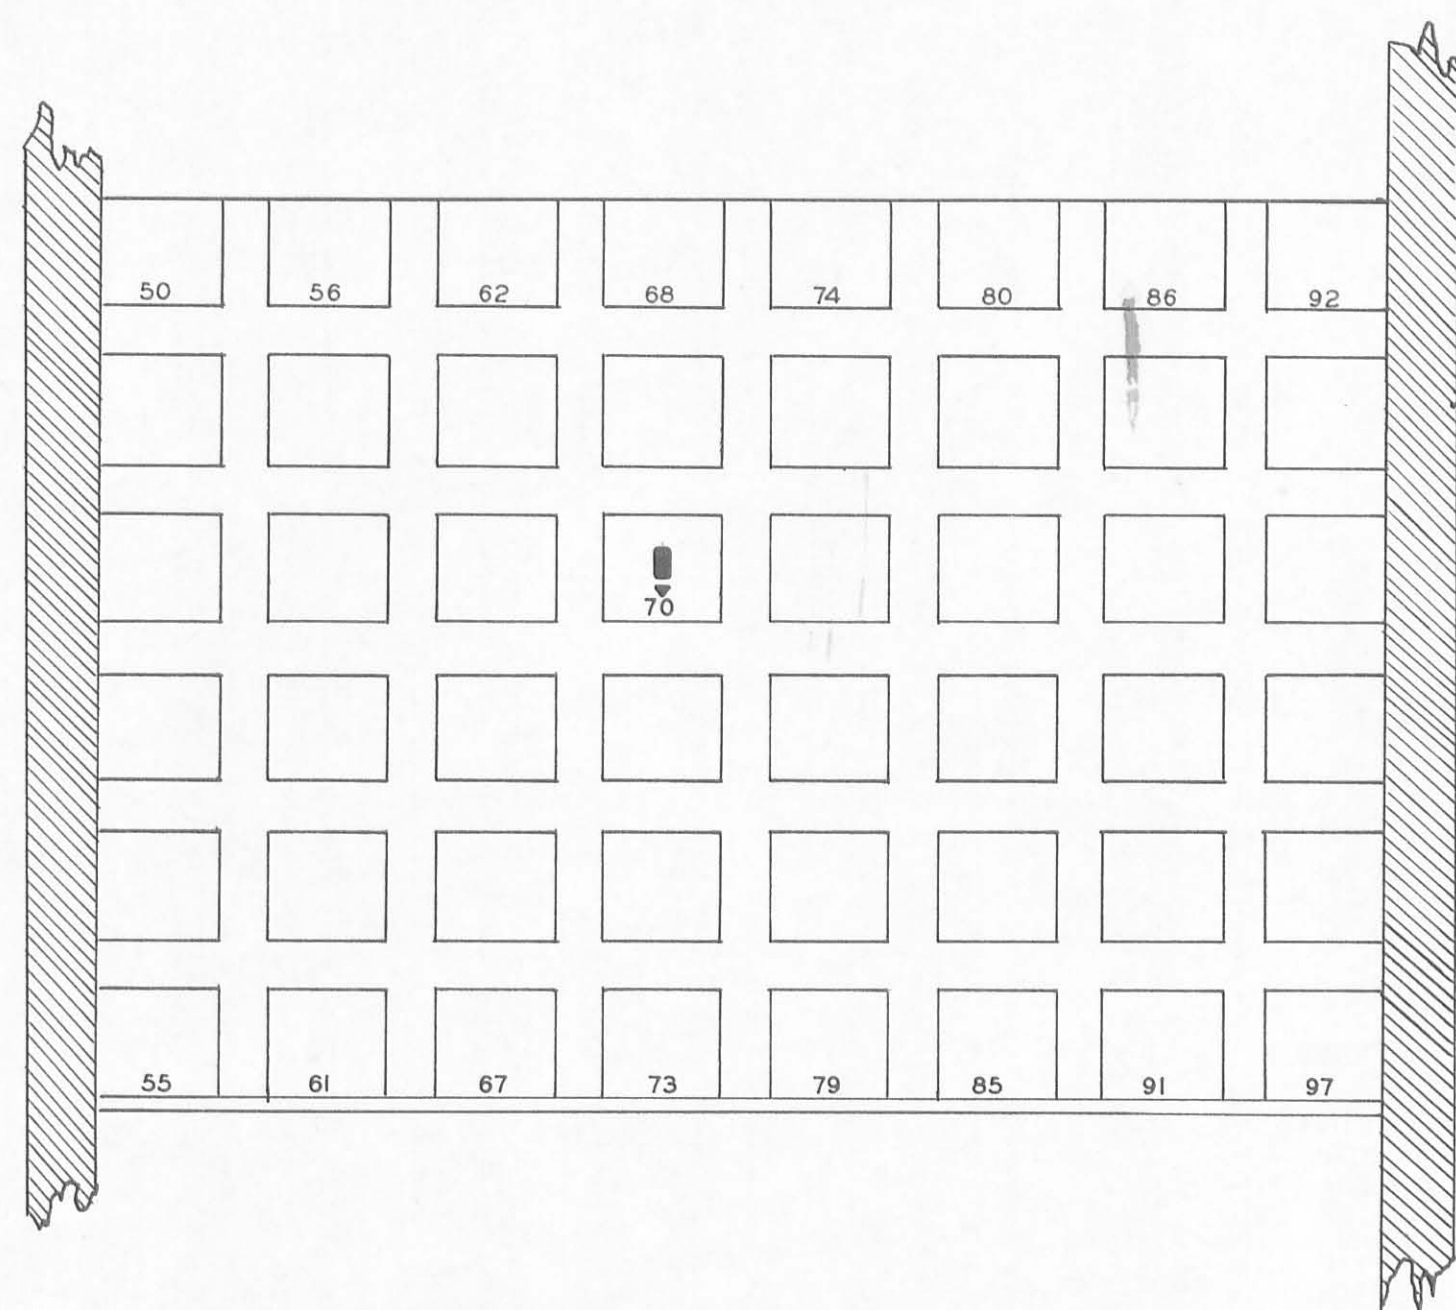


W.S.
SCALE 1" = 1/4"

NAME	SEC	L	R	G	W
BURKE JOHN			1	21	10
CROSSLEY JOHN			2	20	16
HOWE WILLIAM H.			7	73	19
KAYLOR JOHN C.			7	70	19
LOFFER FRANCIS M.			2	26	19
LOW HENRY			3	19	19
MC CALLY N.	B	45	5	43	10
MOORE JOHN H.				2	19
NOTESTINE PERRY			10	78	19
PARKER BARZILLA			9	40	19
PENNINGTON H. O.	E	20		4	19
RAIRDON GEORGE W.			9	44	19
WILLIAMS LEONARD E.		48		2	31

HINKLE AMOS
 Peacock, Herbert Smith * 8 13 31
 O'Neill Homer *

T-13 SR 69 1.6 →

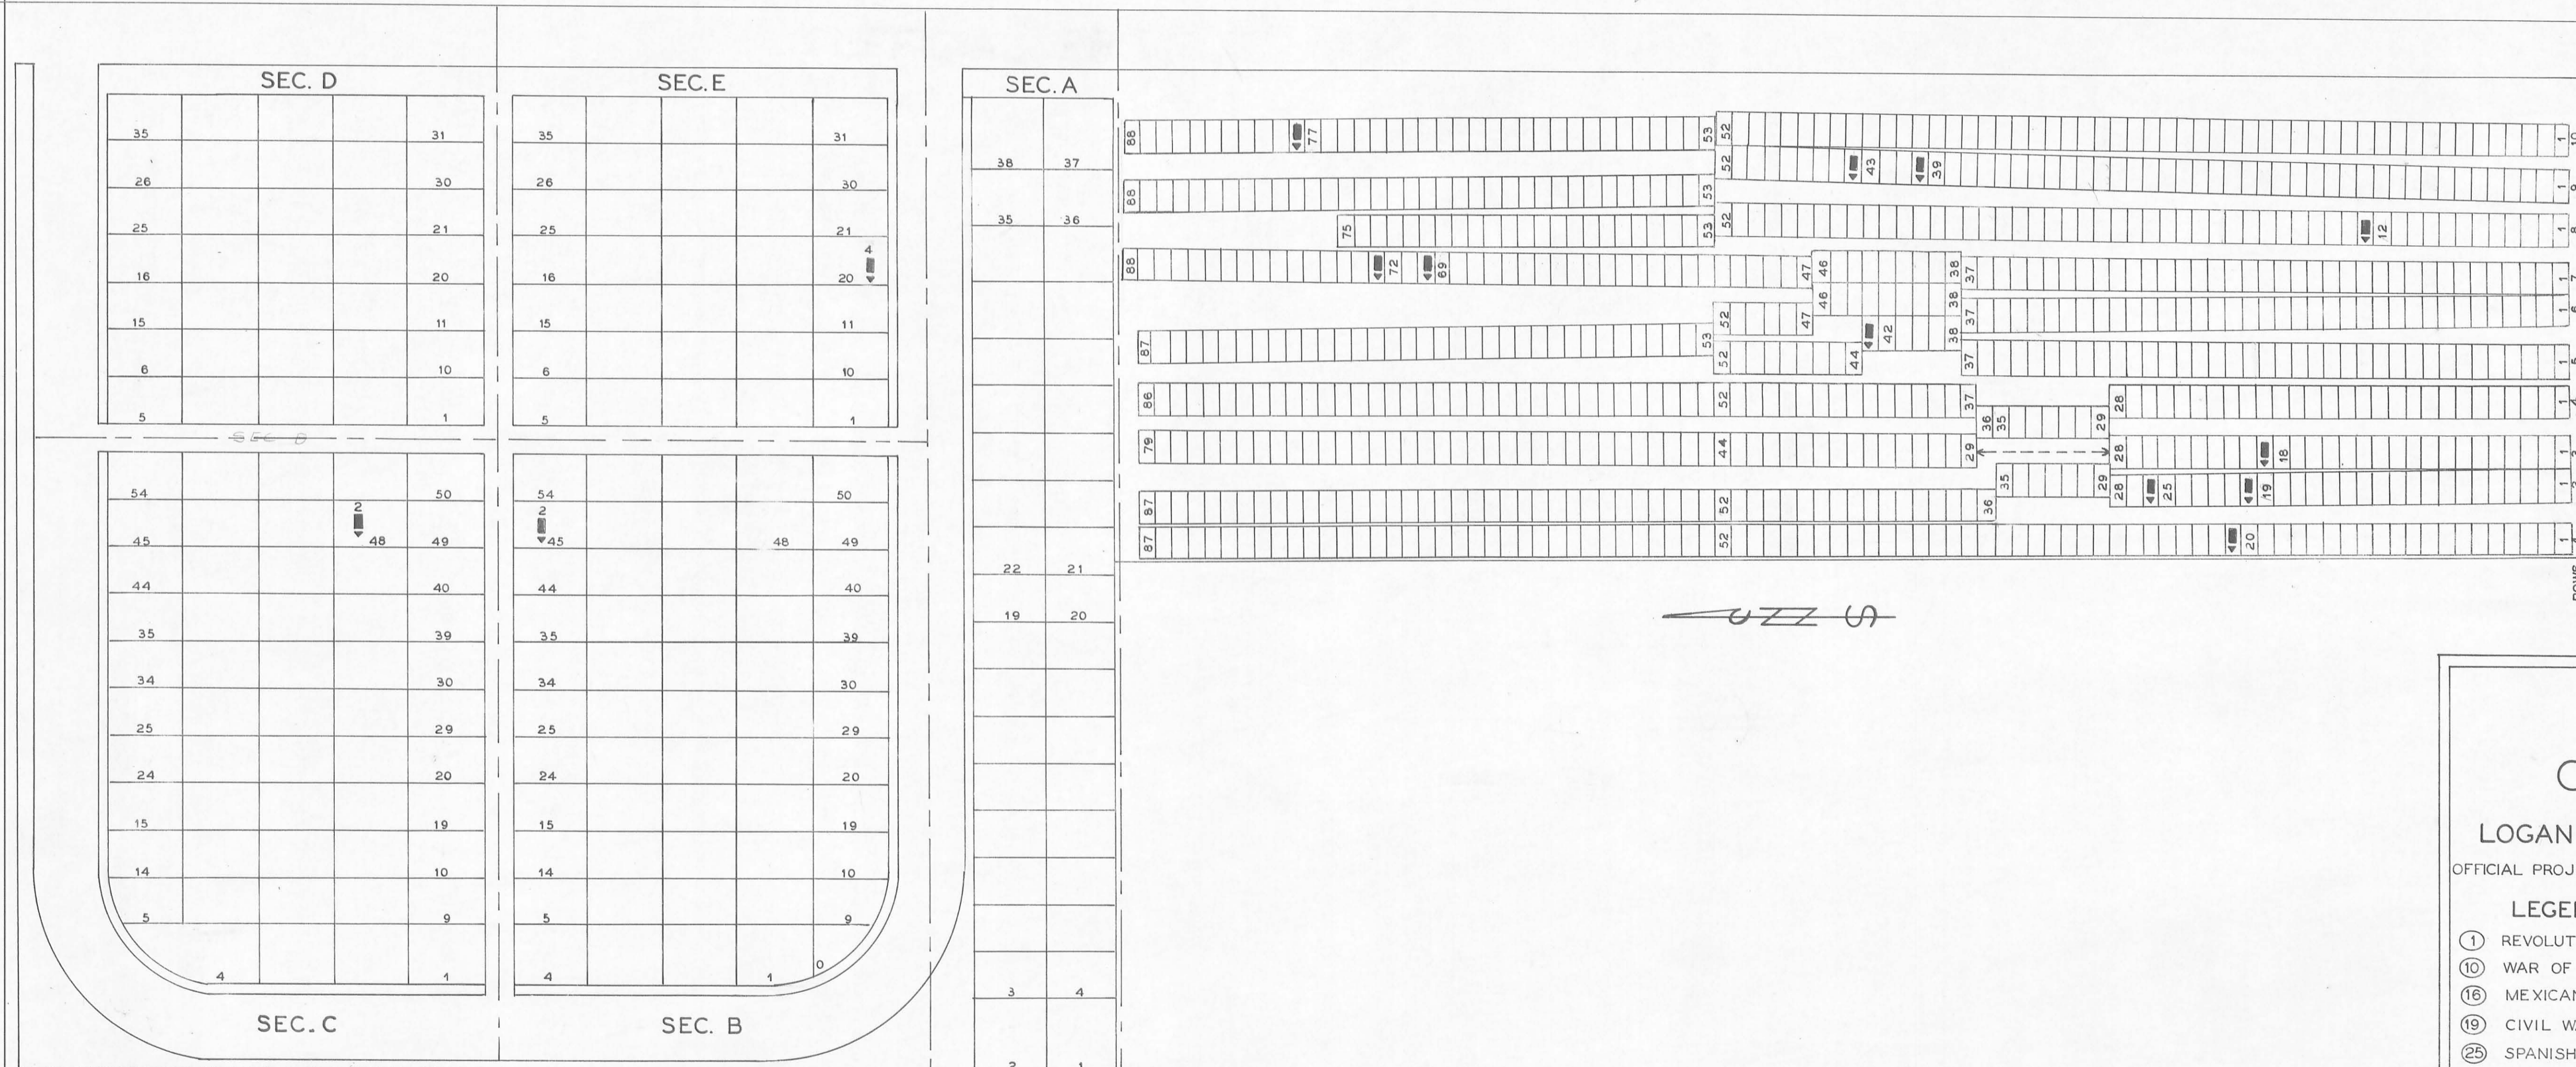

LEGEND
 SEC.=SECTION L=LOT R=ROW
 G=GRAVE W=WAR
 *= POSITION UNKNOWN

REA CEMETERY

LOGAN CO. BLOOMFIELD TWP.

OFFICIAL PROJECT NOS. 465-42-3-467& 665-42-3-232

LEGEND	HISTORY
① REVOLUTIONARY WAR	
⑩ WAR OF 1812	
⑯ MEXICAN WAR	
⑲ CIVIL WAR	
⑳ SPANISH AM. WAR	
⑳ WORLD WAR	

SCALE 1"=20' ACRES 1.75

46-1-1 /

RUSHSYLVANIA CEMETERY

LOGAN CO. RUSHCREEK TWP.

OFFICIAL, PROJECT NOS. 465-42-3-467 & 665-42-3-232

13 ACRES

5 PAGES

LEGEND

- ① REVOLUTIONARY WAR
- ⑩ WAR OF 1812
- ⑯ WAR WITH MEXICO
- ⑲ CIVIL WAR
- ⑳ SPANISH-AMERICAN WAR
- ⑳ WORLD WAR

HISTORY

46-13-1

PAGE 75

PAGE 75

PAGE 75

PAGE 74

PAGE 74

PAGE 74

PAGE 76

PAGE 74

PAGE 74

PAGE 76

PAGE 76

.3MI.

C-6

S. R. - 274


GAZZA

NAME	SEC	L	G	W
BARR JACOB		84		3
CARHOOF JOHN A.		68	5	19
DEARDORFF JOHN R.		45	2	19
HOLLIDAY JOHN		119	5	19
KAUTZMAN JAMES W.		12	4	19
MALLORY JOHN S.		49	5	
MC CULLOUGH B. F.		64	5	19
PASH RICHARD E.		73	4	
PEGG O. R.		19	5	19
PREDMORE WM.		39	5	19
RICHARDS AMOS		106	5	19
ROBERTS DAVID		72	5	19
RUMER SAMUEL		33	4	19
STEWART ROBERT		97	4	19
SWIGERT DAVID		103	5	19
THOMAS M. D.		85	5	19
TITUS JAMES D.		90	4	19
WEBBER WILLIAM		126	5	
WILLIAMS NICHOLAS J.		82	3	19
WRIGHT WAIT		58	5	19
SUPPLEMENTARY LIST				
ODER WILLIAM		20	5	19
TAPP ALBERT A.		3	1	
MC GRATH JAMES L.		66	1	


SCALE 1"=20'



NAME	SEC	L	R	G	W	NAME	SEC	L	R	G	W
ANDERSON WM.	240			4	19	KRAMER JOHN W.	237			5	19
BICKHAM WM.	148			4	19	KRAMER JOS.		14		13	19
BRUCE LEWIS L.	152			3	19	LAWRENCE PATRICK	288			5	19
BRUGLER JOHN Q.	307			3	19	LOUGHMAN THADIOUS	179			5	19
CARSON ROBERT S.	140			5	19	MC GILL WM.	25		28	19	19
CLAYBAUGH LEWIS	129	14		3	19	MILLER JAMES M.	155			4	19
CLINE ISAIAH	177			5	19	MOORE JOSEPH		9		21	19
DAY GEORGE O.	177			5	19	NEWLAND DAVID	185			5	19
EISENSTEIN WM.	189			2	25	NEWLAND WESLEY		28		19	19
ELLIOTT HARMON M.	362			5	19	OGELESBEE ISIAH	346			1	
FINCH GEO. W.				16	19	ROSE W. Z.	340			4	19
FINCH OLIVER				8	5	ROSEBROOK GEORGE	344			3	19
GARWOOD THOMAS W.	345			3	19	ROSEBROOK WILLIAM	343			3	19
GILBERT EDWARD J.	272			2		SELDERS T. H.	358			1	19
GROSS SAMUEL				5	19	SIMPSON SAMUEL P.	204			2	19
HARSHFIELD ELIAS	222			5	19	STEWART FRANK	331			3	19
HATCHER ABLE	350			1	19	VANCE WILLIAM N.	201			5	19
KAUTZMAN PETER	202			5	19	WILLIAMS NELSON W.	347			4	19
						WREN ANDREW	232			5	19
						ZIMMERMAN E.	360			1	19

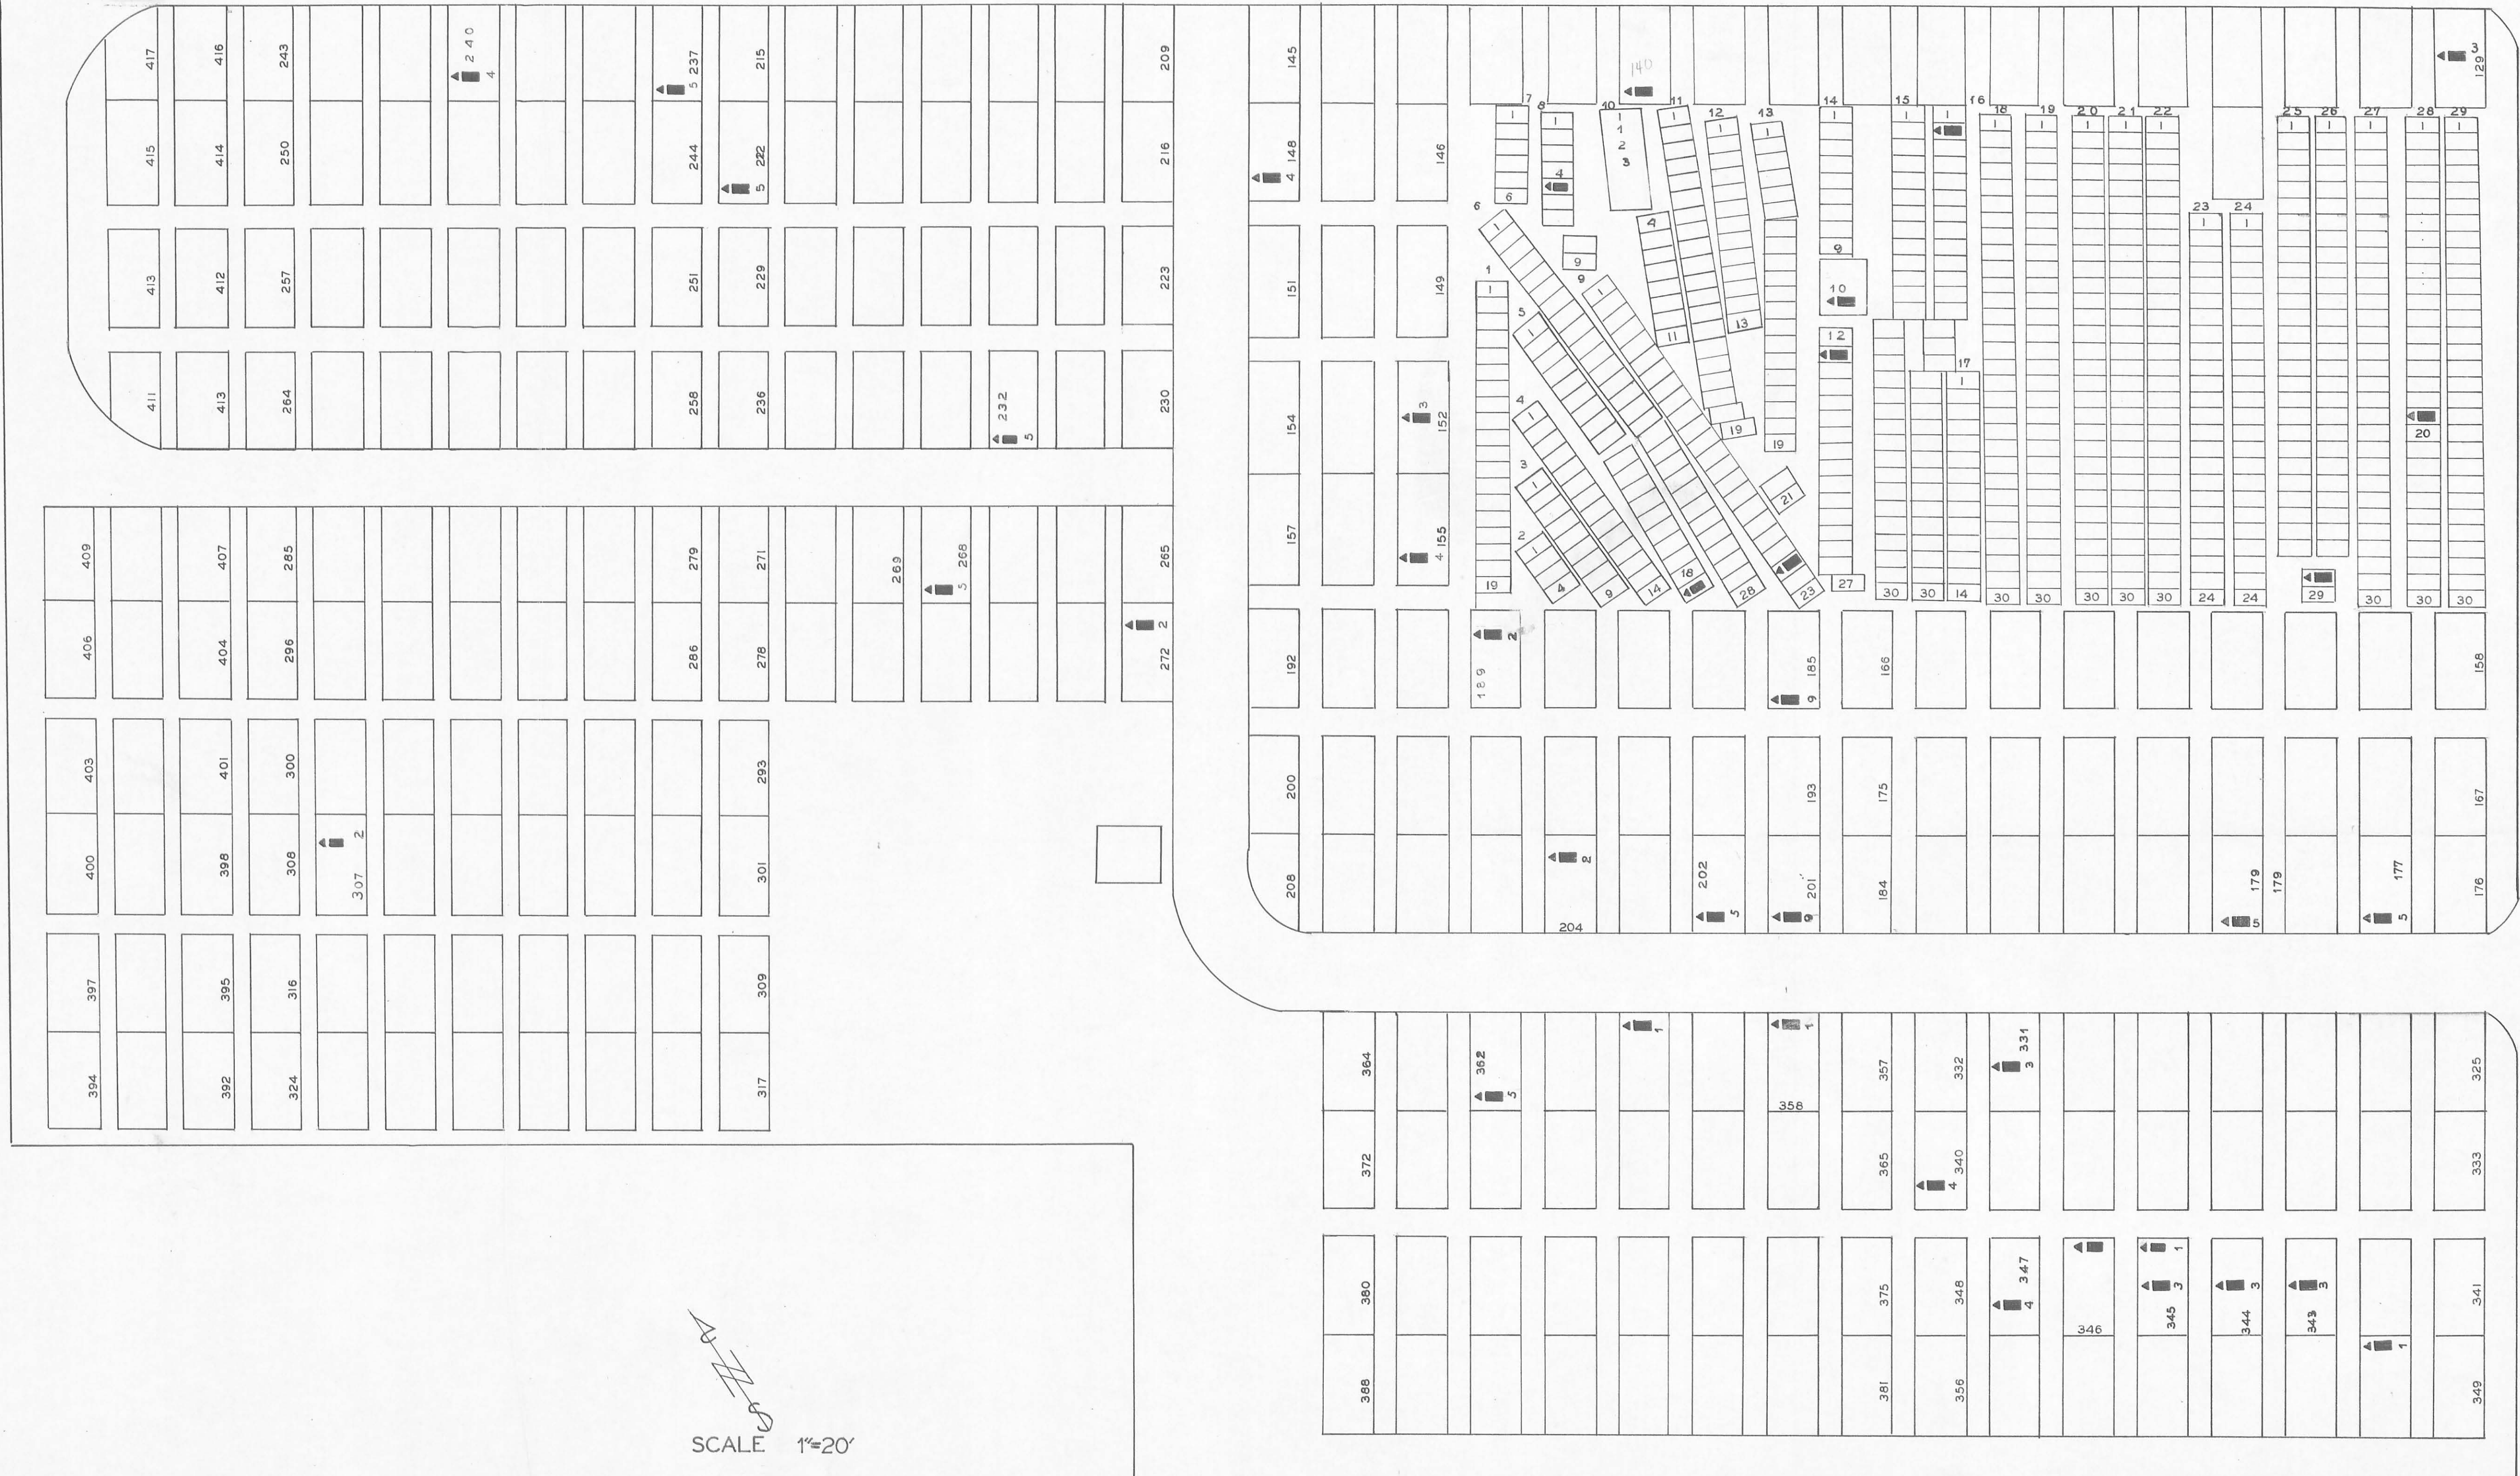

SCALE 1"=20'

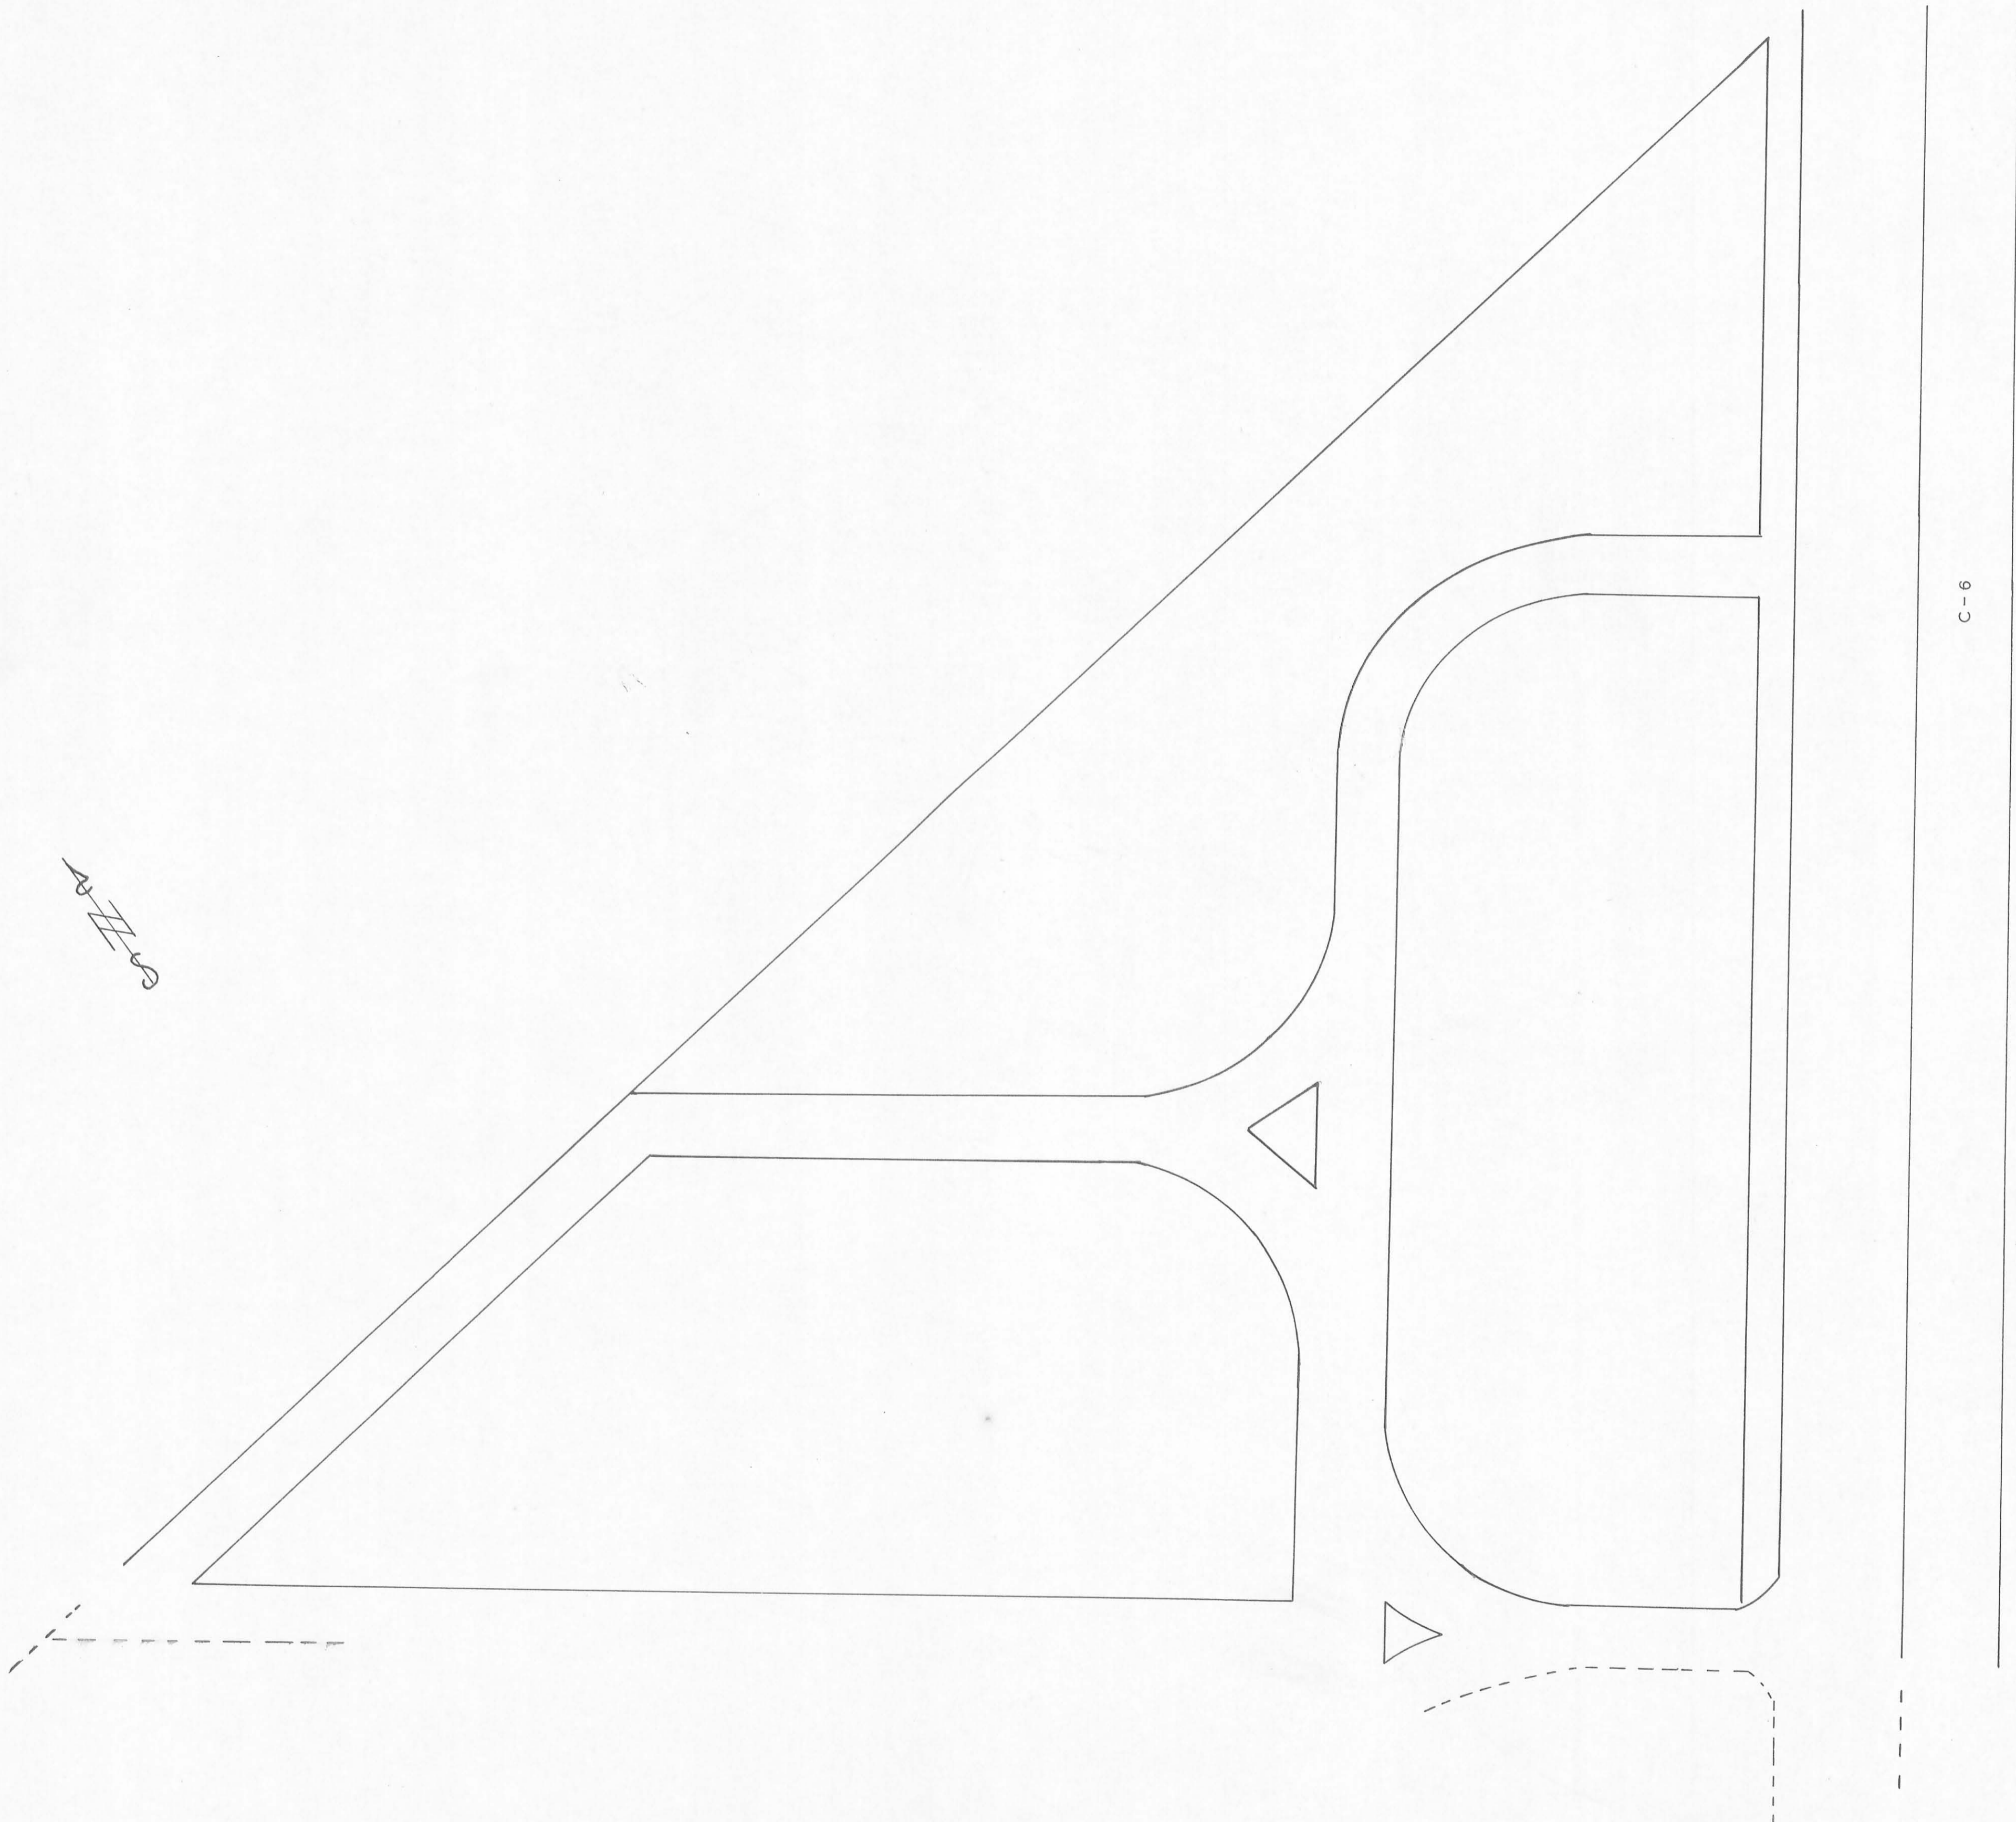

C-6