

NAME	SEC	L	R	G	W
CREVISTON SAM'L	17		24	19	
HENRY JAMES	19		41	19	
M'COLLOCH GEORGE	20		37	10	
M'GEE WILLIAM	25		42	10	
MOOTS DANIEL L.	21		40	19	
MOOTS CONRAD	19		23	10	
NORTON NATHAN	24		44		
REED AMOS	13		12	1	
SAPP JOHN F.	7		23	19	
THARP WILLIAM	22		9	10	
THOMAS JOHN	22		20	1	



SCALE 1"=20'

LEGEND  
 SEC=SECTION L=LOT R=ROW  
 G=GRAVE W=WAR  
 X=POSITION UNKNOWN

C-5  
 ZANESFIELD 1.2 MI.

**THORPS RUN CEMETERY**

LOGAN CO. JEFFERSON TWP.

OFFICIAL PROJECT NOS. 465-4-3-467 & 665-42-3-232

LEGEND	HISTORY
① REVOLUTIONARY WAR	
⑩ WAR OF 1812	
⑯ WAR WITH MEXICO	
⑰ CIVIL WAR	
⑳ SPANISH-AM. WAR	
㉑ WORLD WAR	

SCALE 1"=20' 1. ACRE

46-4-4



NAME	SEC	L	R	G	W
ANTRIM GEORGE	OLD	126		7	19
BALES N V	OLD	110		1	19
BLACKBURN MILES V	OLD	36		3	19
BROWN IRA	OLD	18		8	19
BROWN W L	OLD	19		1	19
CARTER HENRY M	OLD	44		3	19
COOPER JOHN L	OLD	120		2	19
DEVINE WILBUR C	OLD	129		3	31
DICKINSON GEORGE W	OLD	47		2	19
DICKINSON JOSEPH	OLD	16		3	10
EASTON JOEL	NEW	4		8	19
EASTON J WILSON	OLD	15		5	19
EASTON WILLIAM	OLD	103 1/2		3	19
EBRITE NATH'L P	OLD	33		5	19
EVERINGHAM HENRY	OLD	34		5	19
FAWCETT JESSE			10	18	
FAWCETT NATHAN			10	19	
FILSON T W	OLD	35		8	



NAME	SEC	L	R	G	W
GRUBBS JESSE	OLD	107		3	19
HENRY DAVID	OLD	77		7	19
HILL RODERICK D	OLD	138		7	19
HULSIZER ABRAHAM	OLD	124		3	19
JACOBS NATHANIEL P	OLD	9		6	19
JOHNSON HENRY B	OLD	78		2	19
KINNEY JOHN E	OLD	101		3	19
LISBY BENJAMIN	OLD	87		7	19
LISBY JOHN	OLD	87		8	19
M'CORMICK JOHN	OLD	21		4	19
MILLER HENRY C	OLD	65		8	19
MOORE JAMES A	OLD	77		4	19
MULLEN ROBERT	OLD	45		7	19
PAGE HARRY T	NEW	6		8	31
PETERS BENJAMIN	H-S	3		4	31
REAMES CALEB	OLD	92		8	19
REAMES CHAS W	OLD	95		7	19
REAMES JOSHUA M	OLD	22		3	19
REAMES SOLOMON	OLD	3		7	19
ROCKWELL GEORGE	OLD	5		4	19
SCOTT B S	OLD		8	1	19
SCOTT CHARLES	OLD	39		5	19
SHAFFER ALEXANDER	OLD	69		1	19
SHERBURN LAFAYETTE	OLD	131		4	19
SLOAN JOHN			2	20	10
SMITH S B	OLD	29		3	
THOMPSON AMOS	OLD		5	1	19
TOWNSEND WESLEY	OLD	90		4	19
VAUGHN SAMUEL T	OLD	108		1	19
WICKERSHAM THOS.	OLD	85		2	19
WILLIAMS JAMES T	OLD	100		4	19
WONDERS JACOB	OLD	2		3	10



LEGEND  
 SEC=SECTION L=LOT R=ROW  
 G=GRAVE W=WAR  
 \*=POSTION UNKNOWN  
 H.S.=HICKSITE SECTION

**ZANESFIELD CEMETERY**  
 LOGAN CO. JEFFERSON TWP.  
 OFFICIAL PROJECT NOS.465-42-3-467&665-42-3-232

LEGEND	HISTORY
① REVOLUTIONARY WAR	
⑩ WAR OF 1812	
⑯ WAR WITH MEXICO	
⑳ CIVIL WAR	
㉑ SPANISH AM. WAR	
㉓ WORLD WAR	
SCALE 1"=20'	4.18 ACRES



NAME	SEC	L	R	G	W
CRAWFIS JAMES JR.	3		9		
GORDON JOSEPH	8		3	1	
MC PHERSON JAMES	7		15	1	

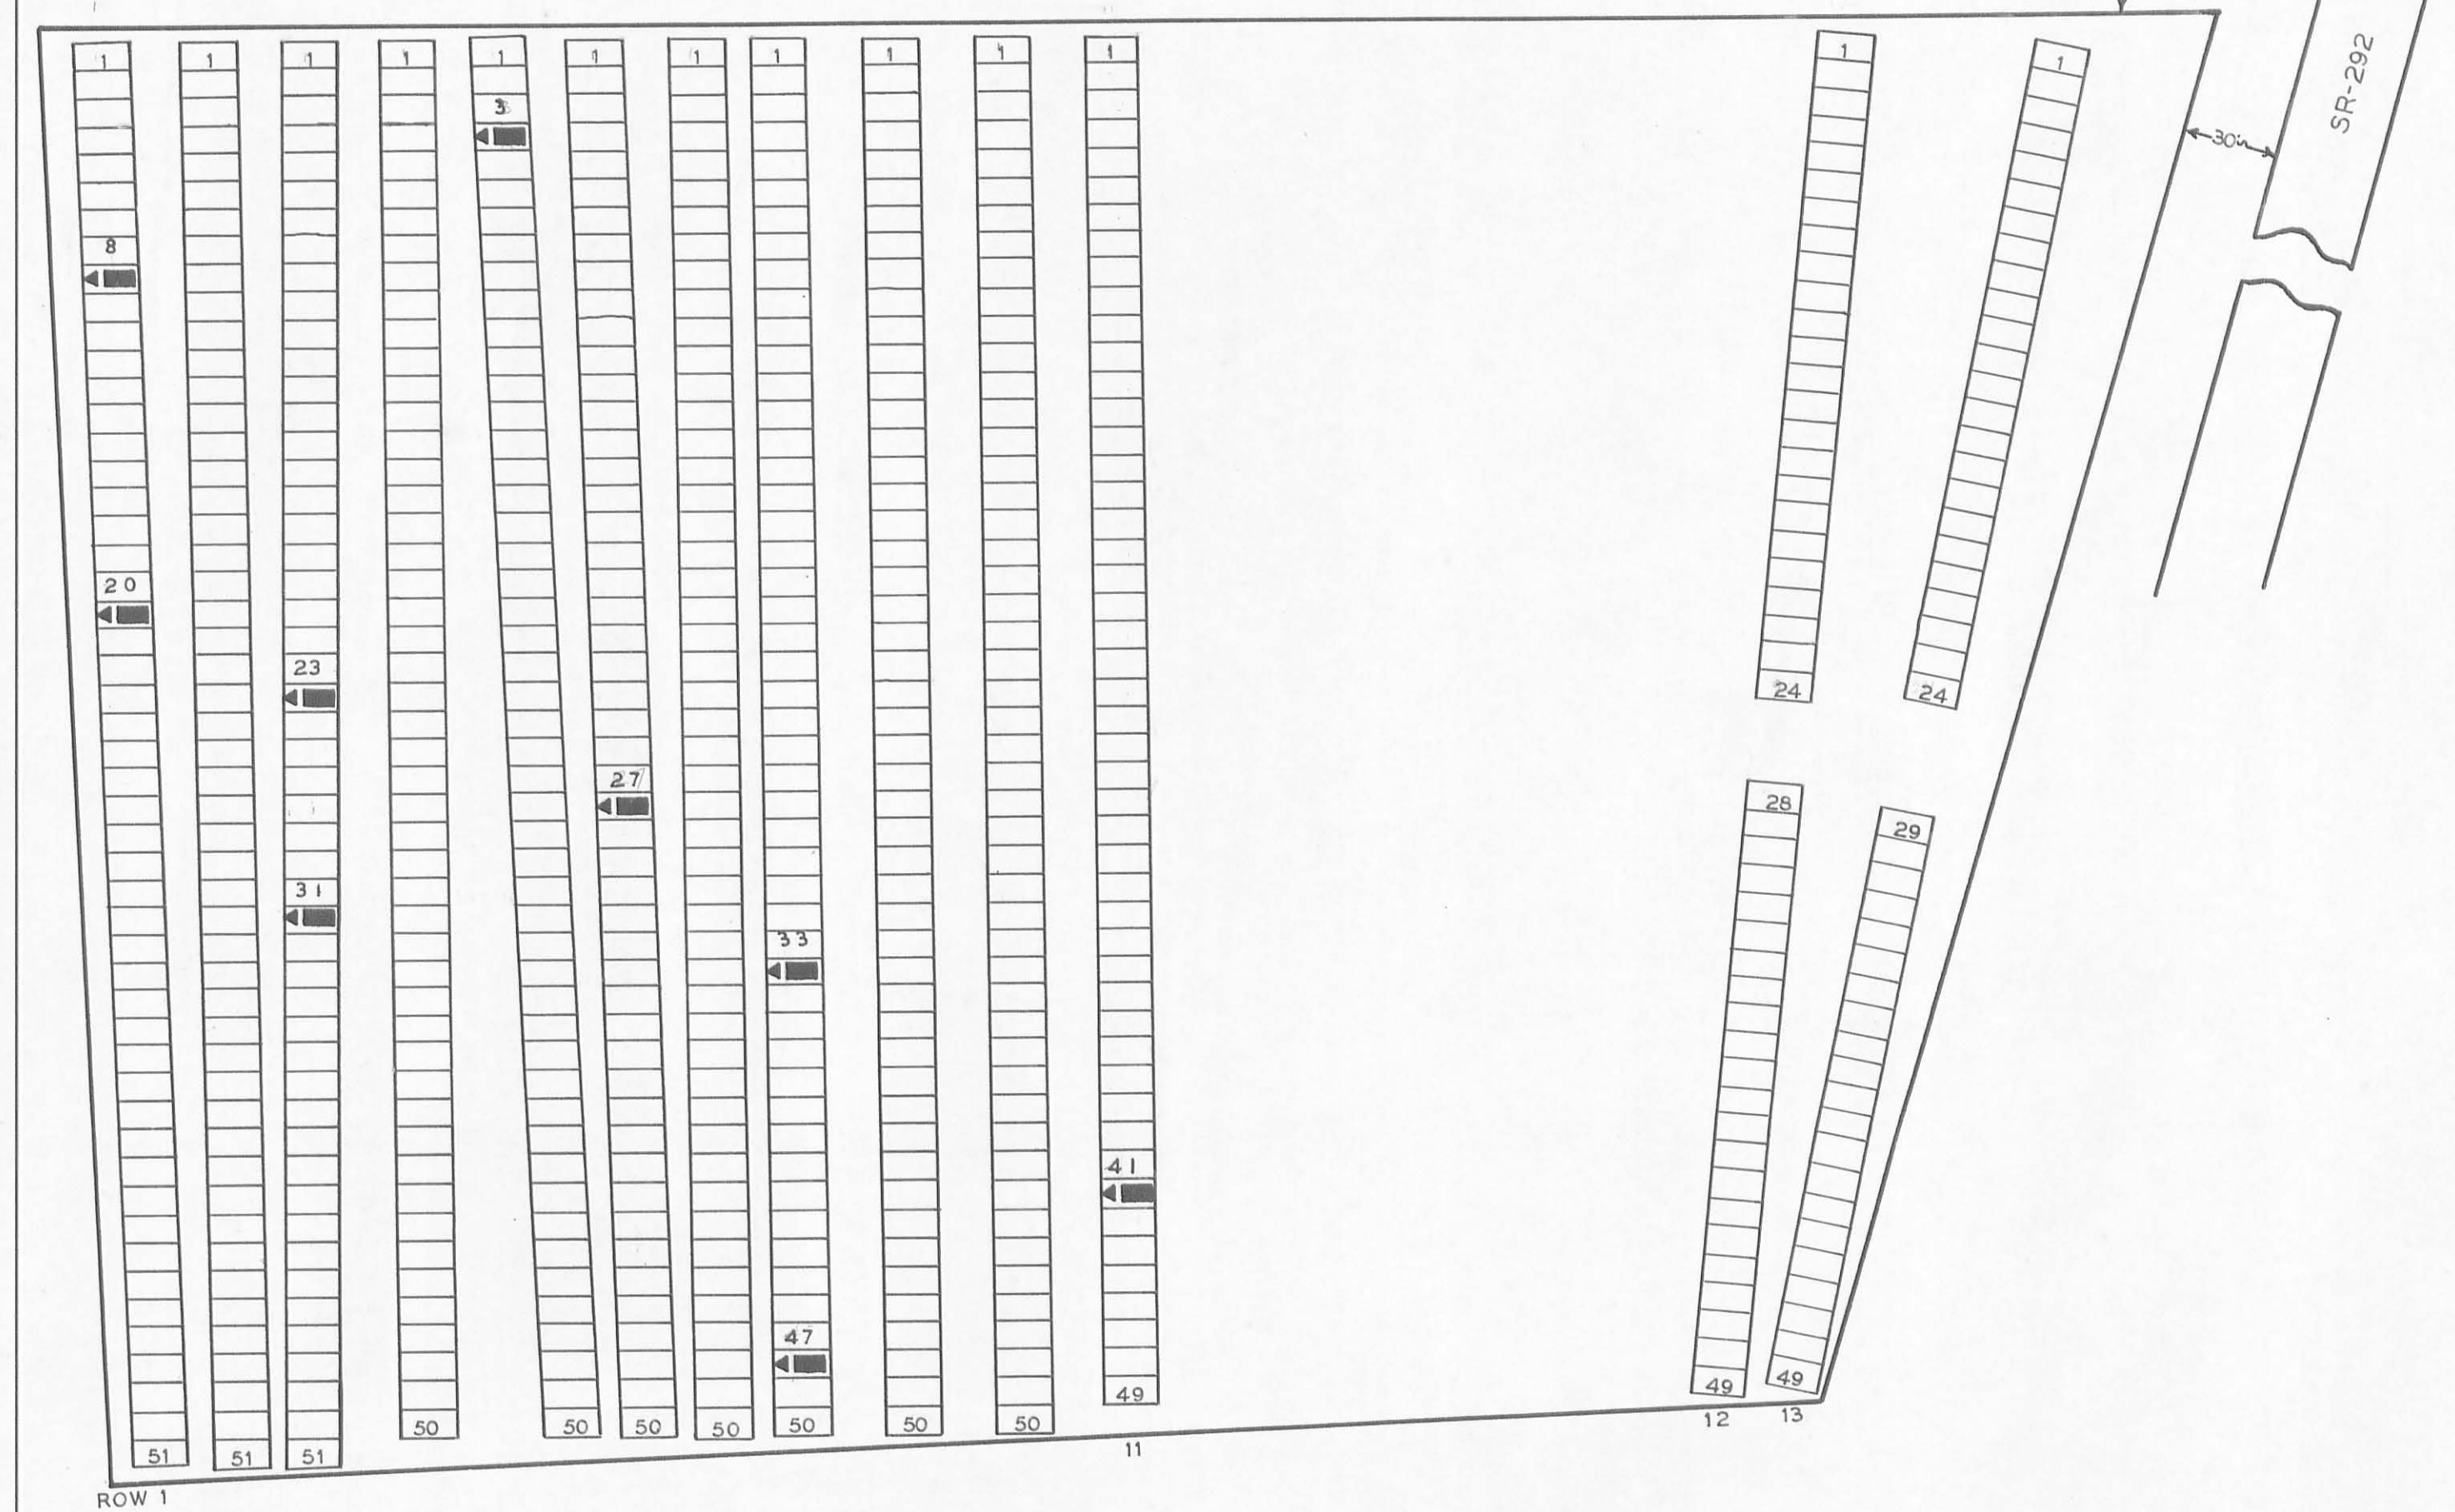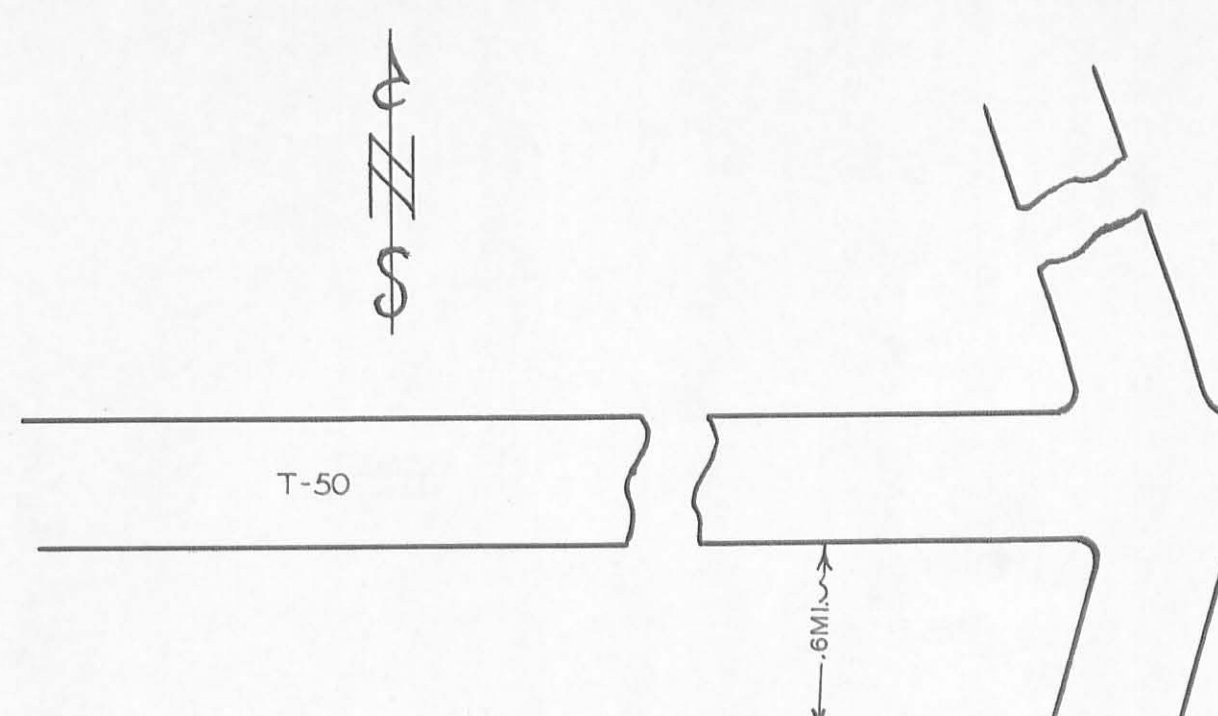

NAME	SEC	L	R	G	W
BUSHONG R. C.	8		28	19	
CALLAHAN JOHN	1		21	19	
CLINE SAMUEL	6		28		
DOWNARD WM.	11		42	19	
HIGGINS JOHN	1		9	19	
LEVALLEY JOSEPH H.	5		4		
MONROE J. J.	3		24	19	
WILLOW JOHN	3		32	19	
WILLOW MYRON					

LEGEND  
 SEC=SECTION L=LOT R=ROW  
 G=GRAVE W=WAR  
 X=POSITION UNKNOWN

### GOOD HOPE CEMETERY

LOGAN CO. BOKES CREEK TWP

OFFICIAL PROJECT NOS. 465-42-3-467 & 665-42-3-232

LEGEND	HISTORY
① REVOLUTIONARY WAR	A PART OF LAND GRANTED TO R. MADISON
⑩ WAR OF 1812	BY U.S. GOVERNMENT
⑯ WAR WITH MEXICO	IN 1819 CEMETERY
⑲ CIVIL WAR	EXISTED IN 1851
⑳ SPANISH-AM. WAR	
㉑ WORLD WAR	

SCALE 1"=20'
1 ACRE

46-2-1



LEGEND  
 SEC=SECTION L=LOT R=ROW  
 G=GRAVE W=WAR  
 X=POSITION UNKNOWN

### LOGAN CO. HOME CEMETERY

LOGAN CO. HARRISON TWP

OFFICIAL PROJECT NOS. 465-42-3-467 & 665-42-3-232

LEGEND	HISTORY
① REVOLUTIONARY WAR	FIRST BURIAL IN 1812
⑩ WAR OF 1812	SECOND BURIAL IN
⑯ WAR WITH MEXICO	1820 FROM HISTORY
⑲ CIVIL WAR	OF LOGAN CO.
⑳ SPANISH-AM. WAR	
㉑ WORLD WAR	

SCALE 1"=20'
.7 ACRE





46-3-4



NAME SEC L R G W

POWELL, WILLIAM 1 28 1

TULLIS, JOHN 2 29 1

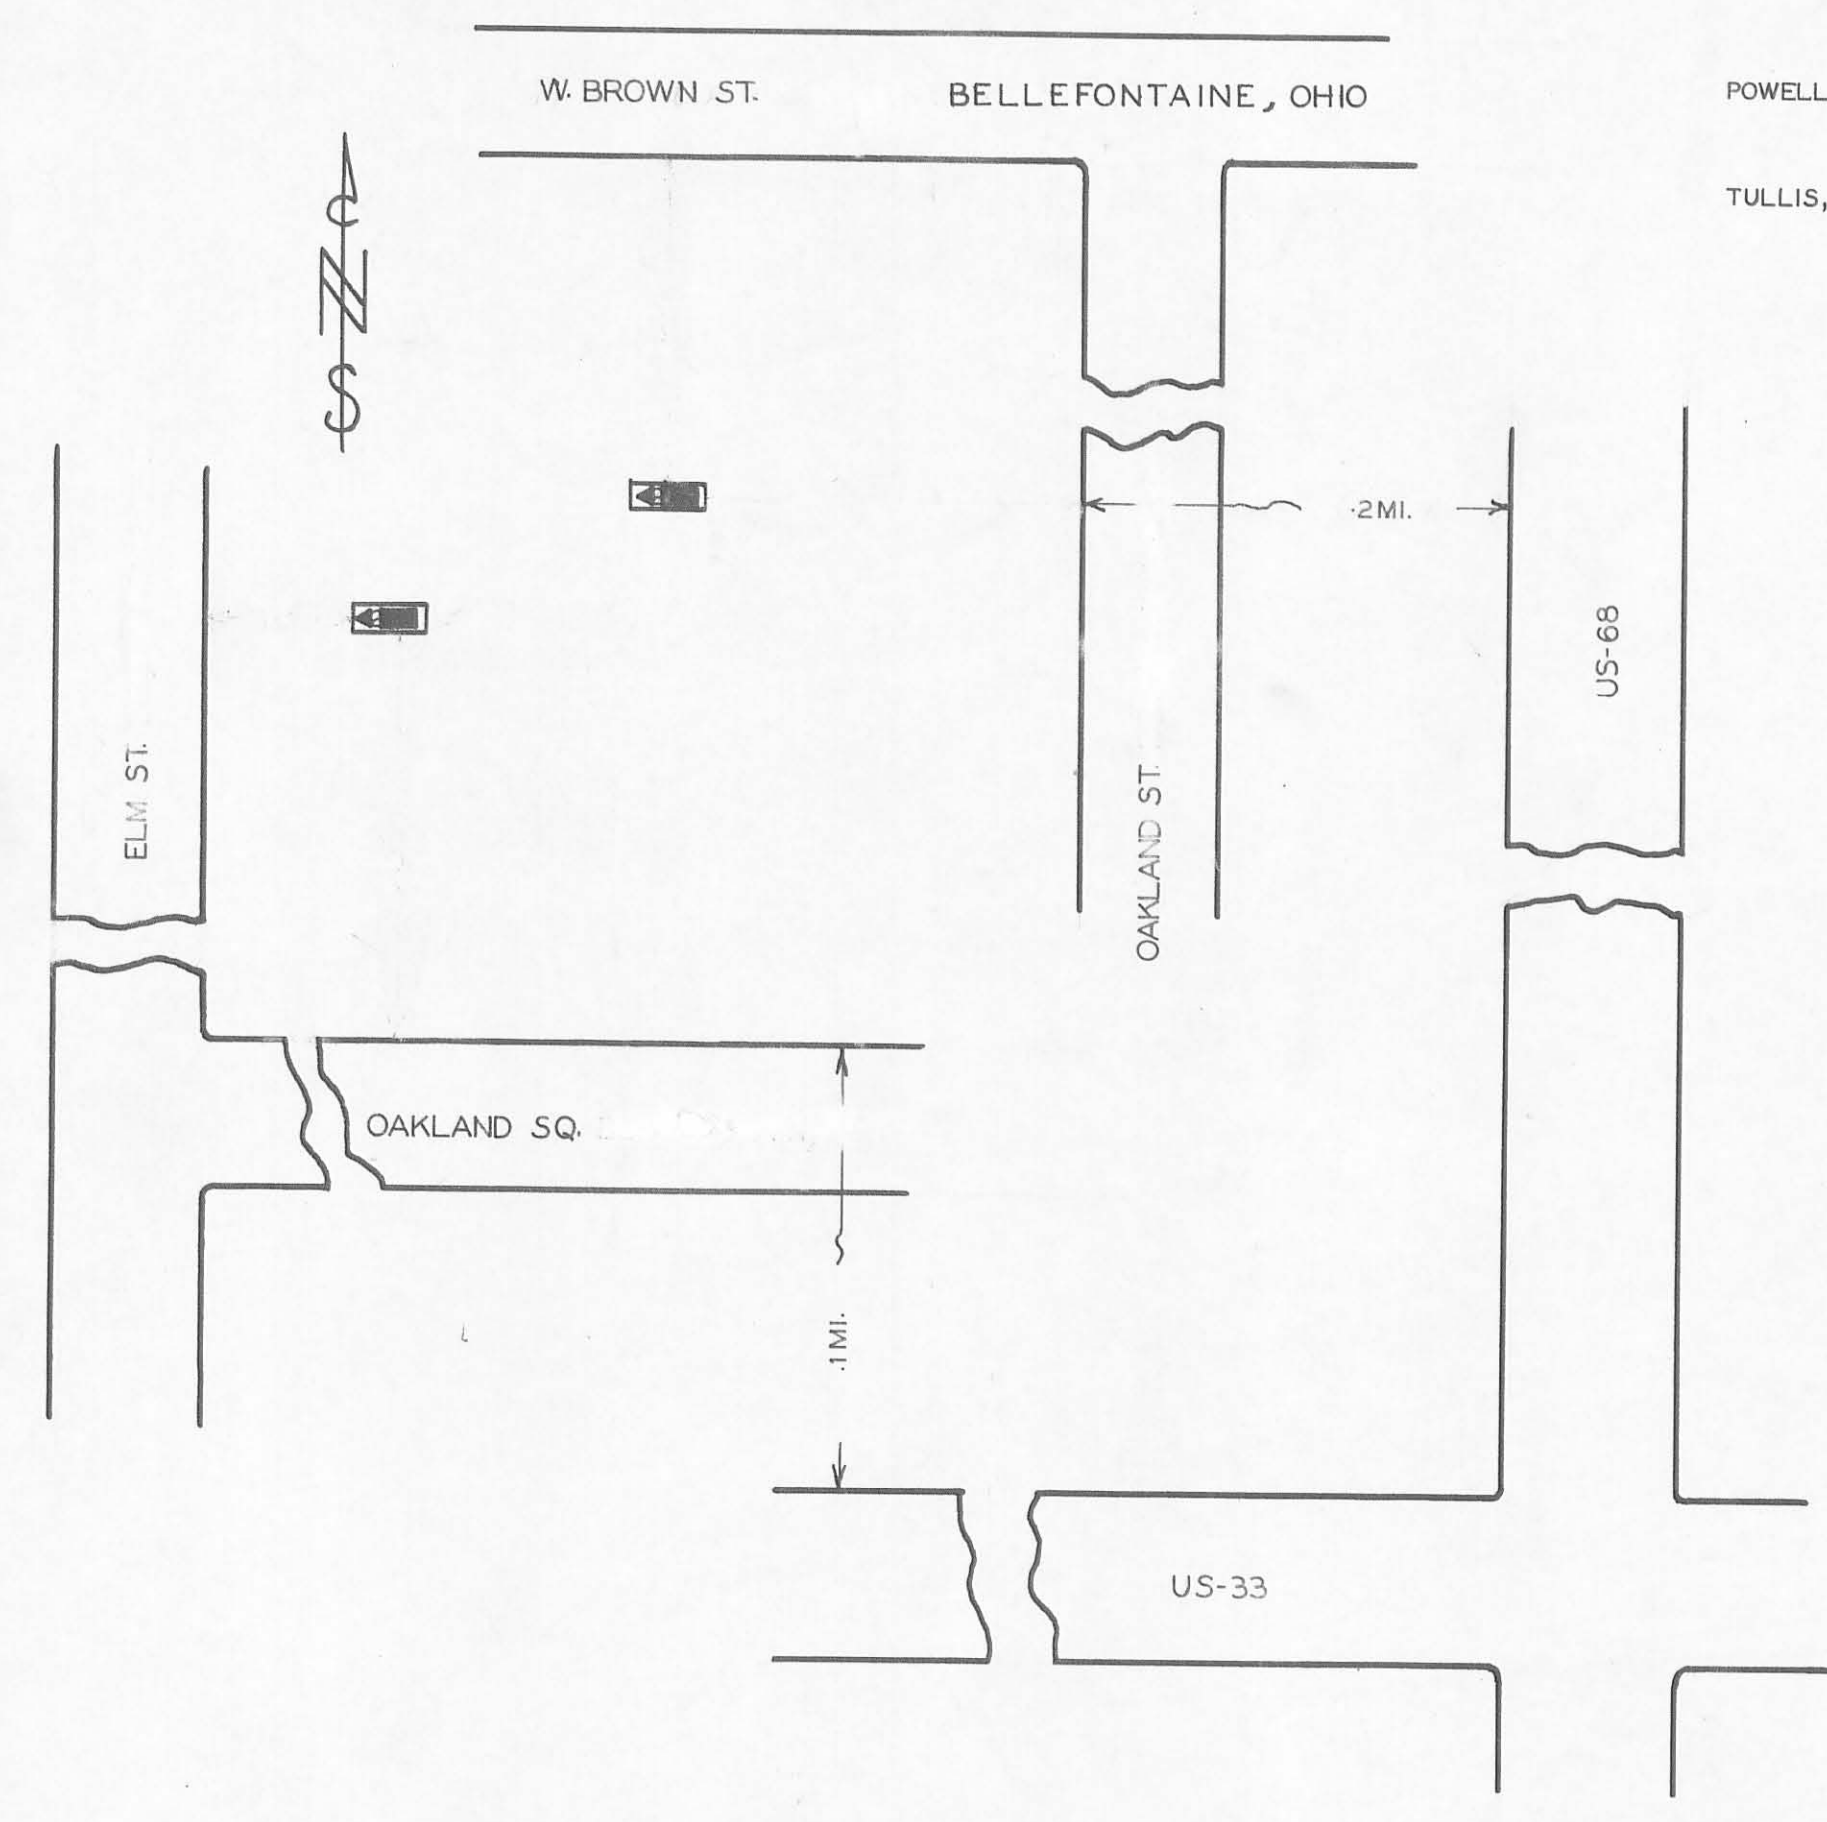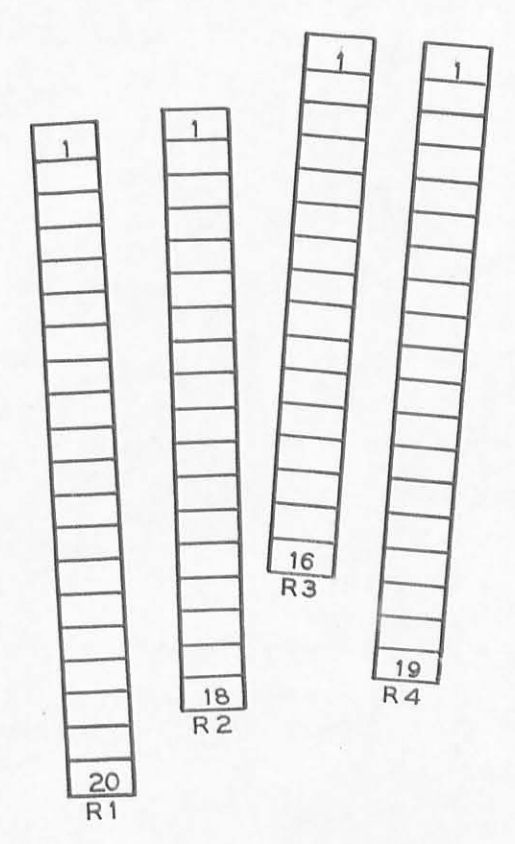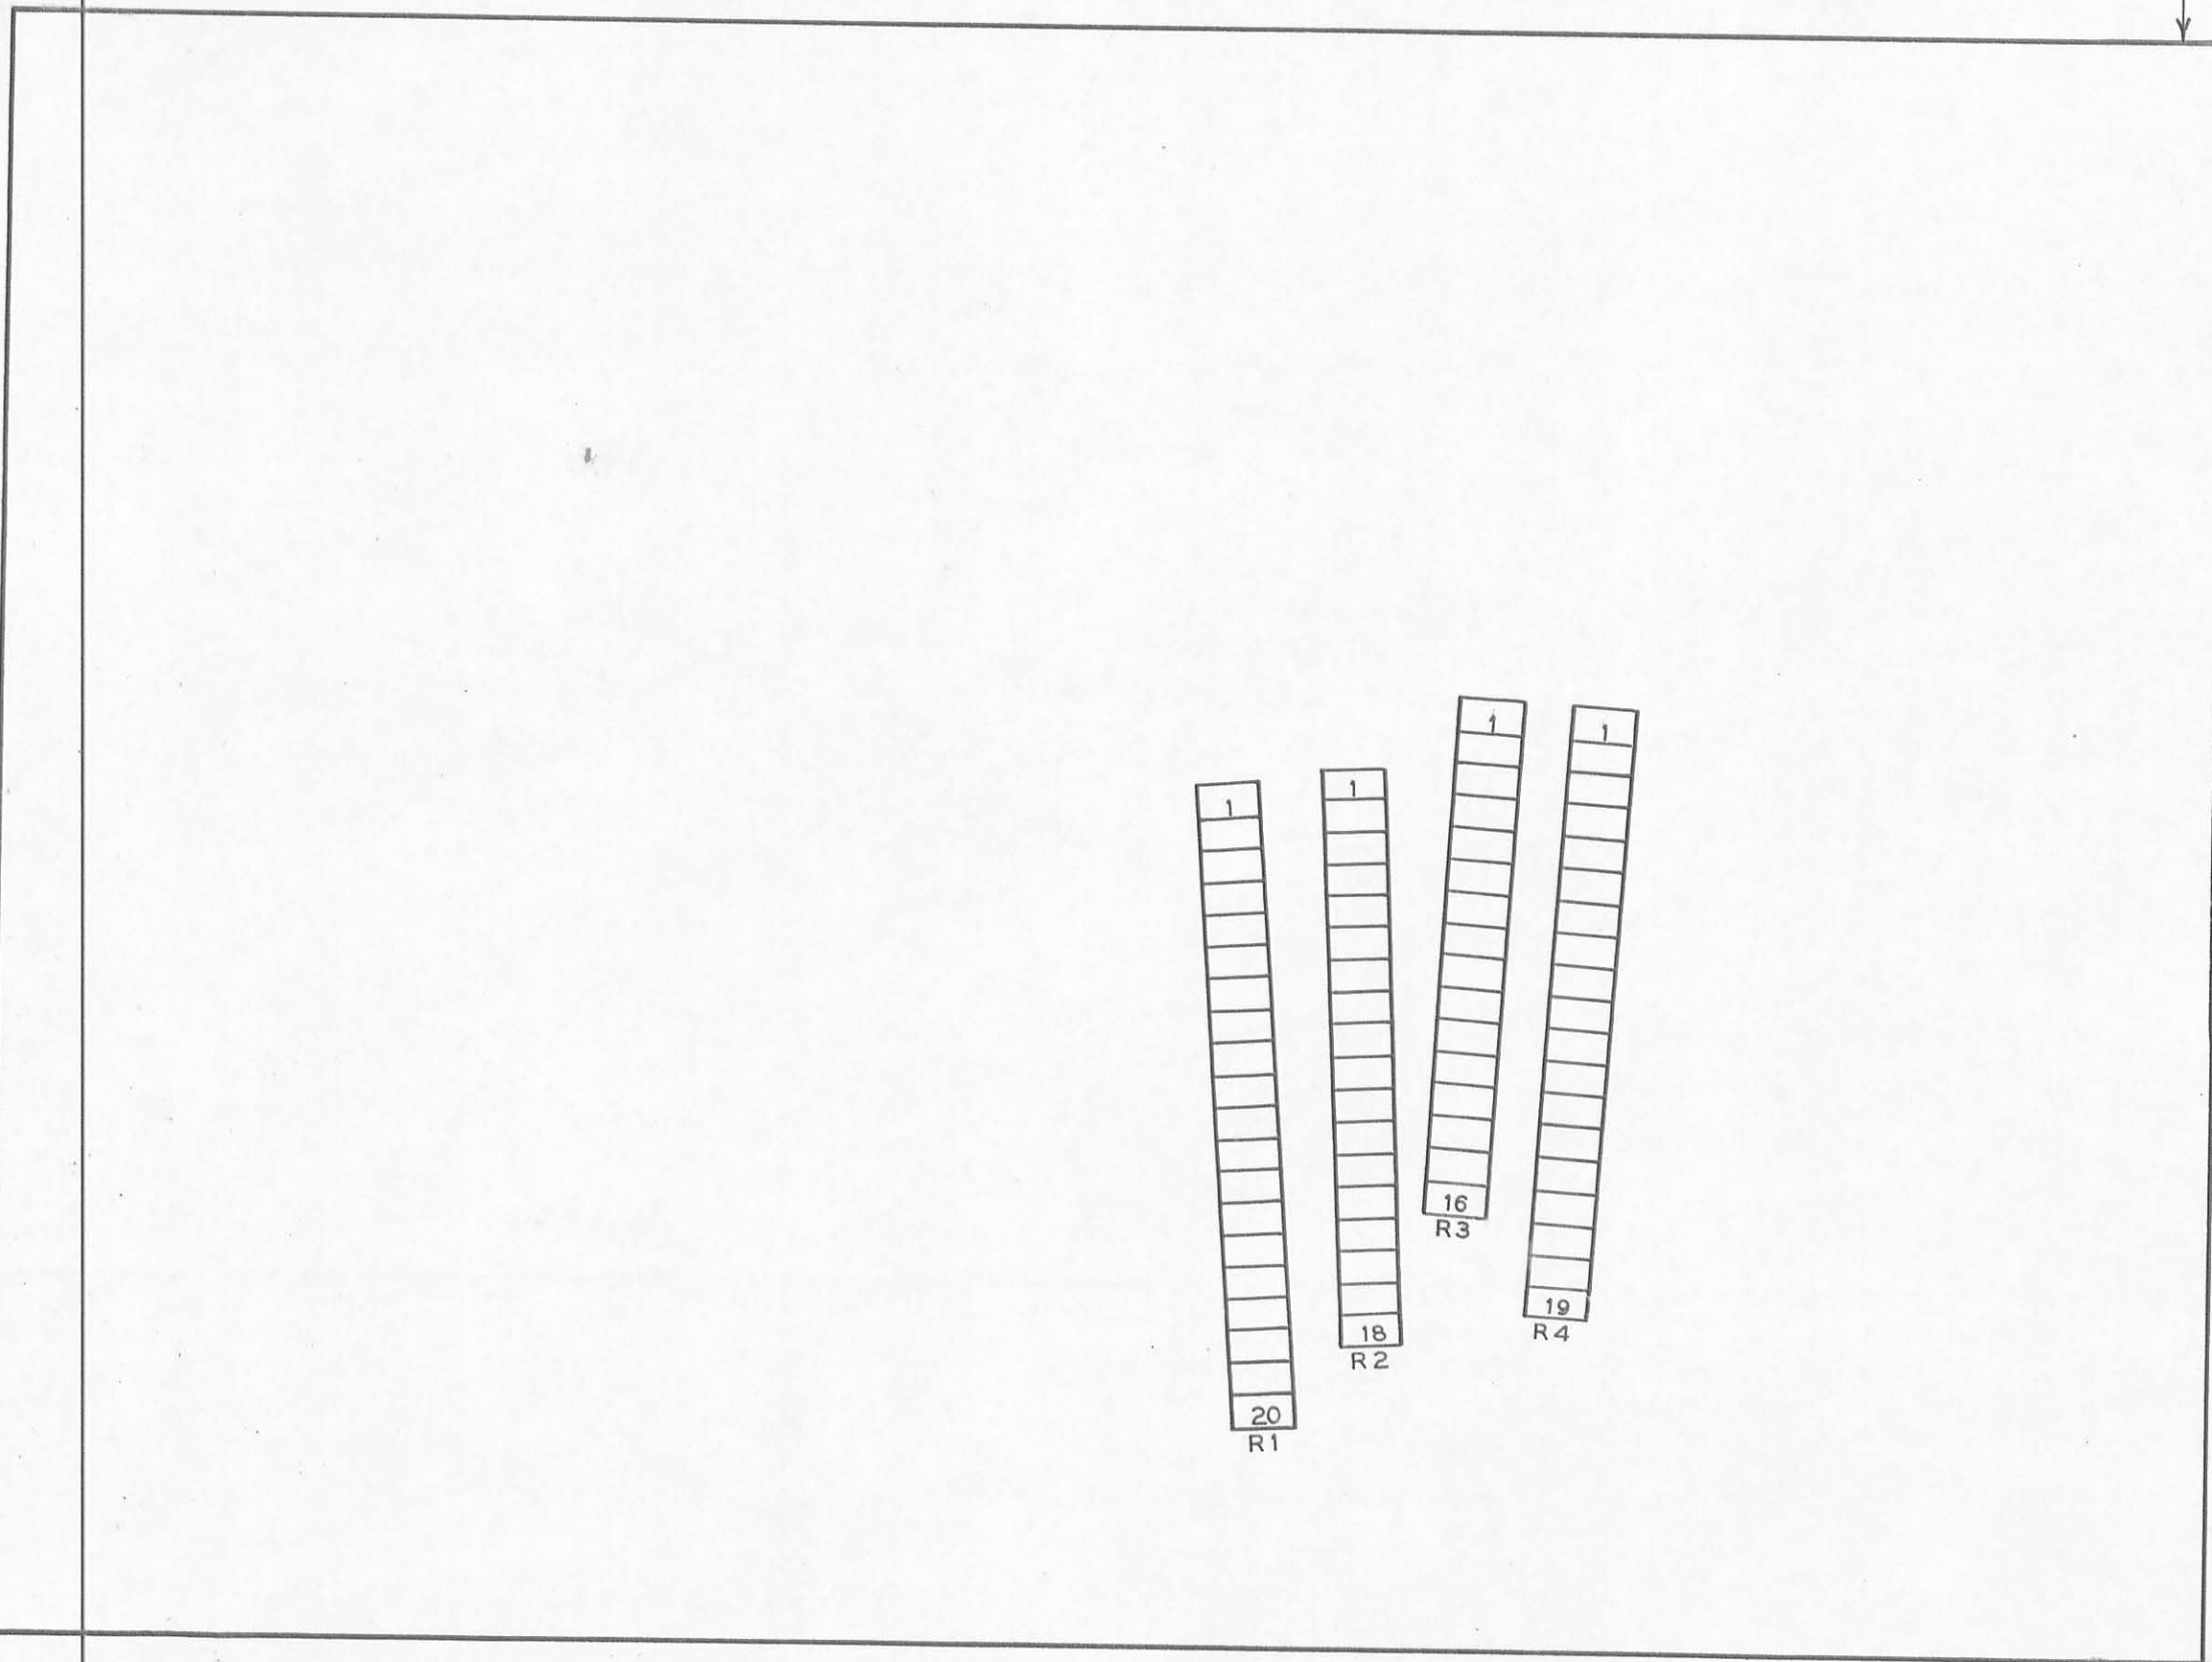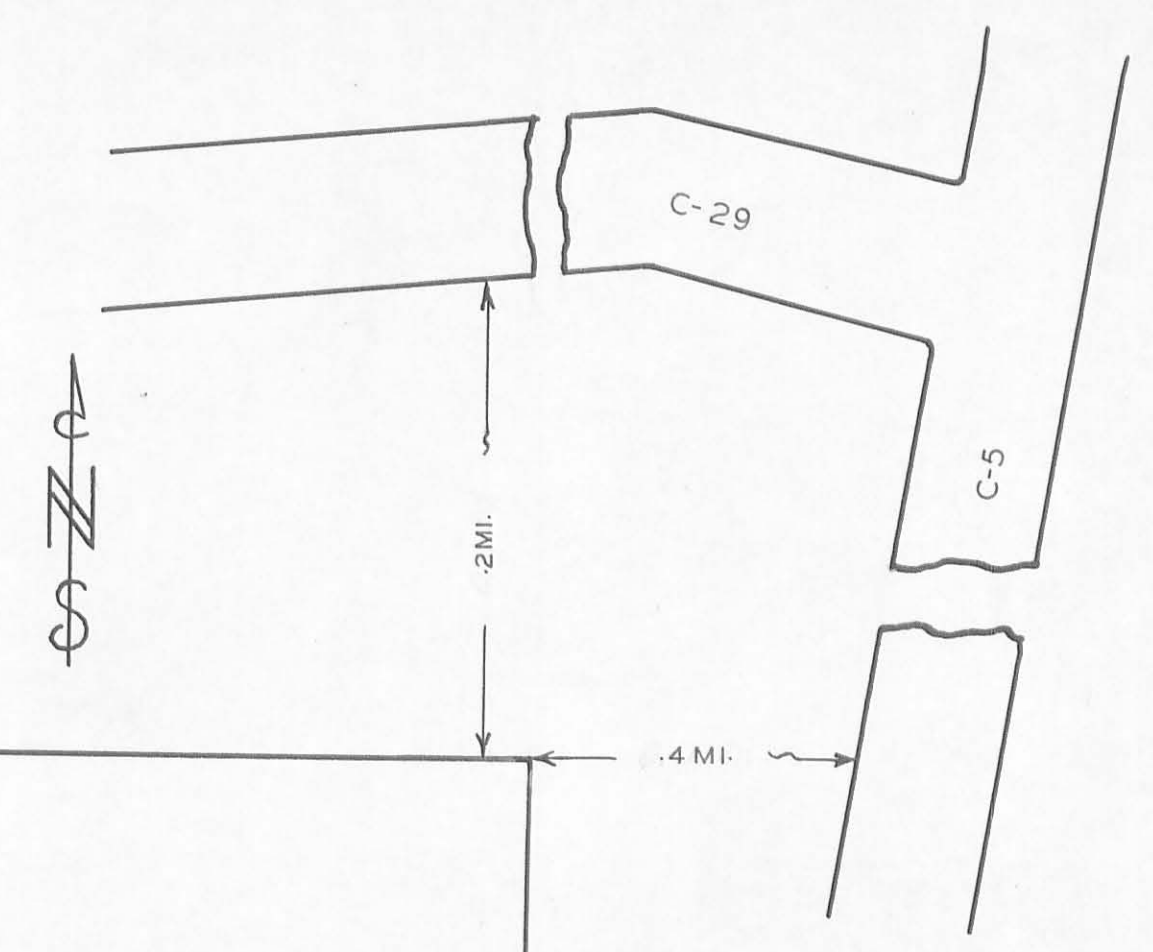


LEGEND  
 SEC=SECTION L=LOT R=ROW  
 G=GRAVE W=WAR  
 X=POSITION UNKNOWN

**POWELL PARK CEMETERY**  
 LOGAN CO. LAKE TWP.  
 OFFICIAL PROJECT NOS. 465-42-3-467 & 665-42-3-232

LEGEND	HISTORY
①	REVOLUTIONARY WAR
⑩	WAR OF 1812
⑯	WAR WITH MEXICO
⑲	CIVIL WAR
⑳	SPANISH-AM. WAR
㉑	WORLD WAR

SCALE 1"=20' .01 ACRE

46-5-4

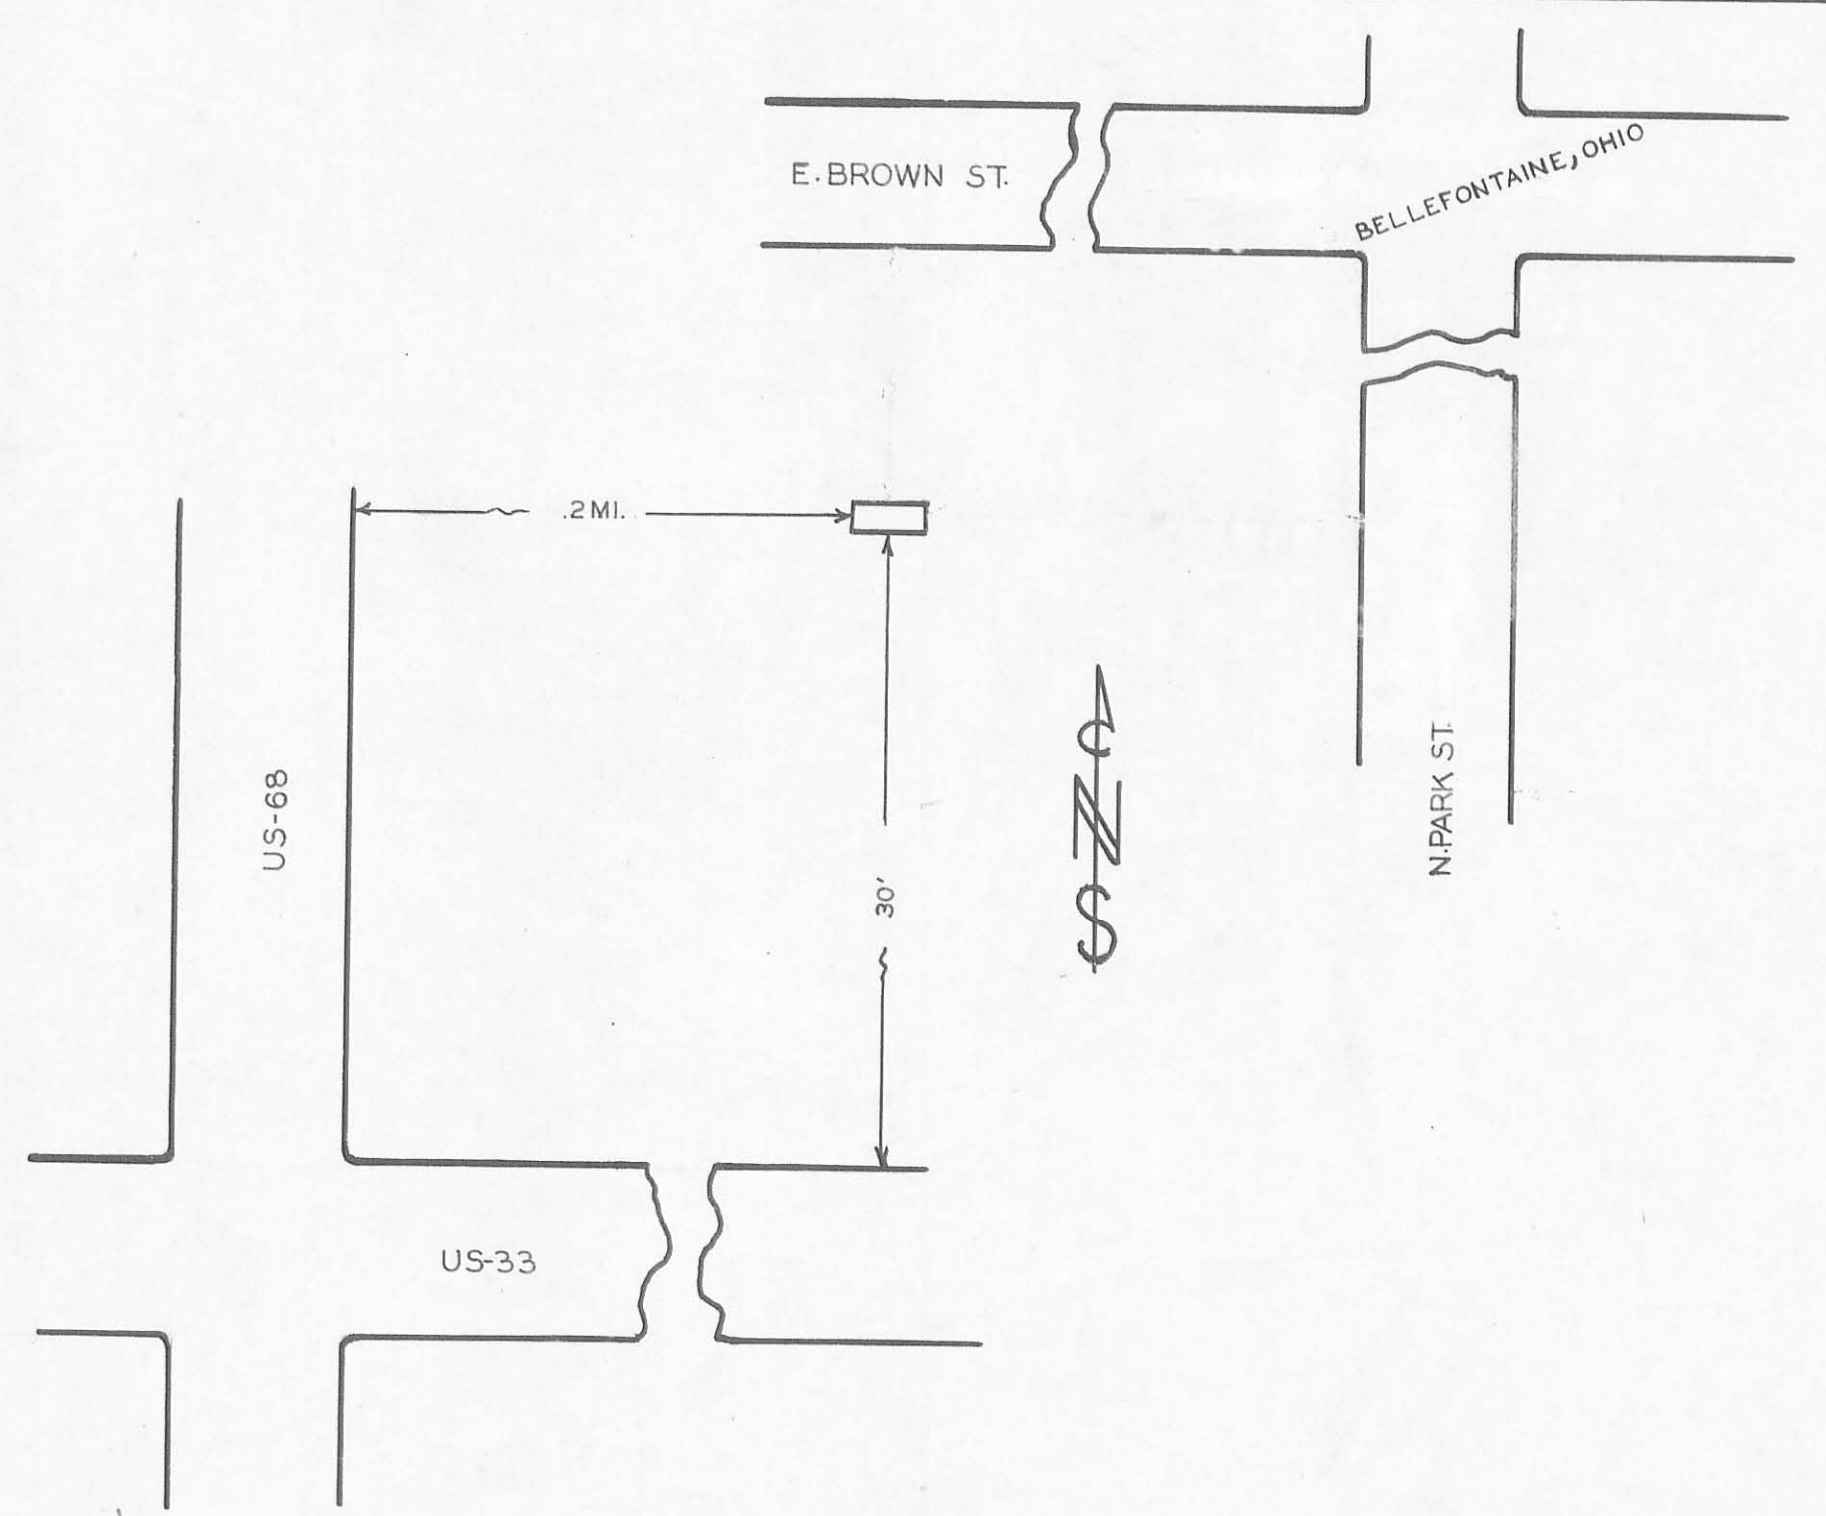

LEGEND  
 SEC=SECTION L=LOT R=ROW  
 G=GRAVE W=WAR  
 X=POSITION UNKNOWN

**BROWN PARK CEMETERY**  
 LOGAN CO. LAKE TWP.  
 OFFICIAL PROJECT NOS. 465-42-3-467 & 665-42-3-232

LEGEND	HISTORY
①	REVOLUTIONARY WAR
⑩	WAR OF 1812
⑯	WAR WITH MEXICO
⑲	CIVIL WAR
⑳	SPANISH-AM. WAR
㉑	WORLD WAR

SCALE 1"=20' .01 ACRES

46-5-5

**MCCOLLOUGH FARM CEMETERY**  
 LOGAN CO. MONROE TWP.  
 OFFICIAL PROJECT NOS. 465-42-3-467 & 665-42-3-232


LEGEND	HISTORY
①	REVOLUTIONARY WAR
⑩	WAR OF 1812
⑯	WAR WITH MEXICO
⑲	CIVIL WAR
⑳	SPANISH-AM. WAR
㉑	WORLD WAR

SCALE 1"=20' 1. ACRE

46-9-8

LEGEND  
 SEC=SECTION L=LOT R=ROW  
 G=GRAVE W=WAR  
 X=POSITION UNKNOWN



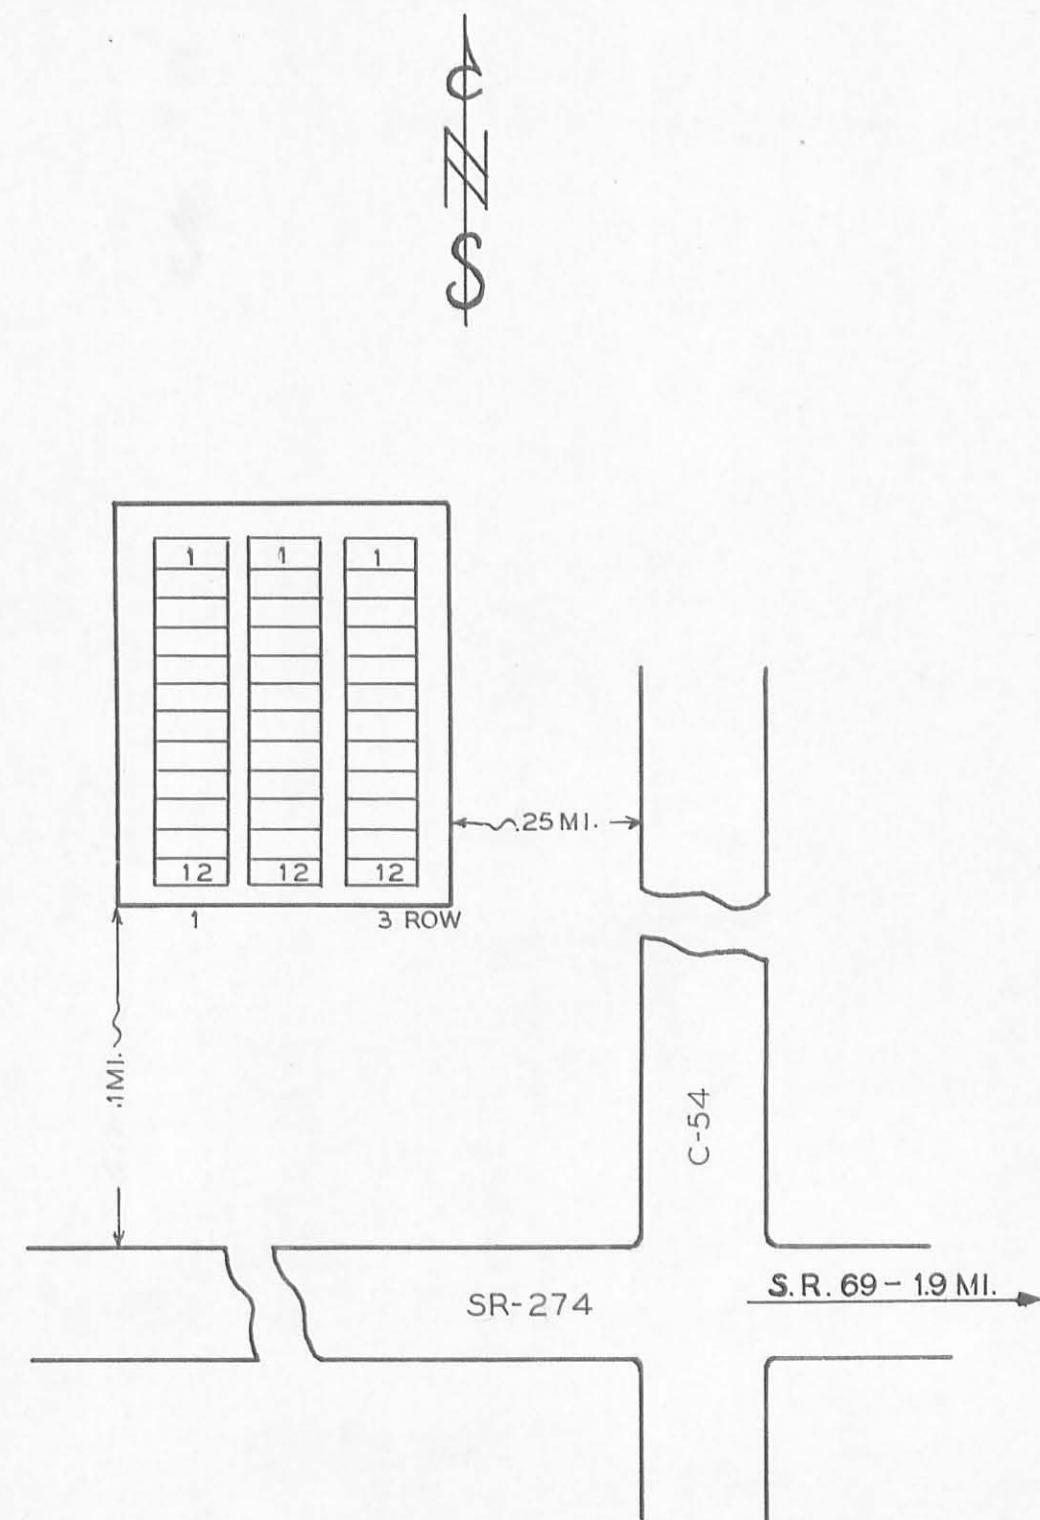

LEGEND  
 SEC=SECTION L=LOT R=ROW  
 G=GRAVE W=WAR  
 X=POSITION UNKNOWN

**PENCE  
 CEMETERY**


LOGAN CO. BLOOMFIELD TWP

OFFICIAL PROJECT NOS. 465-42-3-467 & 665-42-3-232

<p>LEGEND</p> <p>① REVOLUTIONARY WAR</p> <p>⑩ WAR OF 1812</p> <p>⑮ WAR WITH MEXICO</p> <p>⑲ CIVIL WAR</p> <p>⑳ SPANISH-AM. WAR</p> <p>㉑ WORLD WAR</p>	<p>HISTORY</p>
---	----------------

.03 ACRE

46-1-3

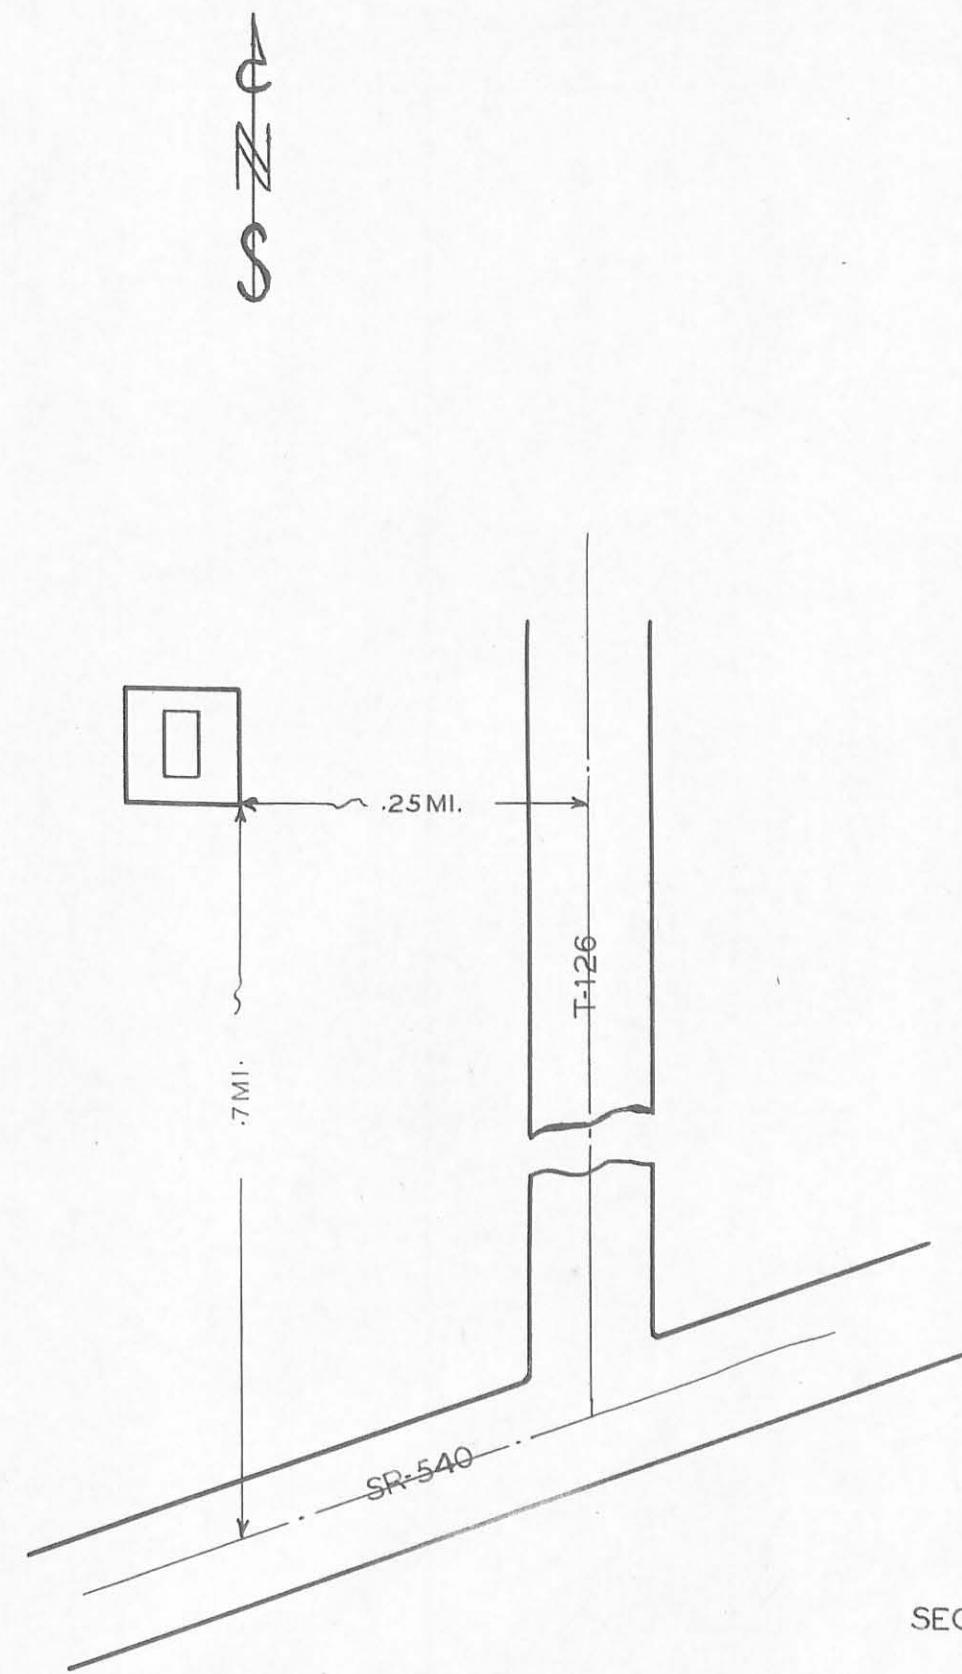

LEGEND  
 SEC=SECTION L=LOT R=ROW  
 G=GRAVE W=WAR  
 X=POSITION UNKNOWN

**WICKERSHAM  
 CEMETERY**


LOGAN CO. JEFFERSON TWP

OFFICIAL PROJECT NOS. 465-42-3-467 & 665-42-3-232

<p>LEGEND</p> <p>① REVOLUTIONARY WAR</p> <p>⑩ WAR OF 1812</p> <p>⑮ WAR WITH MEXICO</p> <p>⑲ CIVIL WAR</p> <p>⑳ SPANISH-AM. WAR</p> <p>㉑ WORLD WAR</p>	<p>HISTORY</p>
---	----------------

.01 ACRE

46-4-12

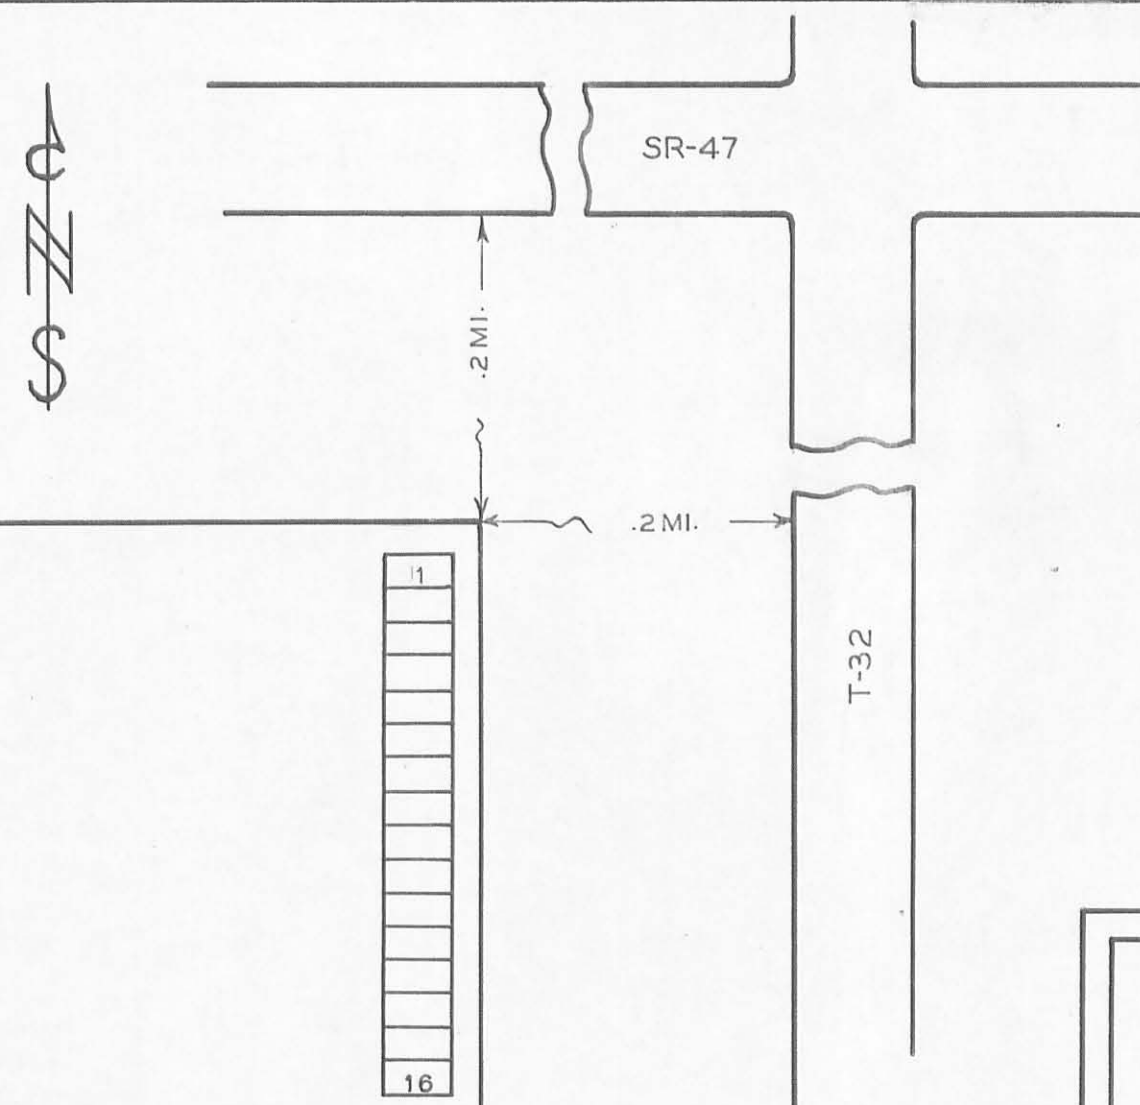

LEGEND  
 SEC=SECTION L=LOT R=ROW  
 G=GRAVE W=WAR  
 X=POSITION UNKNOWN

**LOGAN CO. CHILDREN'S HOME  
 CEMETERY**


LOGAN CO. HARRISON TWP

OFFICIAL PROJECT NOS. 465-42-3-467 & 665-42-3-232

<p>LEGEND</p> <p>① REVOLUTIONARY WAR</p> <p>⑩ WAR OF 1812</p> <p>⑮ WAR WITH MEXICO</p> <p>⑲ CIVIL WAR</p> <p>⑳ SPANISH-AM. WAR</p> <p>㉑ WORLD WAR</p>	<p>HISTORY</p>
---	----------------

.5 ACRE

46-3-3

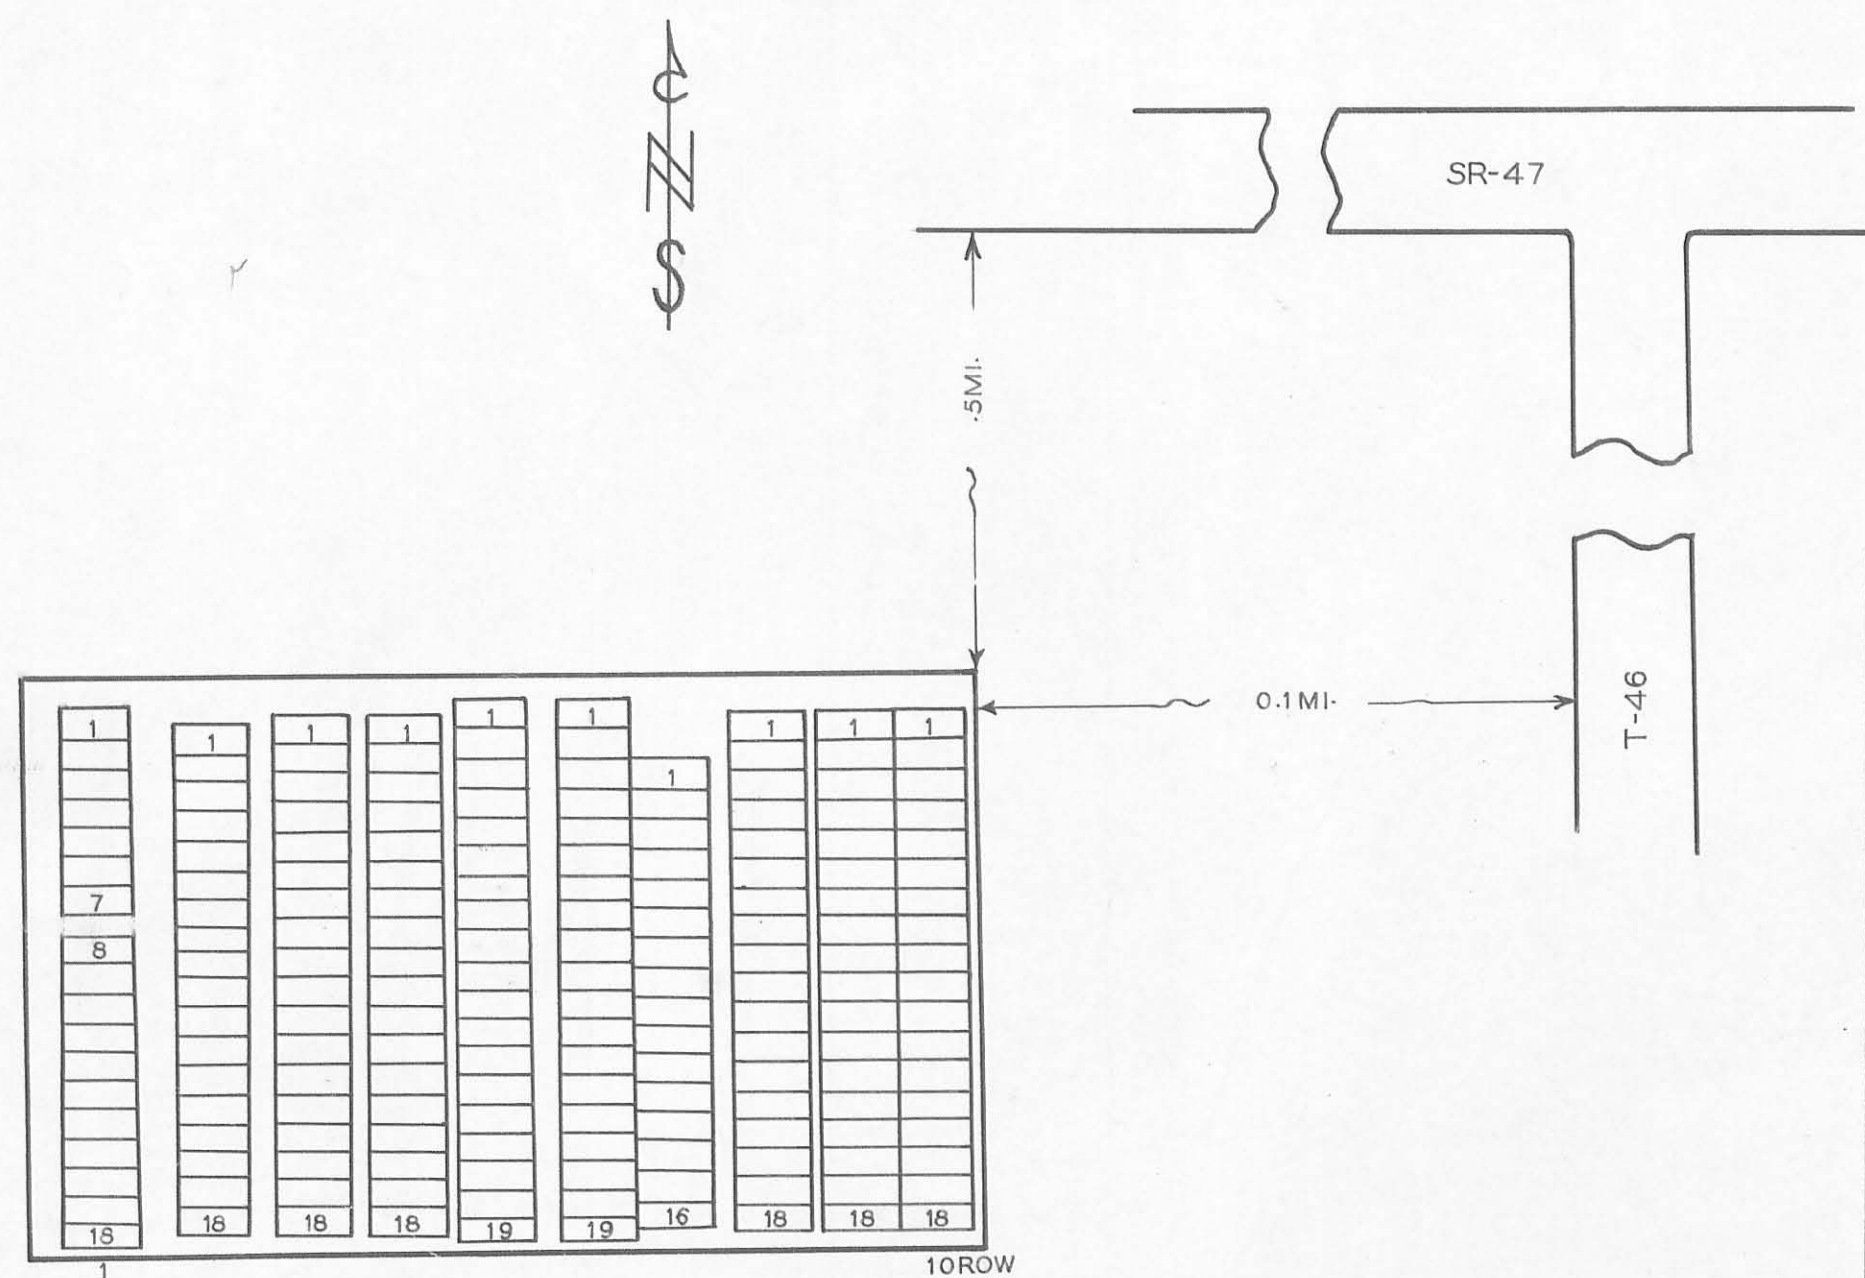

LEGEND  
 SEC=SECTION L=LOT R=ROW  
 G=GRAVE W=WAR  
 X=POSITION UNKNOWN

**TANGER  
 CEMETERY**

LOGAN CO. HARRISON TWP

OFFICIAL PROJECT NOS. 465-42-3-467 & 665-42-3-232

<p>LEGEND</p> <p>① REVOLUTIONARY WAR</p> <p>⑩ WAR OF 1812</p> <p>⑮ WAR WITH MEXICO</p> <p>⑲ CIVIL WAR</p> <p>⑳ SPANISH-AM. WAR</p> <p>㉑ WORLD WAR</p>	<p>HISTORY</p>
---	----------------


.13 ACRE

46-3-6





NAME	SEC	L	R	G	W
FOUGHTY FRANKLIN	2		31		19
HARRINGTON NATHAN J.	3		13		19
MILLER WM. C.	6		35		19
STOKES WALKER	1		7		19

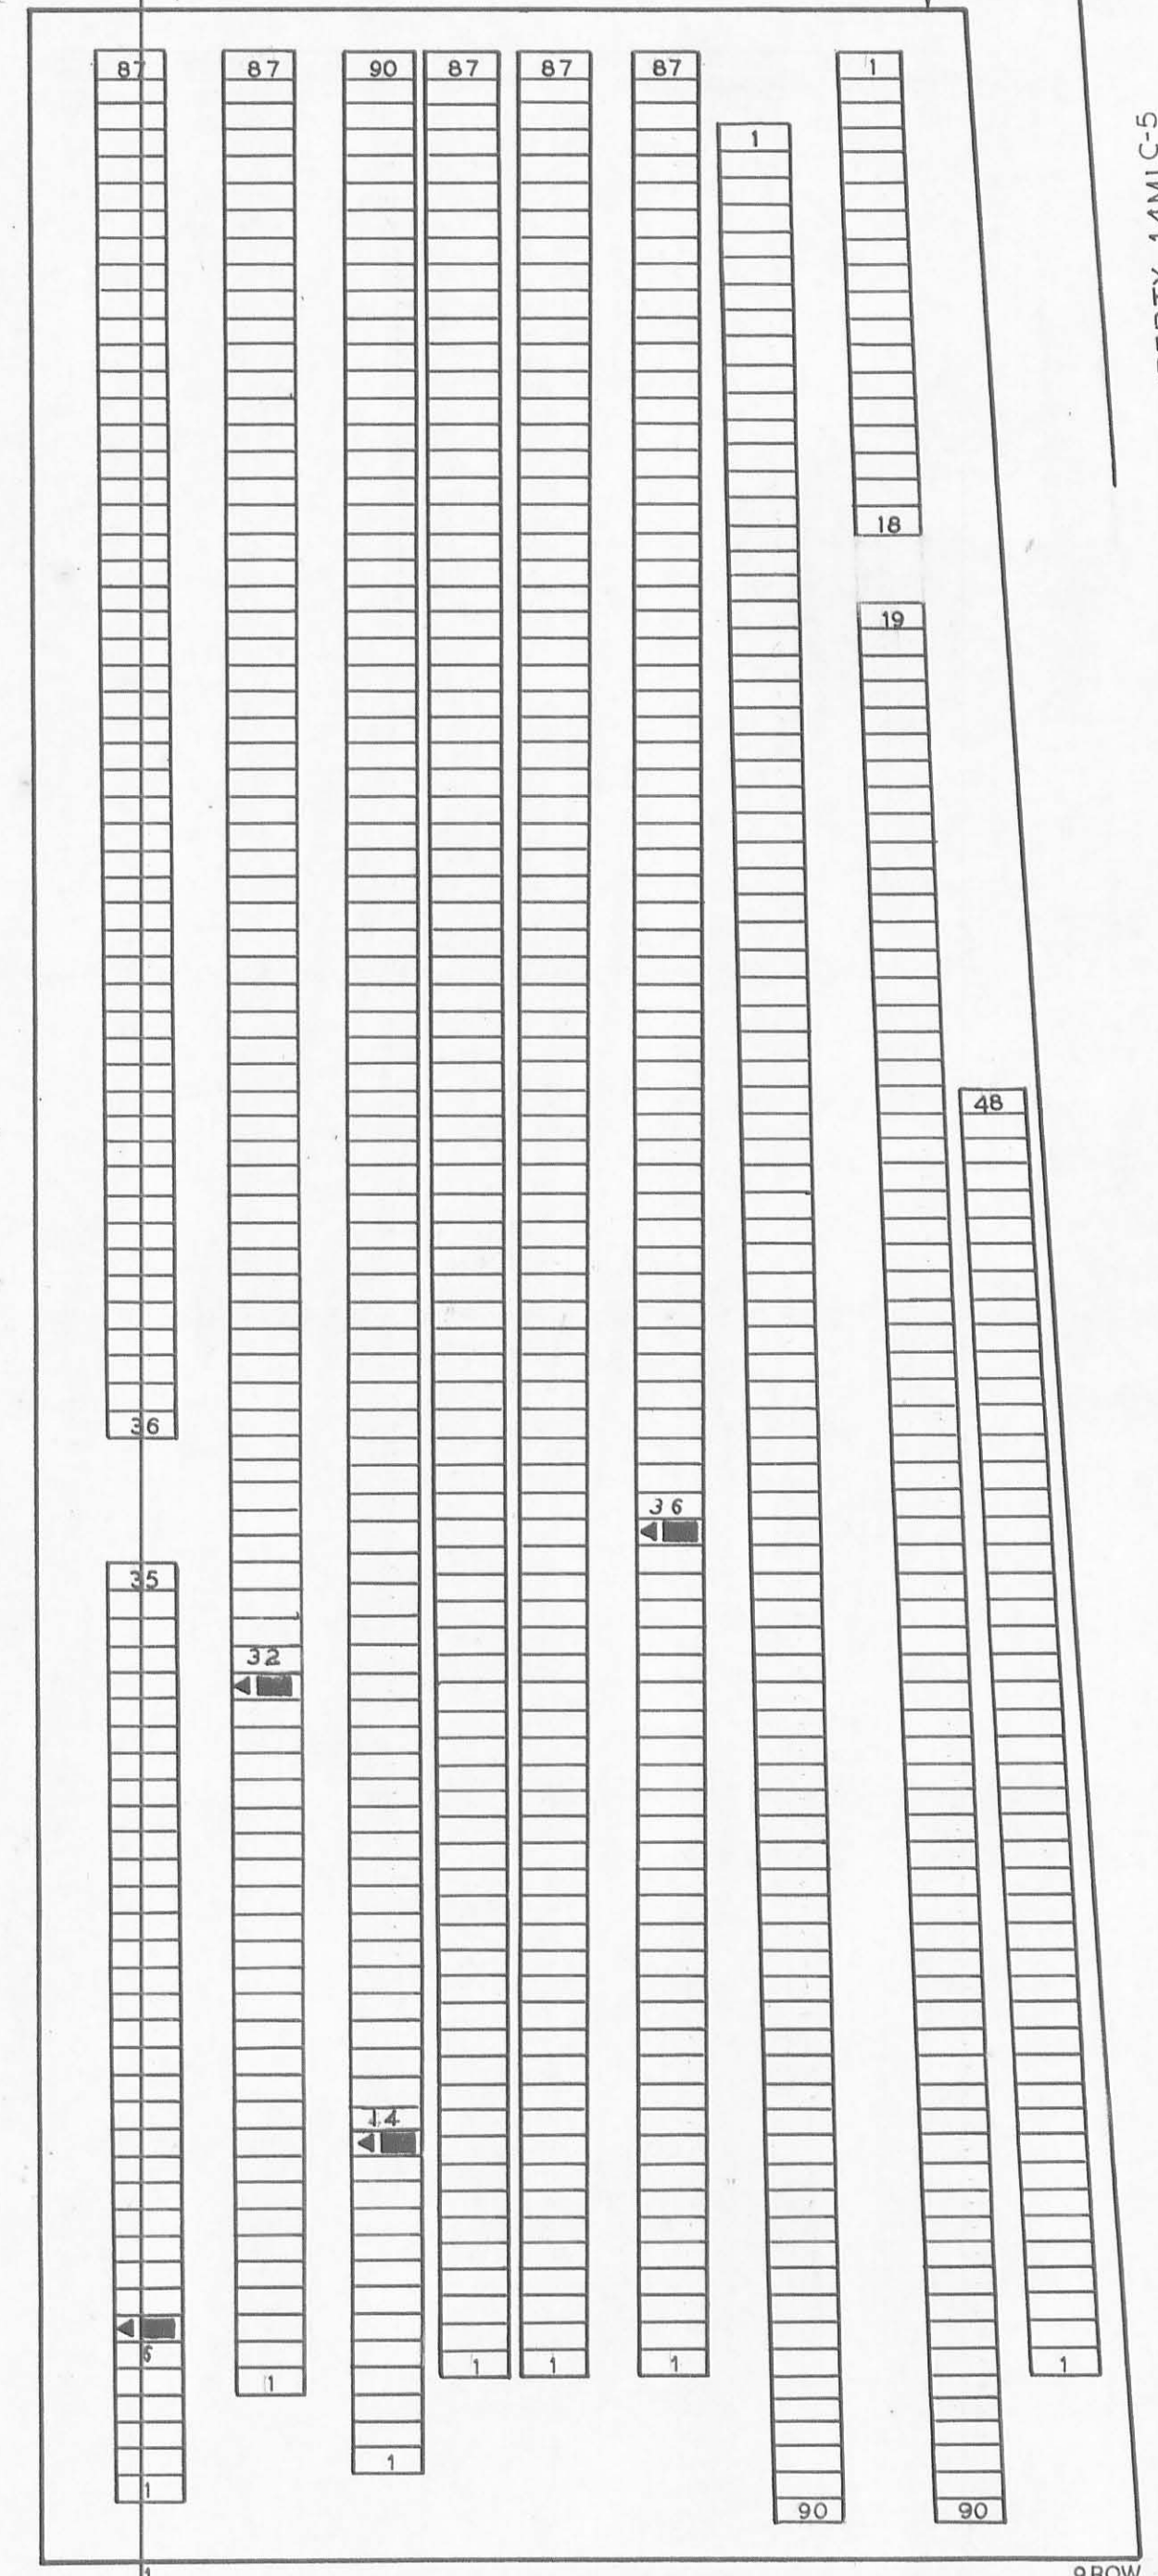

LEGEND  
 SEC=SECTION L=LOT R=ROW  
 G=GRAVE W=WAR  
 X=POSITION UNKNOWN



**HANGER  
 CEMETERY**  
 LOGAN CO. LIBERTY TWP

OFFICIAL PROJECT NOS. 465 42 3 467&665 42 3 232

<b>LEGEND</b>	<b>HISTORY</b>
① REVOLUTIONARY WAR	
⑩ WAR OF 1812	
⑯ WAR WITH MEXICO	
⑲ CIVIL WAR	
⑳ SPANISH-AM. WAR	
㉑ WORLD WAR	

SCALE 1"=20' .75 ACRES

46-6-3

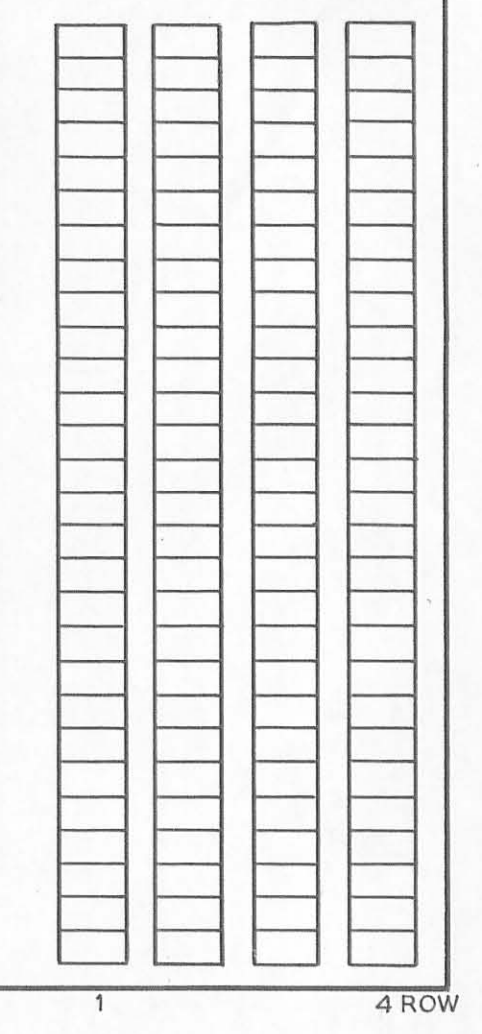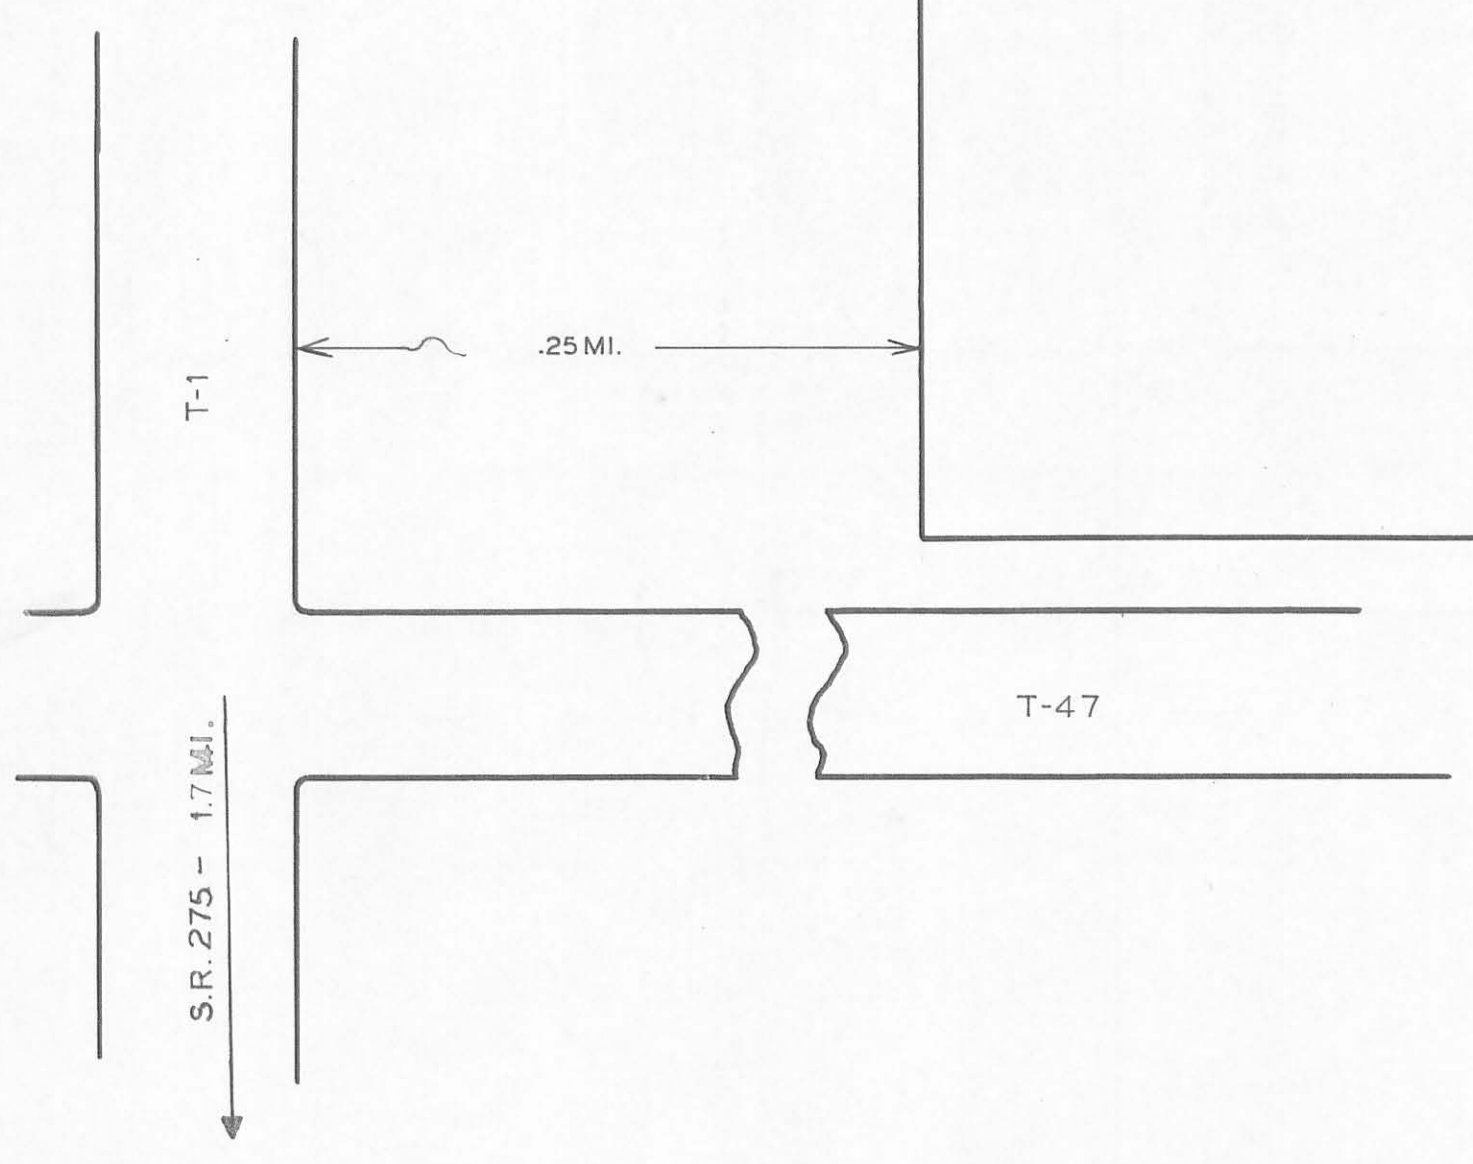

LEGEND  
 SEC=SECTION L=LOT R=ROW  
 G=GRAVE W=WAR  
 X=POSITION UNKNOWN

**PEELE  
 CEMETERY**  
 LOGAN CO. MONROE TWP

OFFICIAL PROJECT NOS. 465 42-3-467& 665-42-3-232

<b>LEGEND</b>	<b>HISTORY</b>
① REVOLUTIONARY WAR	
⑩ WAR OF 1812	
⑯ WAR WITH MEXICO	
⑲ CIVIL WAR	
⑳ SPANISH-AM. WAR	
㉑ WORLD WAR	

SCALE 1"=20' 0.1 ACRES

46-9-9










**AMERINE FARM  
CEMETERY**  
LOGAN CO. JEFFERSON TWP  
OFFICIAL PROJECT NOS. 465-42-3-467 & 665-42-3-232

LEGEND	HISTORY
① REVOLUTIONARY WAR	
⑩ WAR OF 1812	
⑯ WAR WITH MEXICO	
⑲ CIVIL WAR	
⑳ SPANISH-AM. WAR	
㉑ WORLD WAR	

SCALE 1"=20'      .01 ACRES

46-4-14

LEGEND  
SEC=SECTION L=LOT R=ROW  
G=GRAVE W=WAR  
X=POSITION UNKNOWN

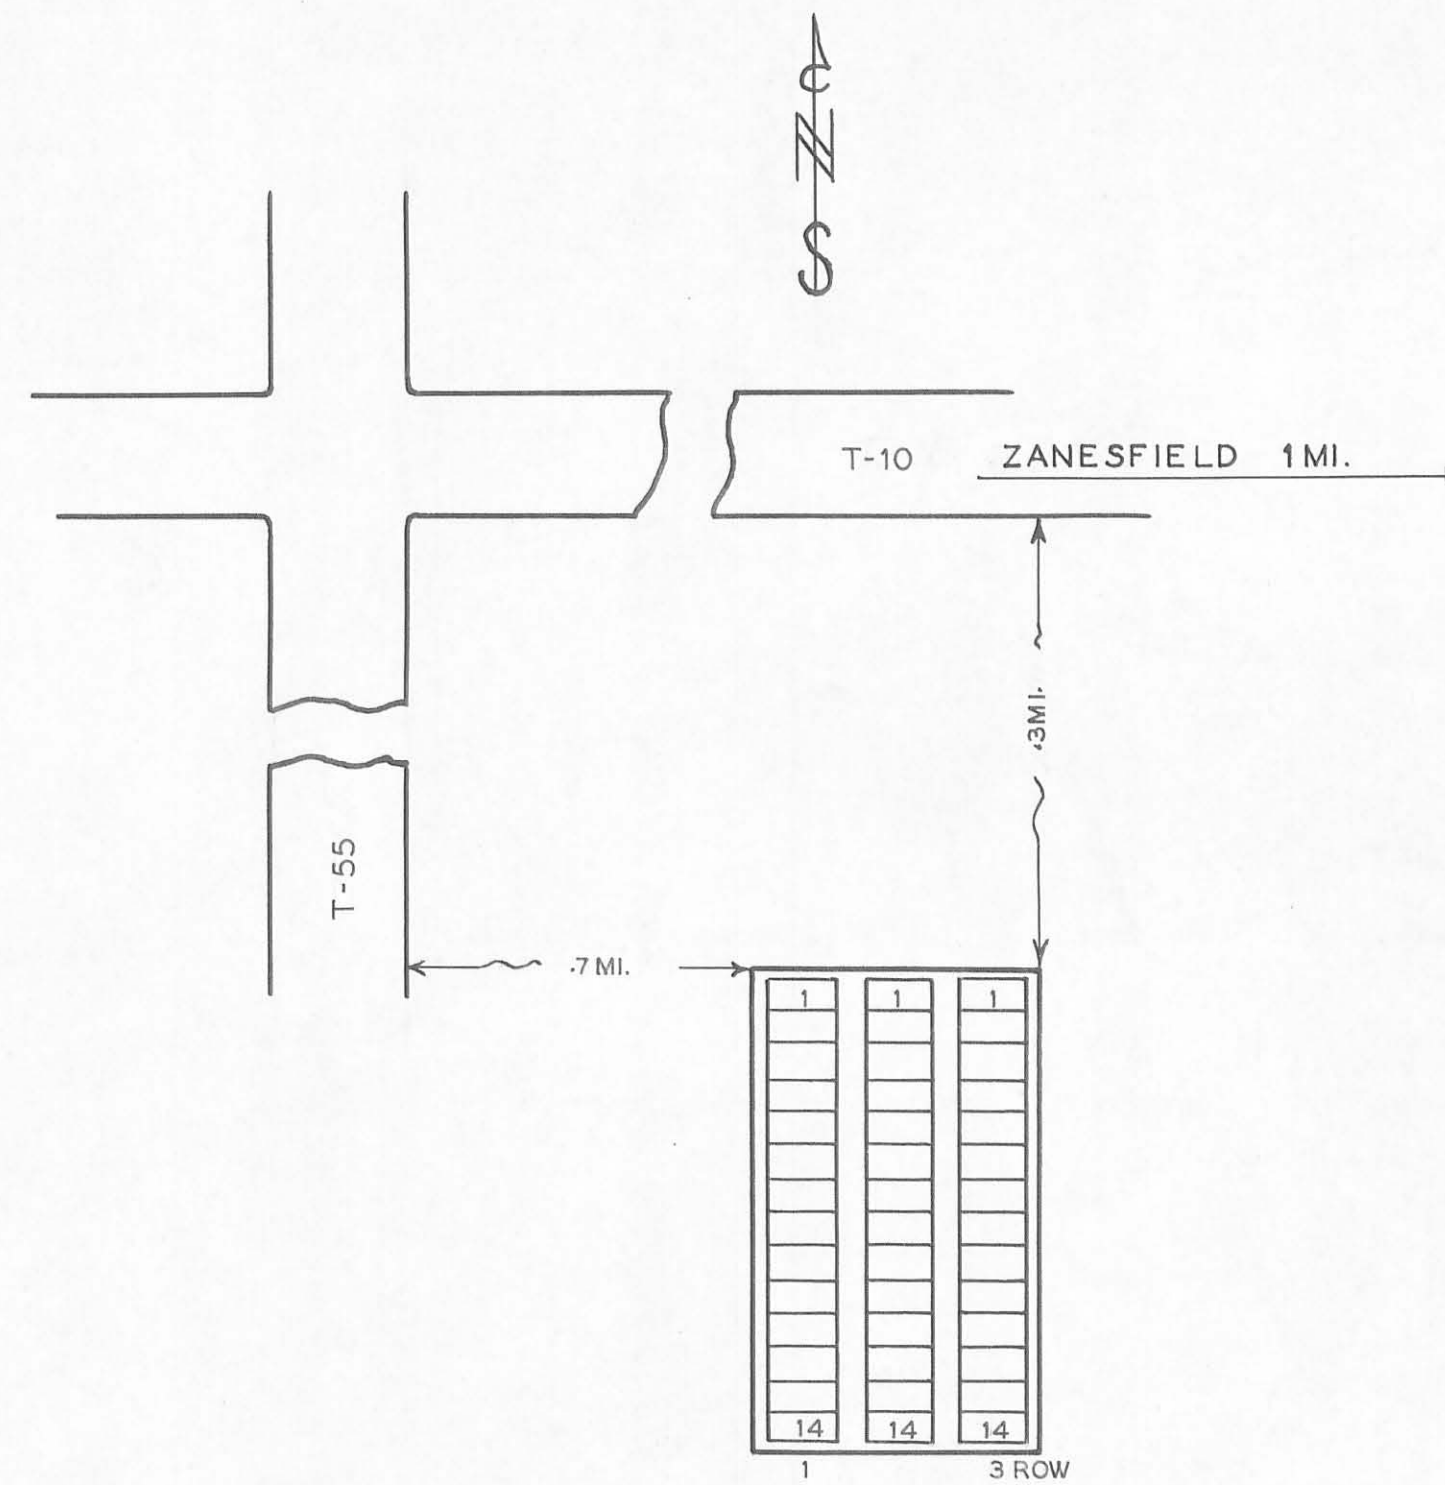


**CORDERY FARM  
CEMETERY**  
LOGAN CO. JEFFERSON TWP  
OFFICIAL PROJECT NOS. 465-42-3-467 & 665-42-3-232

LEGEND	HISTORY
① REVOLUTIONARY WAR	
⑩ WAR OF 1812	
⑯ WAR WITH MEXICO	
⑲ CIVIL WAR	
⑳ SPANISH-AM. WAR	
㉑ WORLD WAR	

SCALE 1"=20'      .03 ACRES

46-4-13

LEGEND  
SEC=SECTION L=LOT R=ROW  
G=GRAVE W=WAR  
X=POSITION UNKNOWN

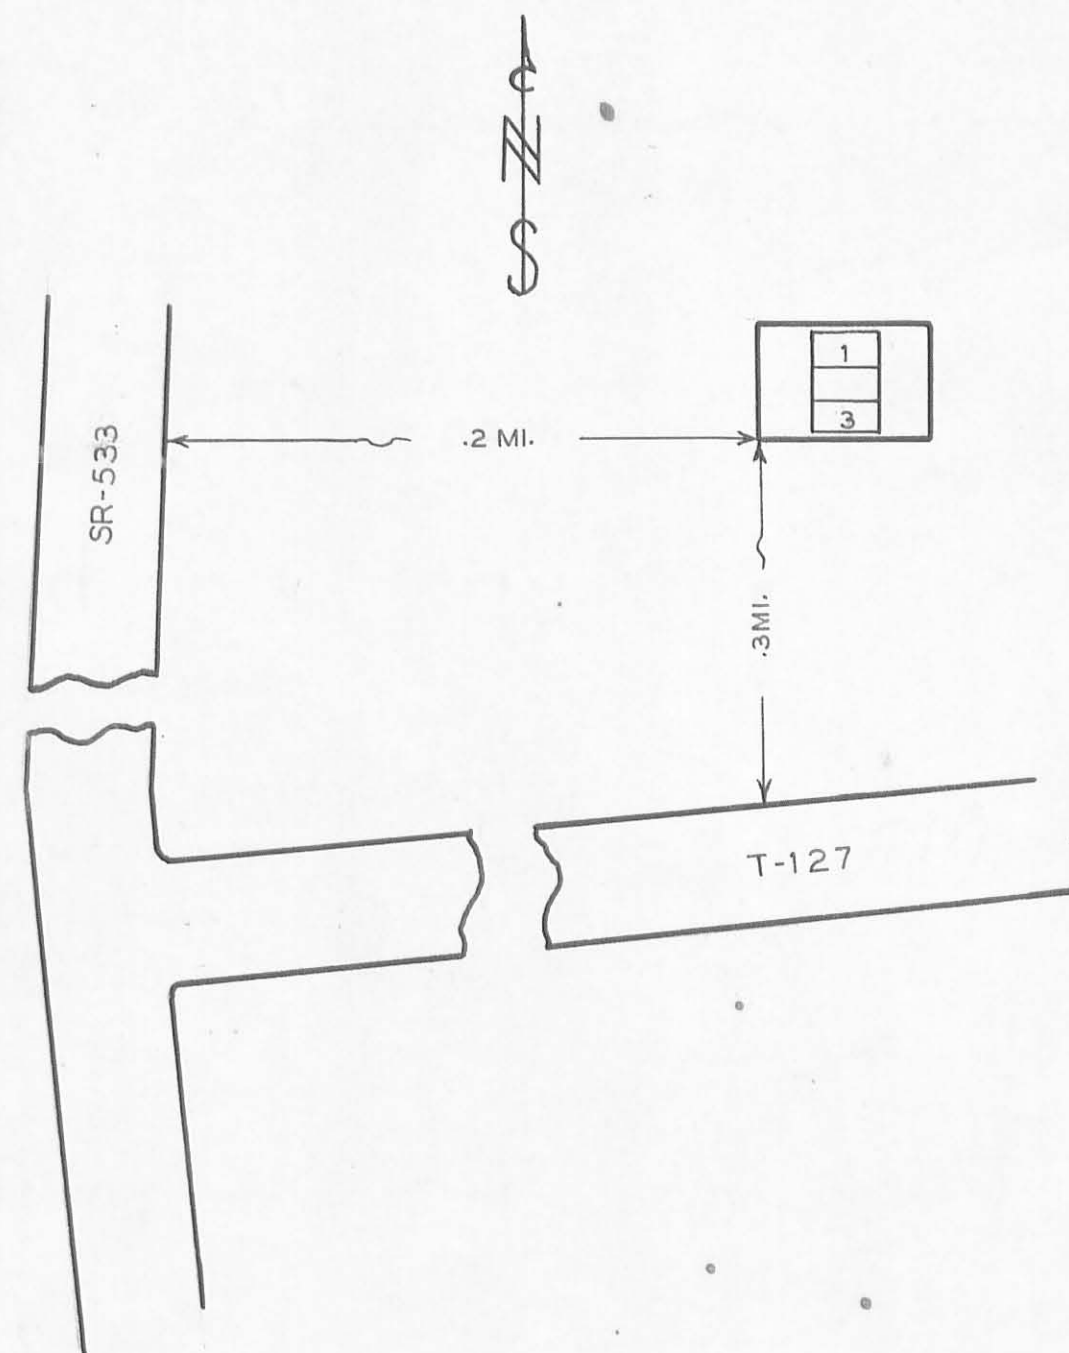


**MURDOCK FARM  
CEMETERY**  
LOGAN CO JEFFERSON TWP  
OFFICIAL PROJECT NOS. 465-42-3-467 & 665-42-3-232

LEGEND	HISTORY
① REVOLUTIONARY WAR	
⑩ WAR OF 1812	
⑯ WAR WITH MEXICO	
⑲ CIVIL WAR	
⑳ SPANISH-AM. WAR	
㉑ WORLD WAR	

SCALE 1"=20'      .01 ACRES

46-4-15

LEGEND  
SEC=SECTION L=LOT R=ROW  
G=GRAVE W=WAR  
X=POSITION UNKNOWN

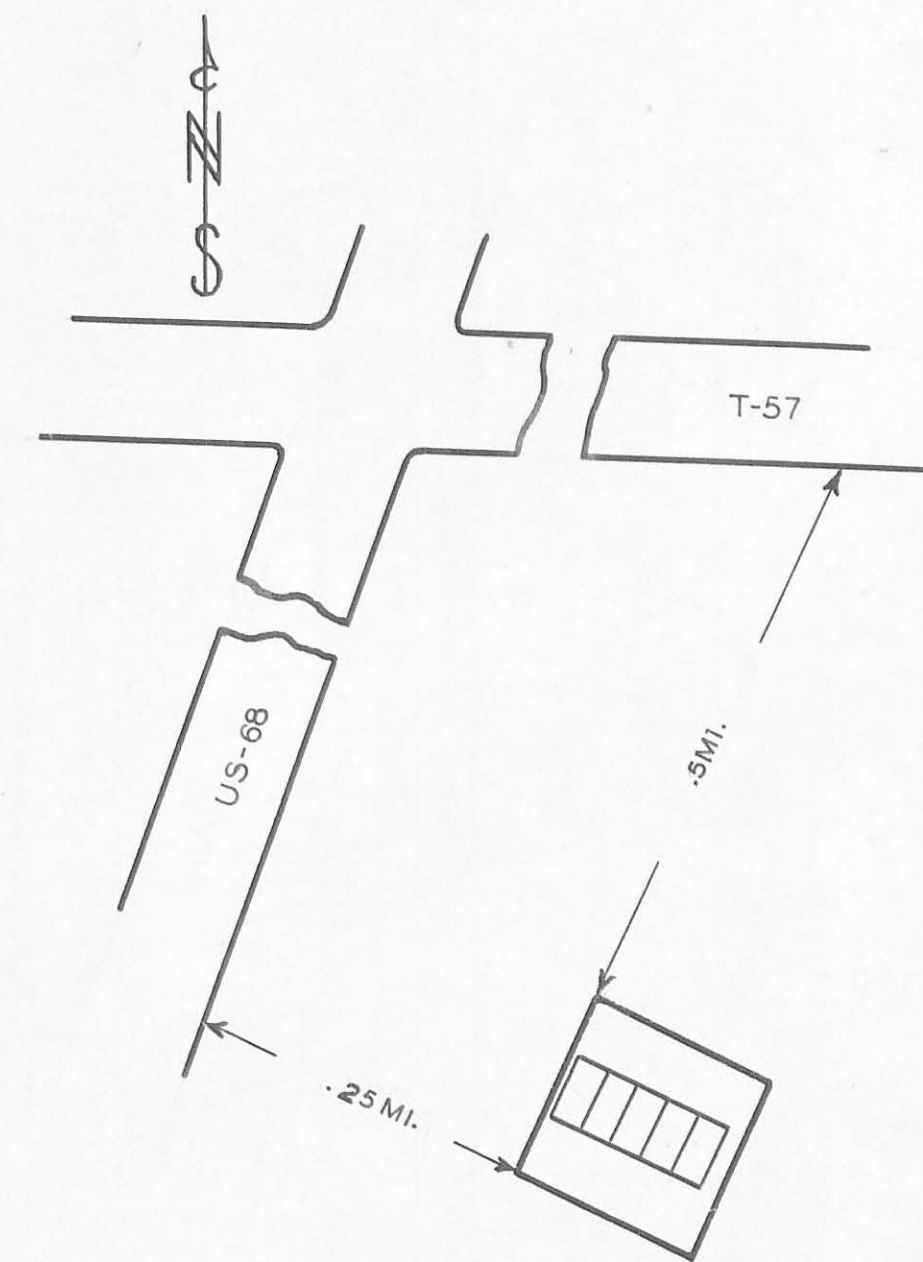

**SWALLOW  
CEMETERY**  
LOGAN CO. LAKE TWP.  
OFFICIAL PROJECT NOS. 465-42-3-467 & 665-42-3-232


LEGEND	HISTORY
① REVOLUTIONARY WAR	
⑩ WAR OF 1812	
⑯ WAR WITH MEXICO	
⑲ CIVIL WAR	
⑳ SPANISH-AM. WAR	
㉑ WORLD WAR	

SCALE 1"=20'      .01 ACRES

46-5-8

LEGEND  
SEC=SECTION L=LOT R=ROW  
G=GRAVE W=WAR  
X=POSITION UNKNOWN



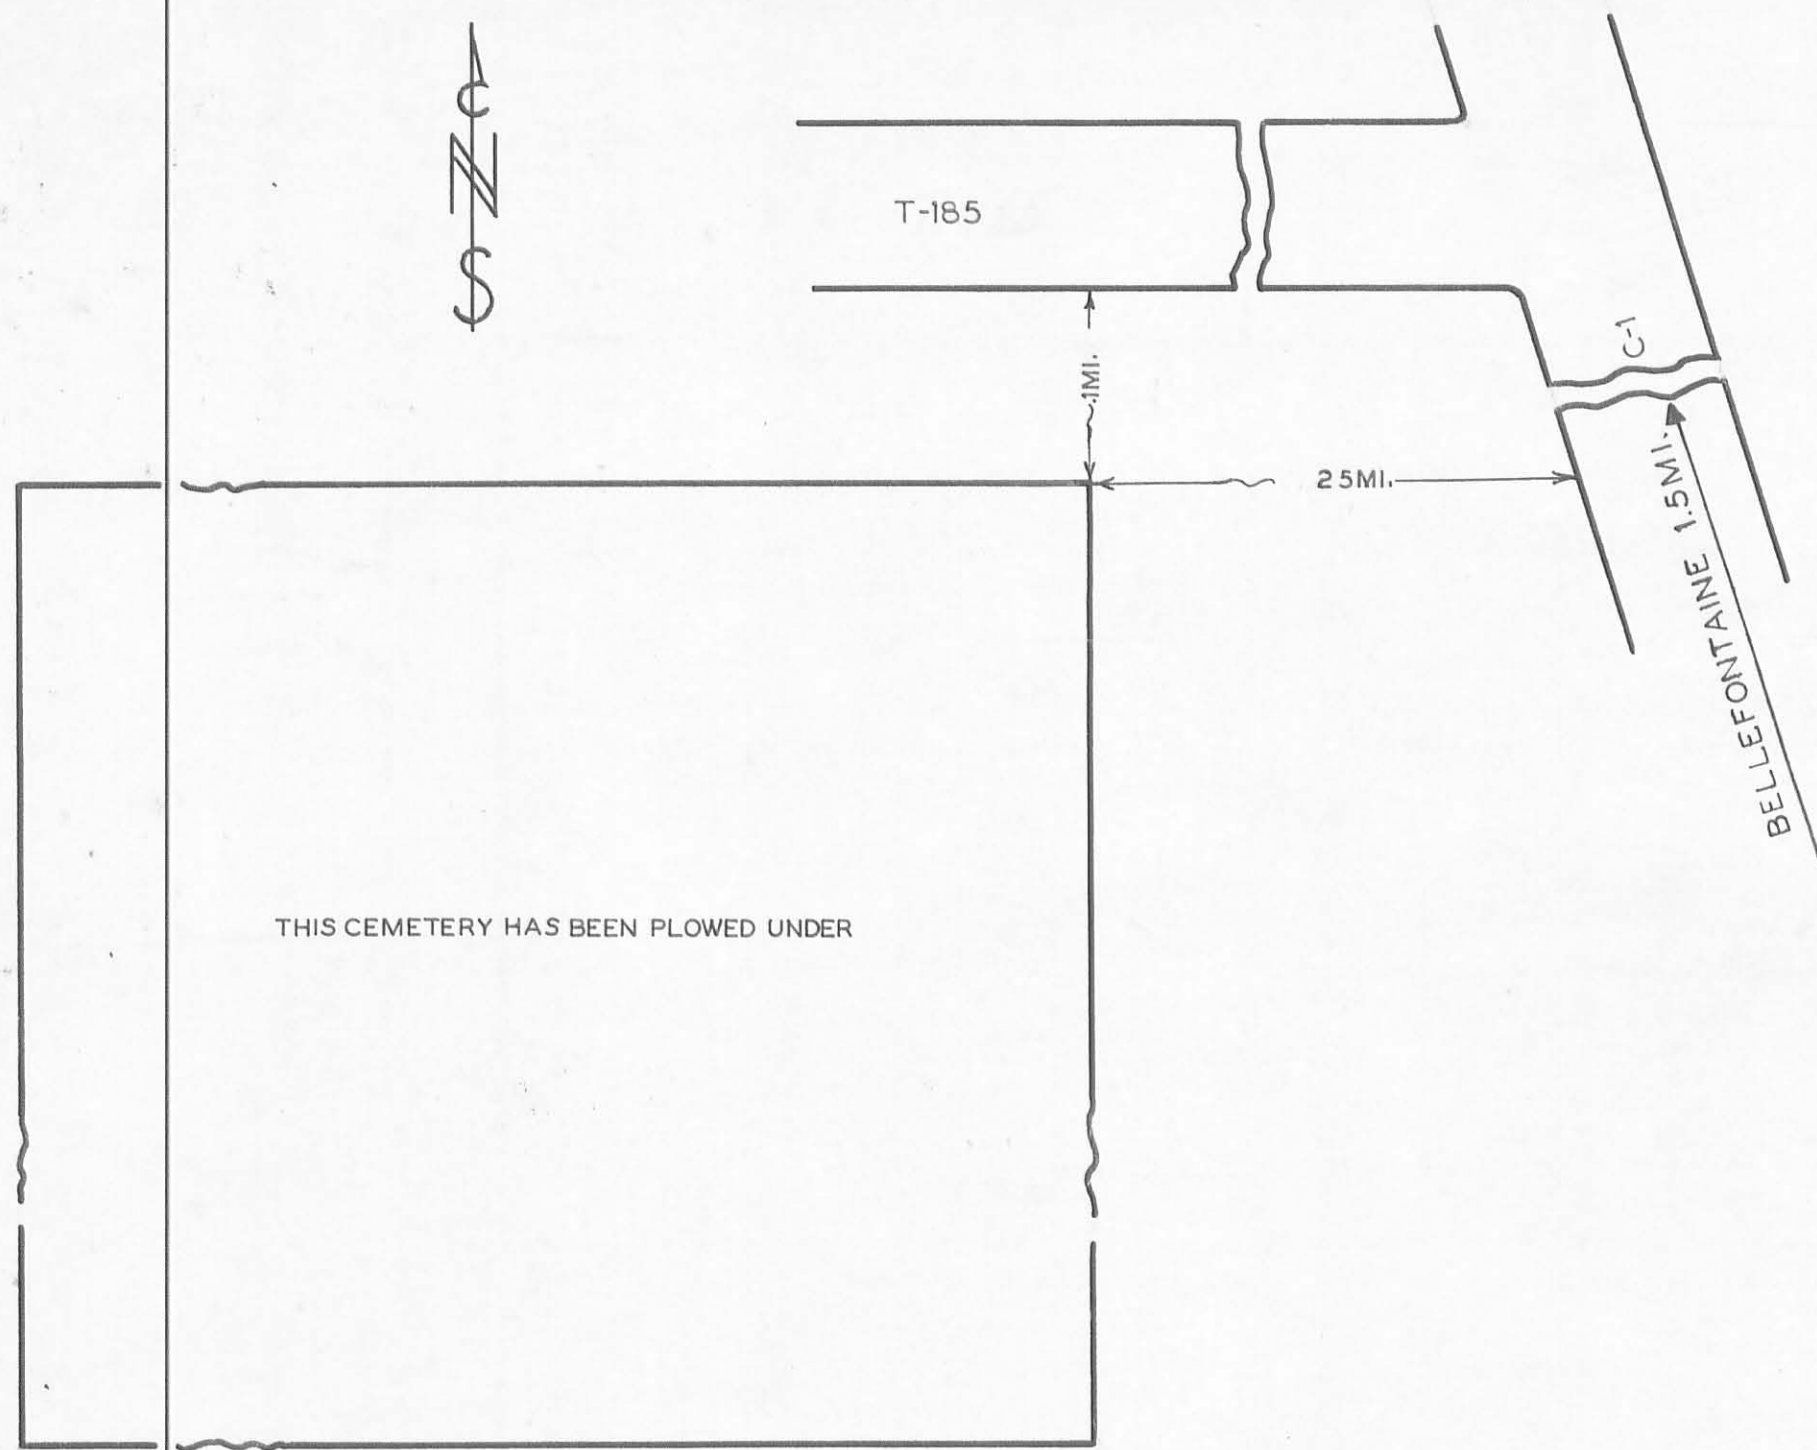

MOORE WILLIAM \*

\* = POSITION UNKNOWN

**BELLEVILLE CEMETERY**

LOGAN CO. LAKE TWP


OFFICIAL PROJECT NOS. 465-42-3-467 & 665-42-3-232

LEGEND	HISTORY
① REVOLUTIONARY WAR	
⑩ WAR OF 1812	
⑮ WAR WITH MEXICO	
⑲ CIVIL WAR	
⑳ SPANISH-AM. WAR	
㉑ WORLD WAR	

SCALE 1"=20' 1 ACRE

**46-5-7**

LEGEND  
SEC=SECTION L=LOT R=ROW  
G=GRAVE W=WAR  
X=POSITION UNKNOWN

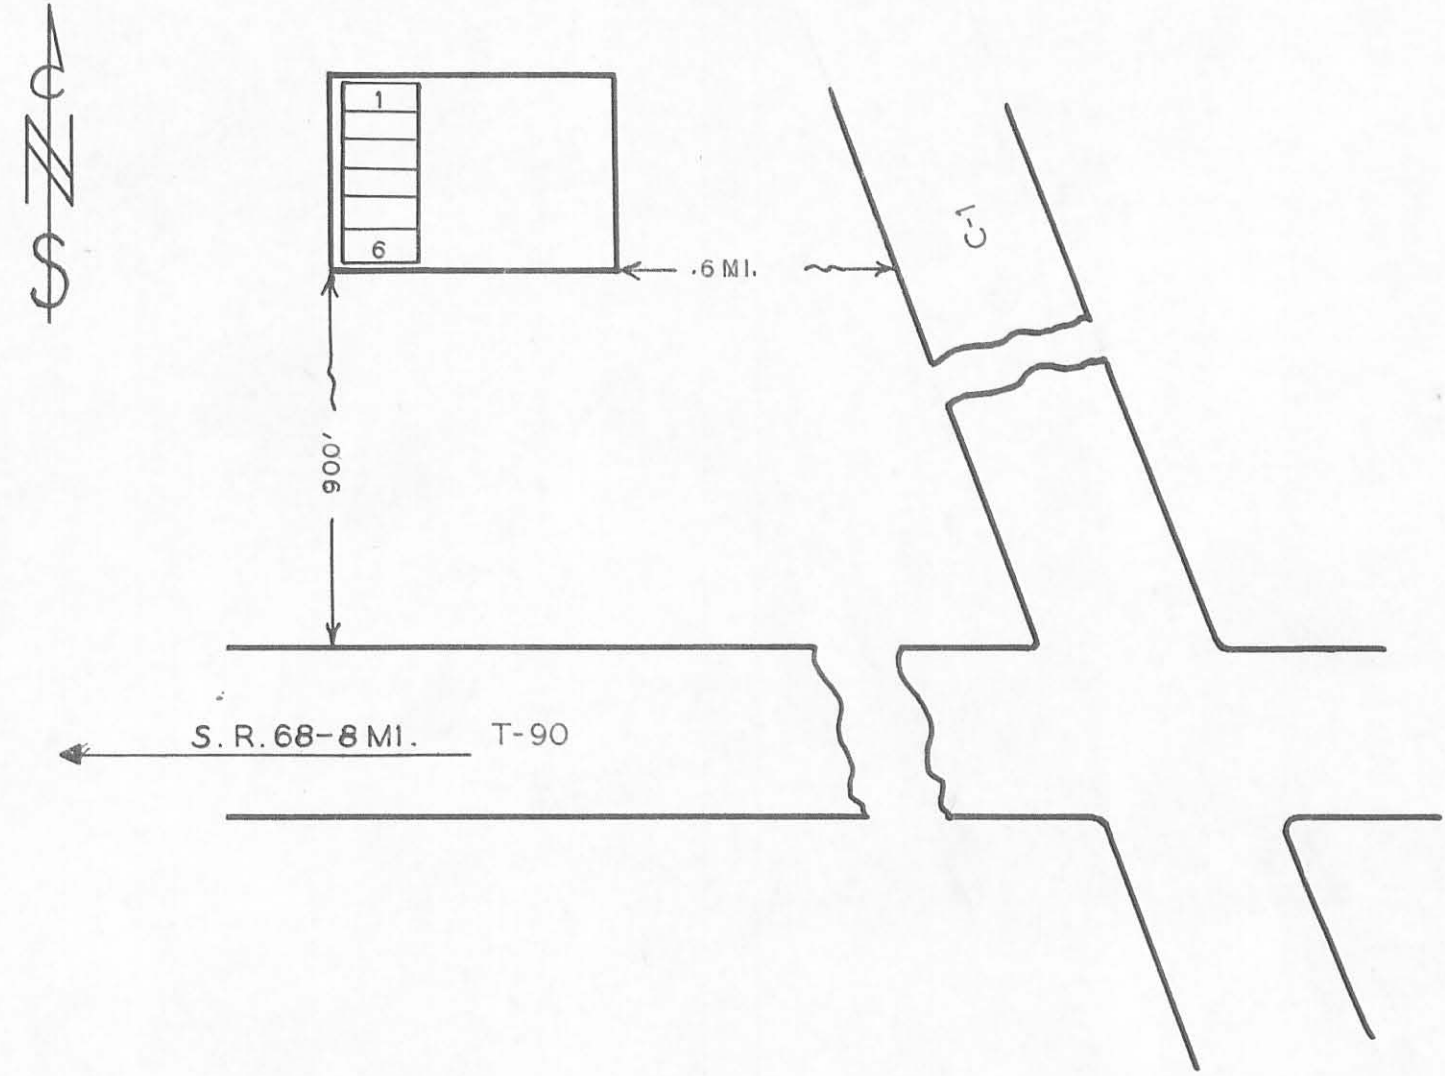

**COOPER FARM CEMETERY**

LOGAN CO. MIAMI TWP


OFFICIAL PROJECT NOS. 465-42-3-467 & 665-42-3-232

LEGEND	HISTORY
① REVOLUTIONARY WAR	
⑩ WAR OF 1812	
⑮ WAR WITH MEXICO	
⑲ CIVIL WAR	
⑳ SPANISH-AM. WAR	
㉑ WORLD WAR	

SCALE 1"=20' .01 ACRE

**46-6-6**

LEGEND  
SEC=SECTION L=LOT R=ROW  
G=GRAVE W=WAR  
X=POSITION UNKNOWN

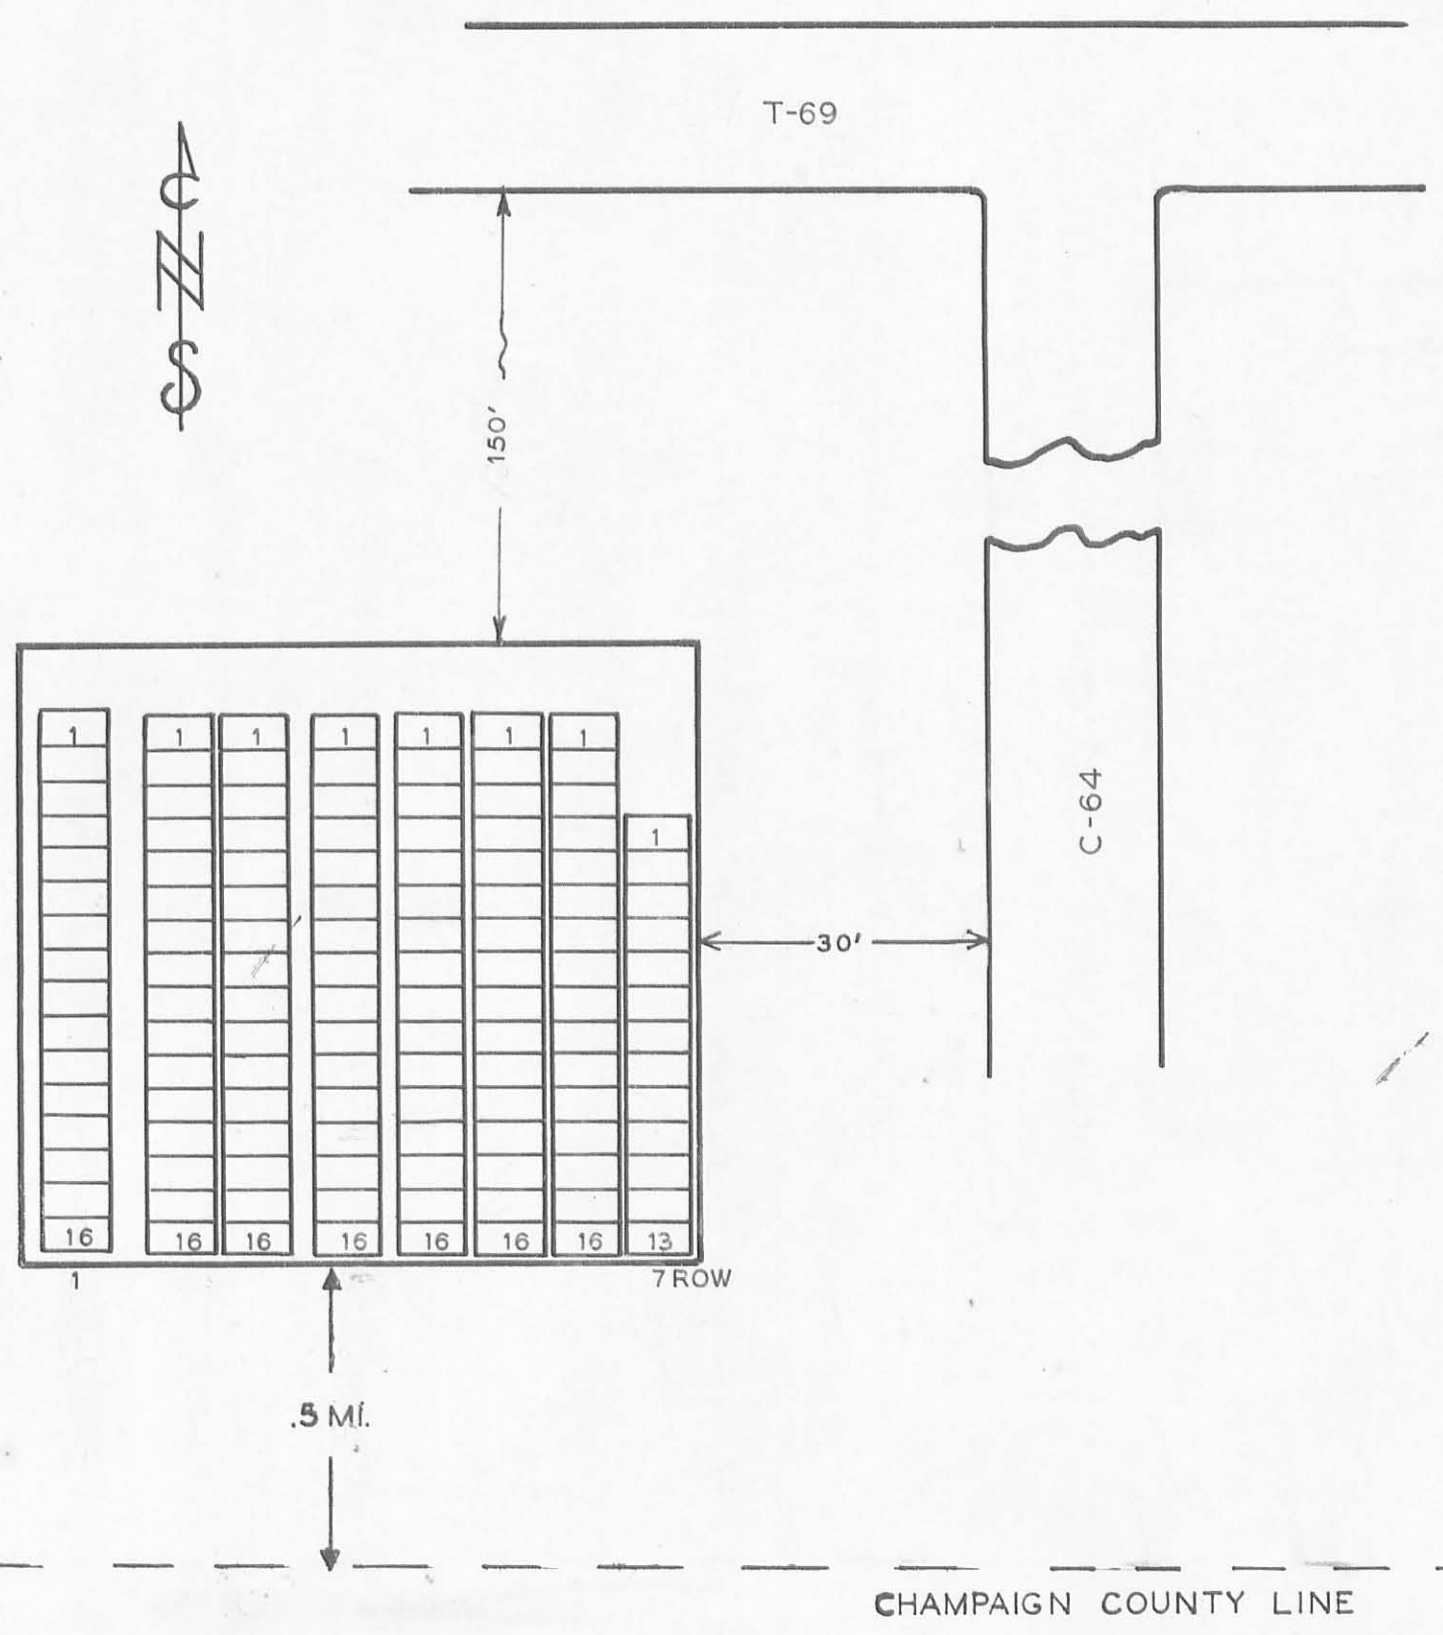

**NEWMAN CEMETERY**

LOGAN CO. LIBERTY TWP


OFFICIAL PROJECT NOS. 465-42-3-467 & 665-42-3-232

LEGEND	HISTORY
① REVOLUTIONARY WAR	
⑩ WAR OF 1812	
⑮ WAR WITH MEXICO	
⑲ CIVIL WAR	
⑳ SPANISH-AM. WAR	
㉑ WORLD WAR	

SCALE 1"=20' .11 ACRE

**46-8-2**

LEGEND  
SEC=SECTION L=LOT R=ROW  
G=GRAVE W=WAR  
X=POSITION UNKNOWN

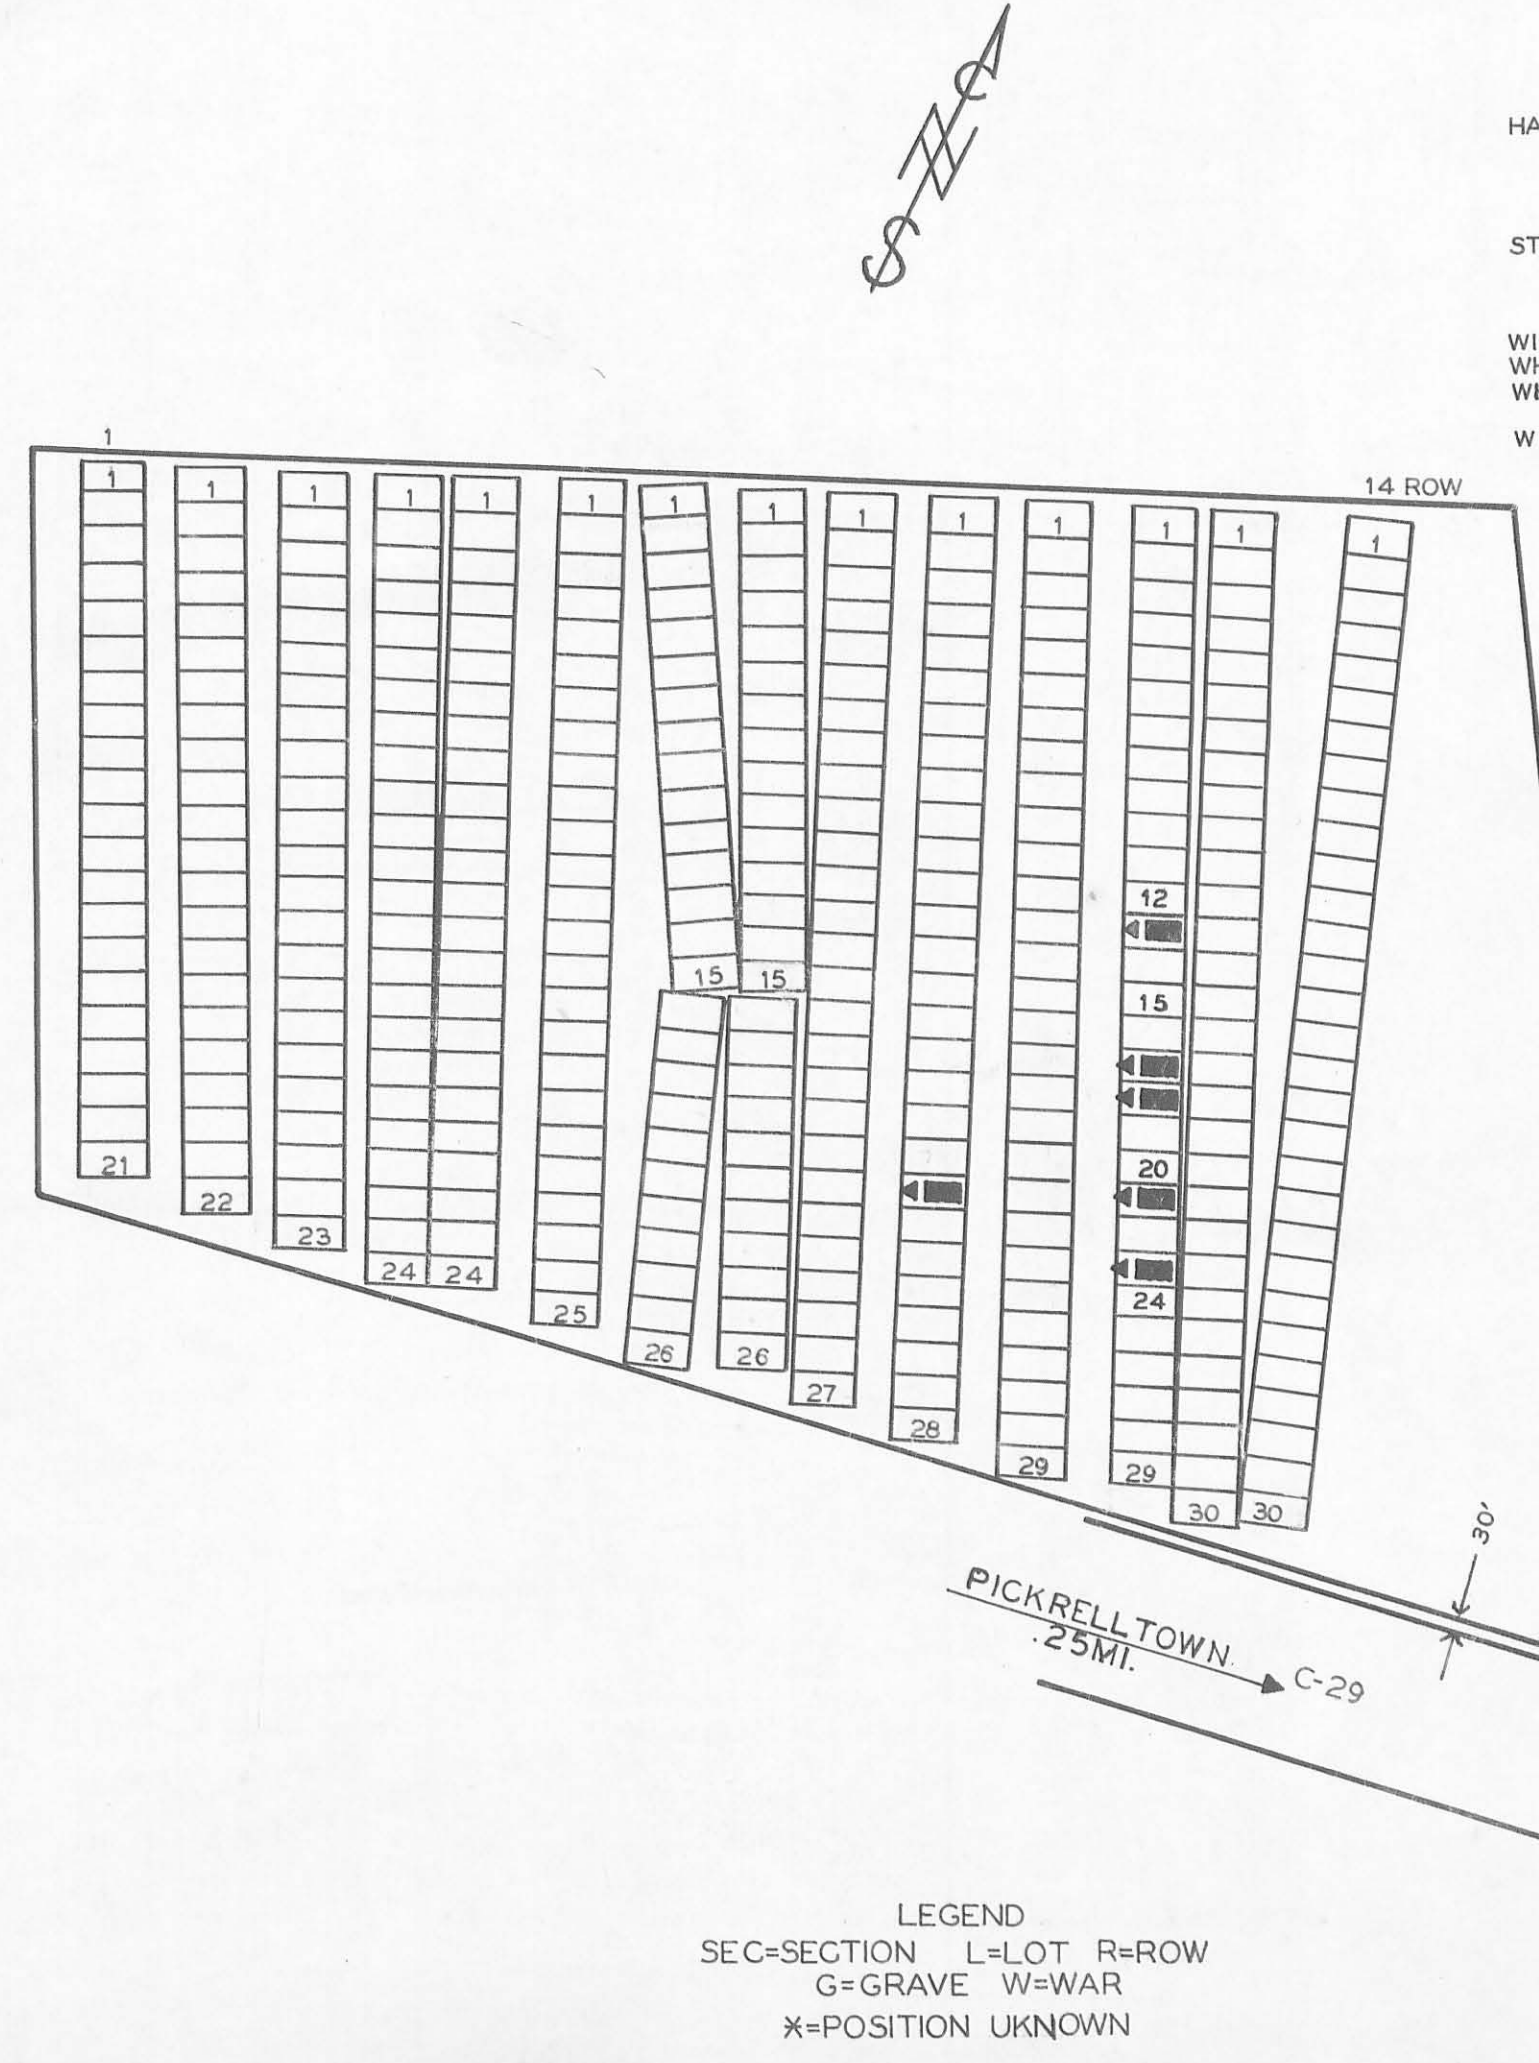

**PICKRELLTOWN CEMETERY**

LOGAN CO. MONROE TWP

OFFICIAL PROJECT NOS. 465-42-3-467 & 665-42-3-232


LEGEND	HISTORY
① REVOLUTIONARY WAR	
⑩ WAR OF 1812	
⑮ WAR WITH MEXICO	
⑲ CIVIL WAR	
⑳ SPANISH-AM. WAR	
㉑ WORLD WAR	

SCALE 1"=20' .4 ACRE

**46-9-1**

LEGEND  
SEC=SECTION L=LOT R=ROW  
G=GRAVE W=WAR  
X=POSITION UNKNOWN



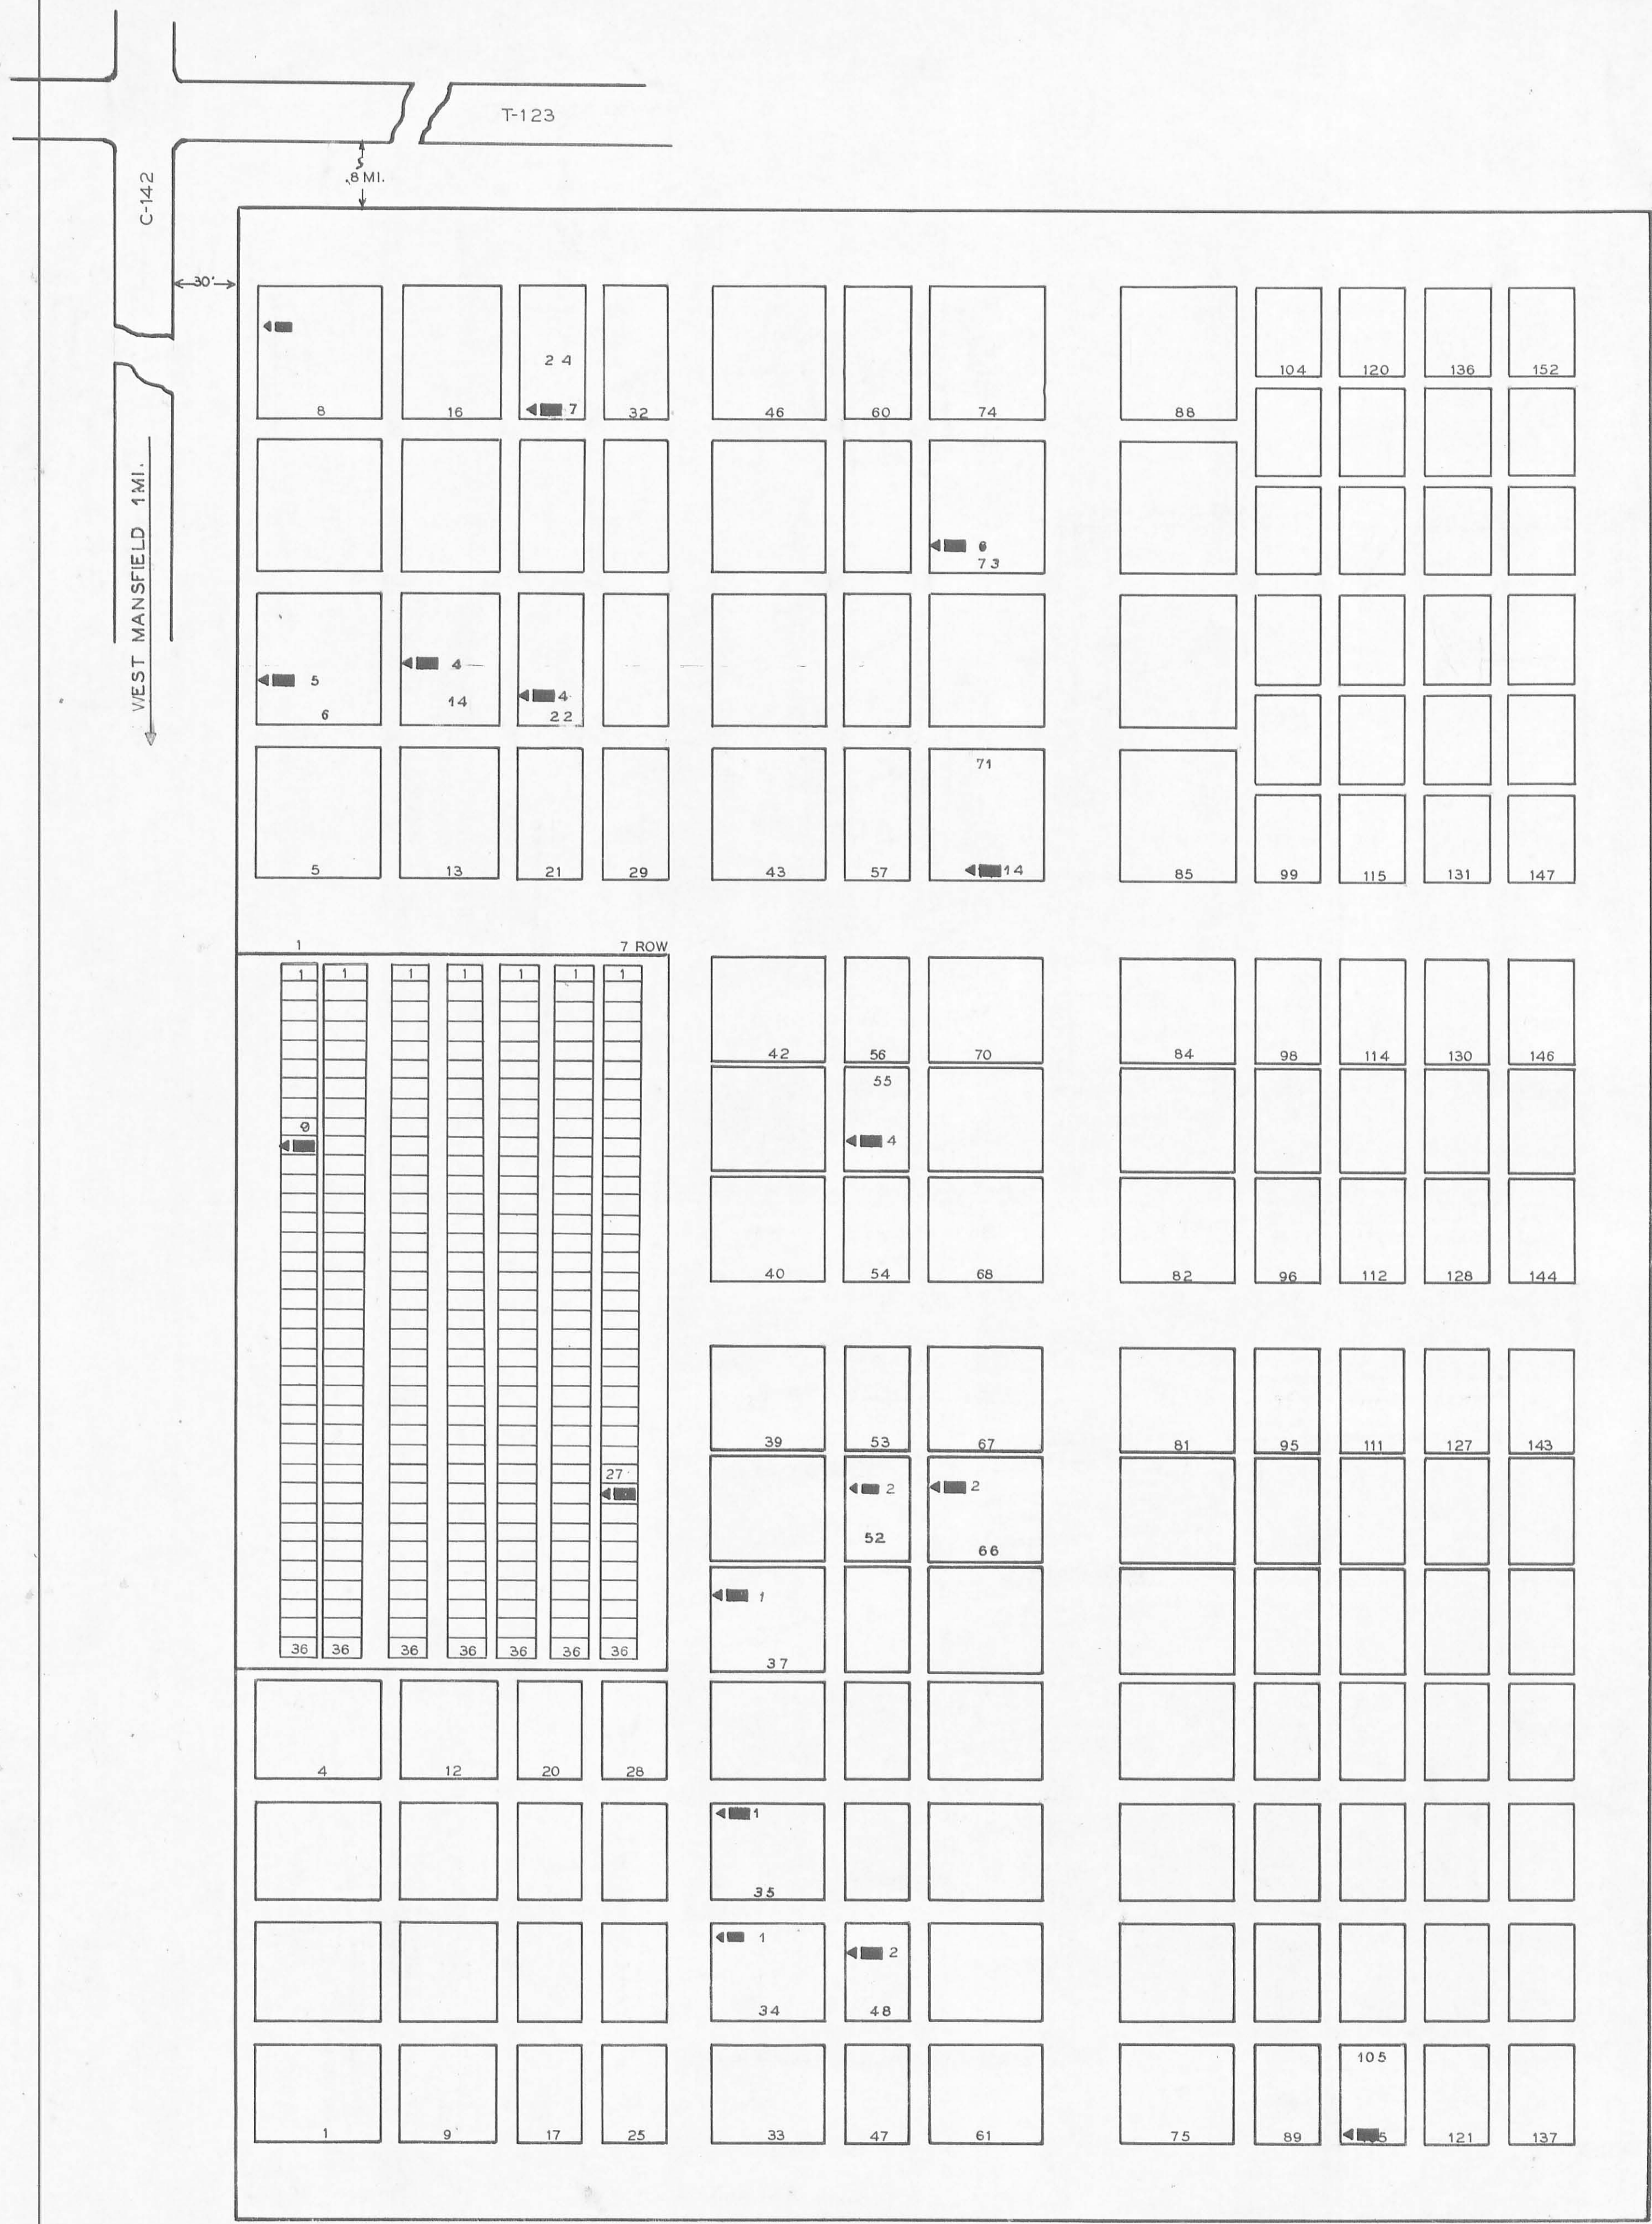

NAME	SEC	L	R	G	W
BATES LORING	71			14	19
BATES THOMAS			1	10	19
HOOVER GEORGE W	66			2	19
KERNS OWENS	55			4	19
KIRKPATRICK ELIJAH	6			5	19
KELLER JOHN A.	8			3	19
MABERY T.L.	14			4	19
MOURNING BRITTON	52			2	19
REAMMES NEWTON W.	37			1	19
SIMPSON STEPHEN D.	48			2	19
STEARNS RAD	73			6	19
TITSWORTH LEWIS G.	105			5	19
WILSON JAMES L.	22			6	16
WINNER LEE T.		7		22	19
VAN VOORHIS SAMUEL	24			7	19
WATSON JOHN M.	34			1	
MARSH S. J.	35			1	19


**HATHAWAY CEMETERY**  
 LOGAN CO. BOKES CREEK TWP.  
 OFFICIAL PROJECT NOS 465-42-3-467 & 665-42-3-232

<b>LEGEND</b>	<b>HISTORY</b>
① REVOLUTIONARY WAR	
⑩ WAR OF 1812	
⑮ WAR WITH MEXICO	
⑲ CIVIL WAR	
⑳ SPANISH-AM. WAR	
㉑ WORLD WAR	

SCALE 1"=20'      .27 ACRE

46-2-3

LEGEND  
 SEC=SECTION L=LOT R=ROW  
 G=GRAVE W=WAR  
 X=POSITION UNKNOWN

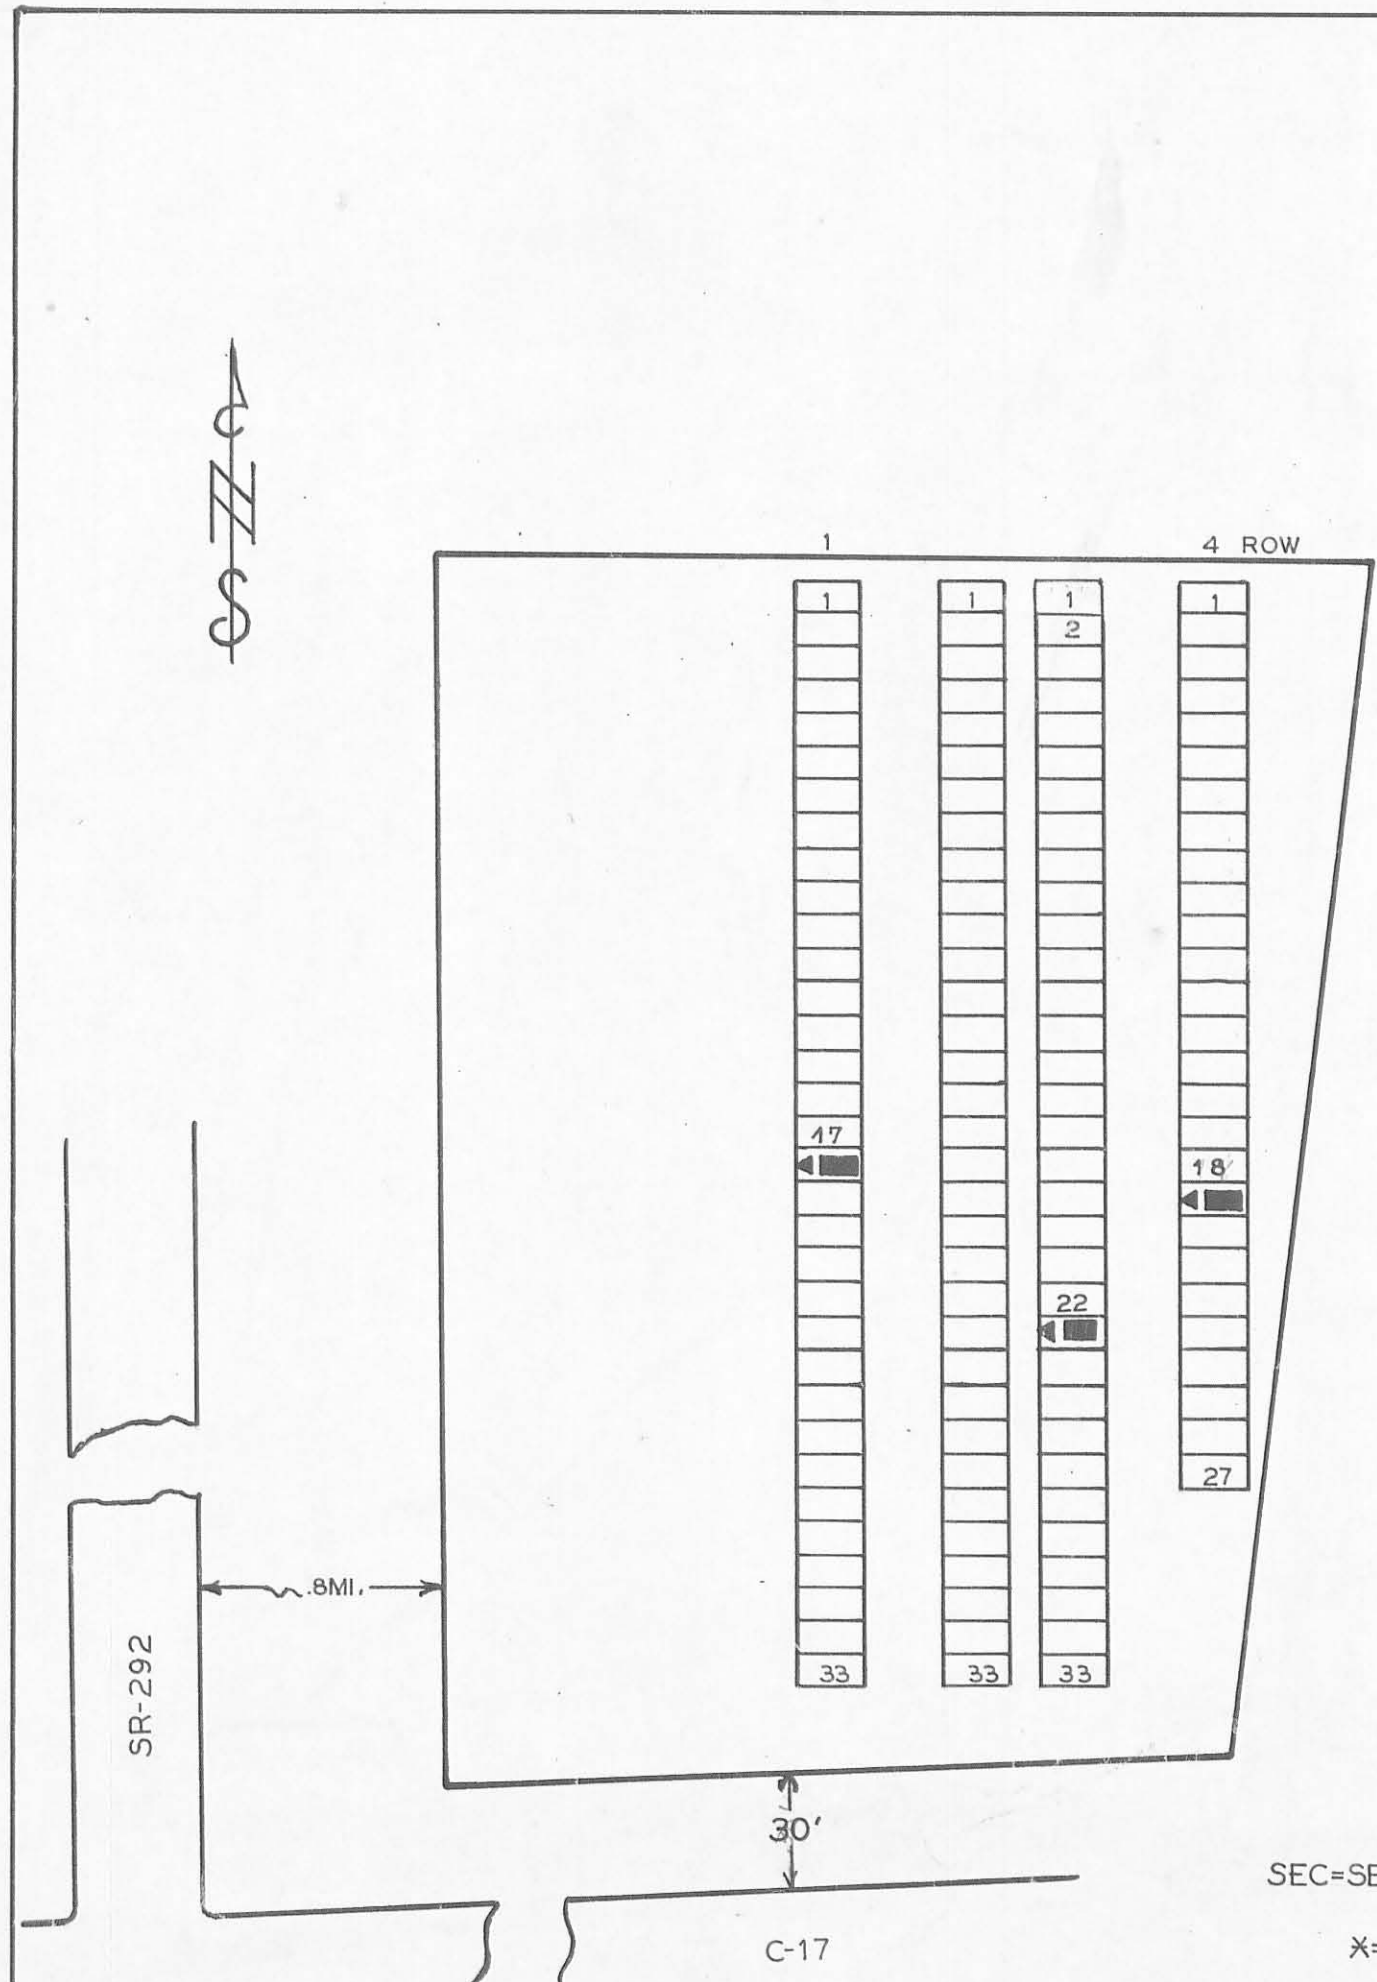

NAME	SEC	L	R	G	W
EARLY JACOB W.	3			23	19
EARLY WM. J.	1			18	19
SMITH JAMES J.	4			19	19

**EARLY CEMETERY**  
 LOGAN CO. BOKES CREEK TWP.  
 OFFICIAL PROJECT NOS 465-42-3-467 & 665-42-3-232

<b>LEGEND</b>	<b>HISTORY</b>
① REVOLUTIONARY WAR	
⑩ WAR OF 1812	
⑮ WAR WITH MEXICO	
⑲ CIVIL WAR	
⑳ SPANISH-AM. WAR	
㉑ WORLD WAR	

SCALE 1"=20'      0.27 ACRE

46-2-2

LEGEND  
 SEC=SECTION L=LOT R=ROW  
 G=GRAVE W=WAR  
 X=POSITION UNKNOWN