

LEGEND  
SEC=SECTION L=LOT R=ROW  
G=GRAVE W=WAR  
X=POSITION UNKNOWN

**AKEY FARM CEMETERY**  
LOGAN CO. PERRY TWP.  
OFFICIAL PROJECT N<sup>o</sup> 465-42-3-467&665-42-3-232

<p><b>LEGEND</b></p> <p>① REVOLUTIONARY WAR ⑩ WAR OF 1812 ⑯ MEXICAN WAR ⑰ CIVIL WAR ⑳ SPANISH-AM WAR ㉑ WORLD WAR</p>	<p><b>HISTORY</b></p> <p>SCALE 1" = 20'</p> <p>ACRES .16</p>
--	--

46-10-7




LEGEND  
SEC=SECTION L=LOT R=ROW  
G=GRAVE W=WAR  
X=POSITION UNKNOWN

**WESTLAND CEMETERY**  
LOGAN CO. MONROE TWP.  
OFFICIAL PROJECT NOS. 465-42-3-467&665-42-3-232

<p><b>LEGEND</b></p> <p>① REVOLUTIONARY WAR ⑩ WAR OF 1812 ⑯ MEXICAN WAR ⑰ CIVIL WAR ⑳ SPANISH AM. WAR ㉑ WORLD WAR</p>	<p><b>HISTORY</b></p> <p>SCALE 1" = 20'</p> <p>ACRES 0.4</p>
---	--

46-9-6

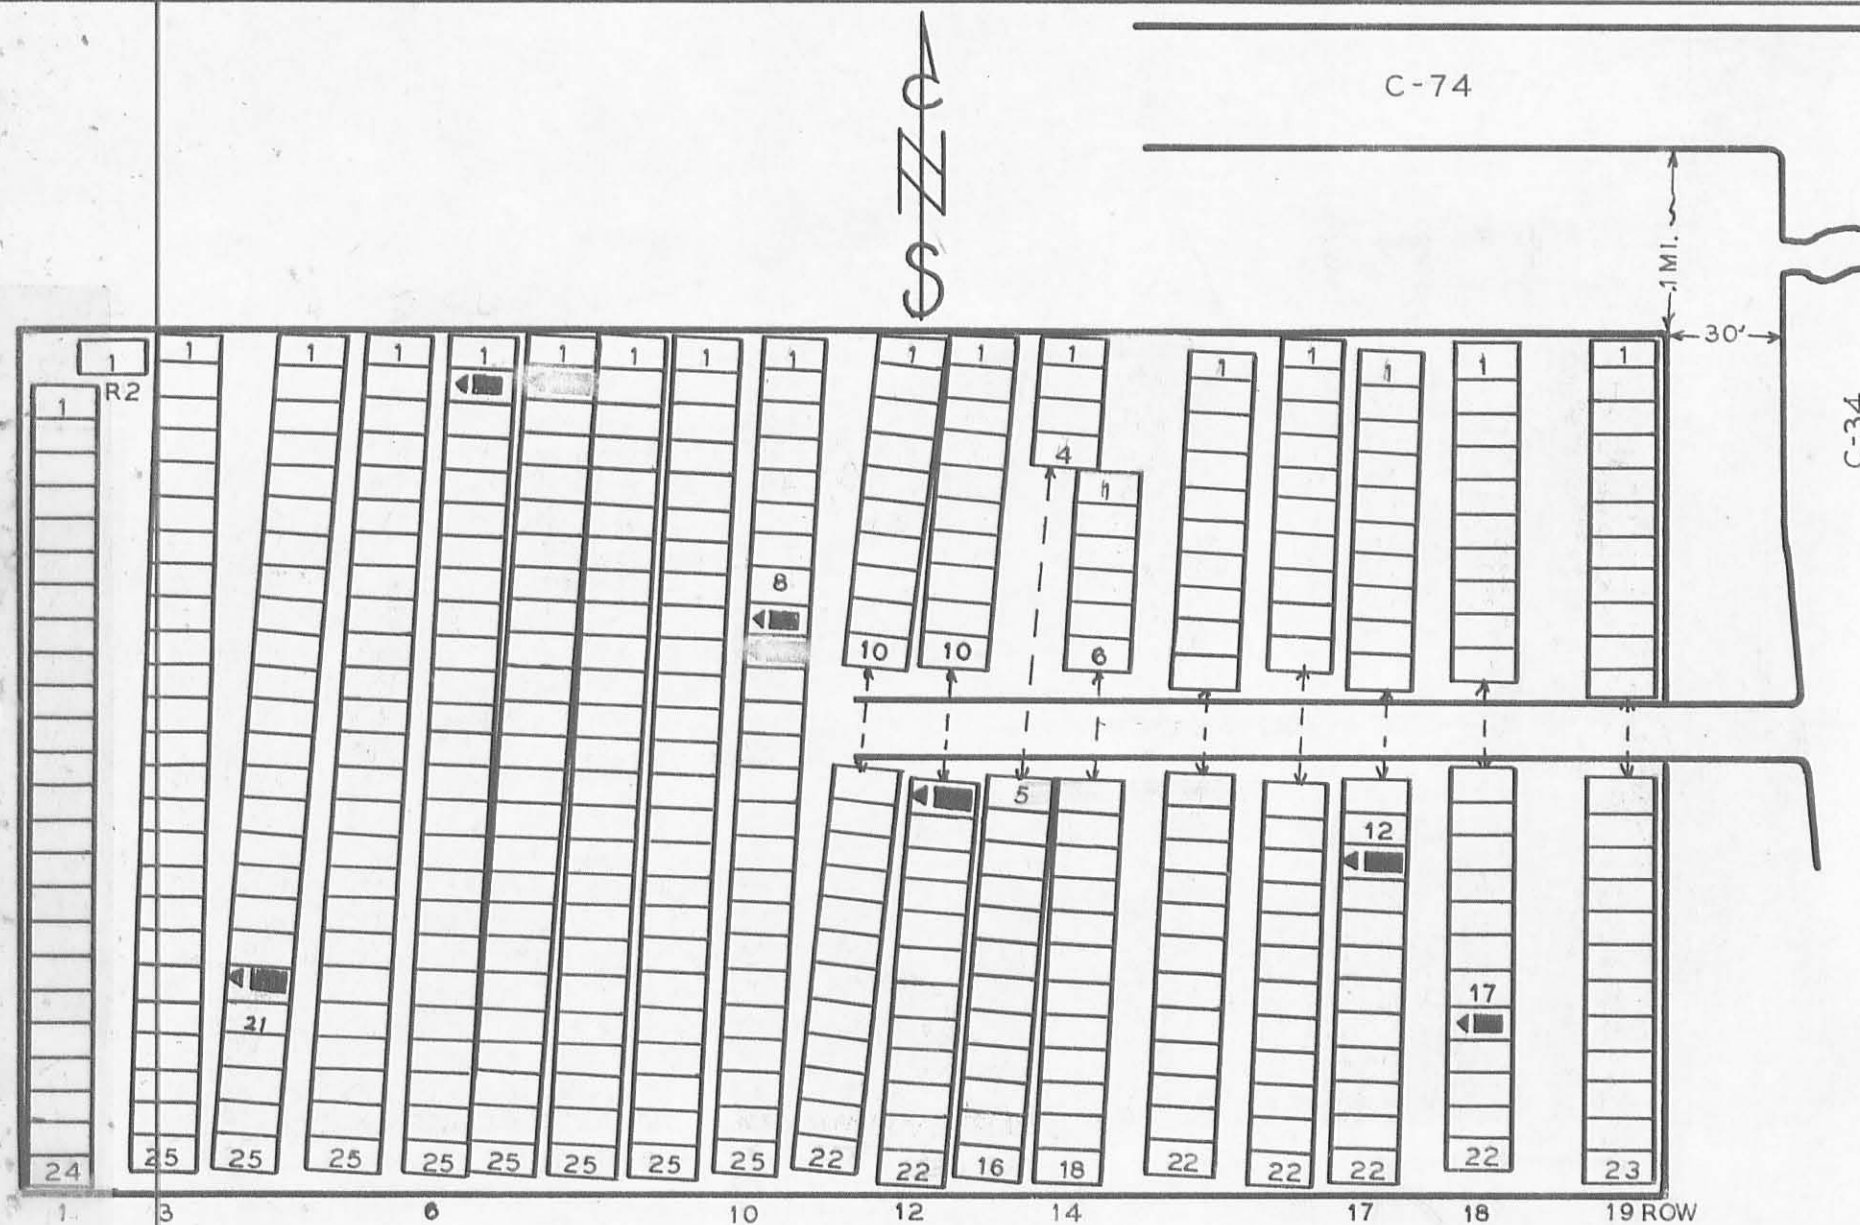

LEGEND  
SEC=SECTION L=LOT R=ROW  
G=GRAVE W=WAR  
X=POSITION UNKNOWN

<p><b>NAME</b></p> <p>GRAFTON PERRY M'KINNON DANIEL TROBRIDGE GEO. WHEELER GEO.W.</p>	<table border="0"> <tr> <td>SEC</td> <td>L</td> <td>R</td> <td>G</td> <td>W</td> </tr> <tr> <td>10</td> <td></td> <td>9</td> <td>19</td> <td></td> </tr> <tr> <td>6</td> <td></td> <td>2</td> <td>10</td> <td></td> </tr> <tr> <td>17</td> <td></td> <td>13</td> <td>19</td> <td></td> </tr> <tr> <td>12</td> <td></td> <td>11</td> <td>19</td> <td></td> </tr> </table>	SEC	L	R	G	W	10		9	19		6		2	10		17		13	19		12		11	19	
SEC	L	R	G	W																						
10		9	19																							
6		2	10																							
17		13	19																							
12		11	19																							


**SUPPLEMENTARY LIST**

<p><b>NAME</b></p> <p>COLLINS SOLOMAN LINE NATHAN T.</p>	<table border="0"> <tr> <td>SEC</td> <td>L</td> <td>R</td> <td>G</td> <td>W</td> </tr> <tr> <td>18</td> <td></td> <td>18</td> <td></td> <td></td> </tr> <tr> <td>4</td> <td></td> <td>20</td> <td></td> <td></td> </tr> </table>	SEC	L	R	G	W	18		18			4		20		
SEC	L	R	G	W												
18		18														
4		20														

**ARMSTRONG CEMETERY**  
LOGAN CO. MIAMI TWP.  
OFFICIAL PROJECT N<sup>o</sup> 465-42-3-467&665-42-3-232

<p><b>LEGEND</b></p> <p>① REVOLUTIONARY WAR ⑩ WAR OF 1812 ⑯ MEXICAN WAR ⑰ CIVIL WAR ⑳ SPANISH-AM WAR ㉑ WORLD WAR</p>	<p><b>HISTORY</b></p> <p>SCALE 1" = 20'</p> <p>ACRES .50</p>
--	--

46-8-5

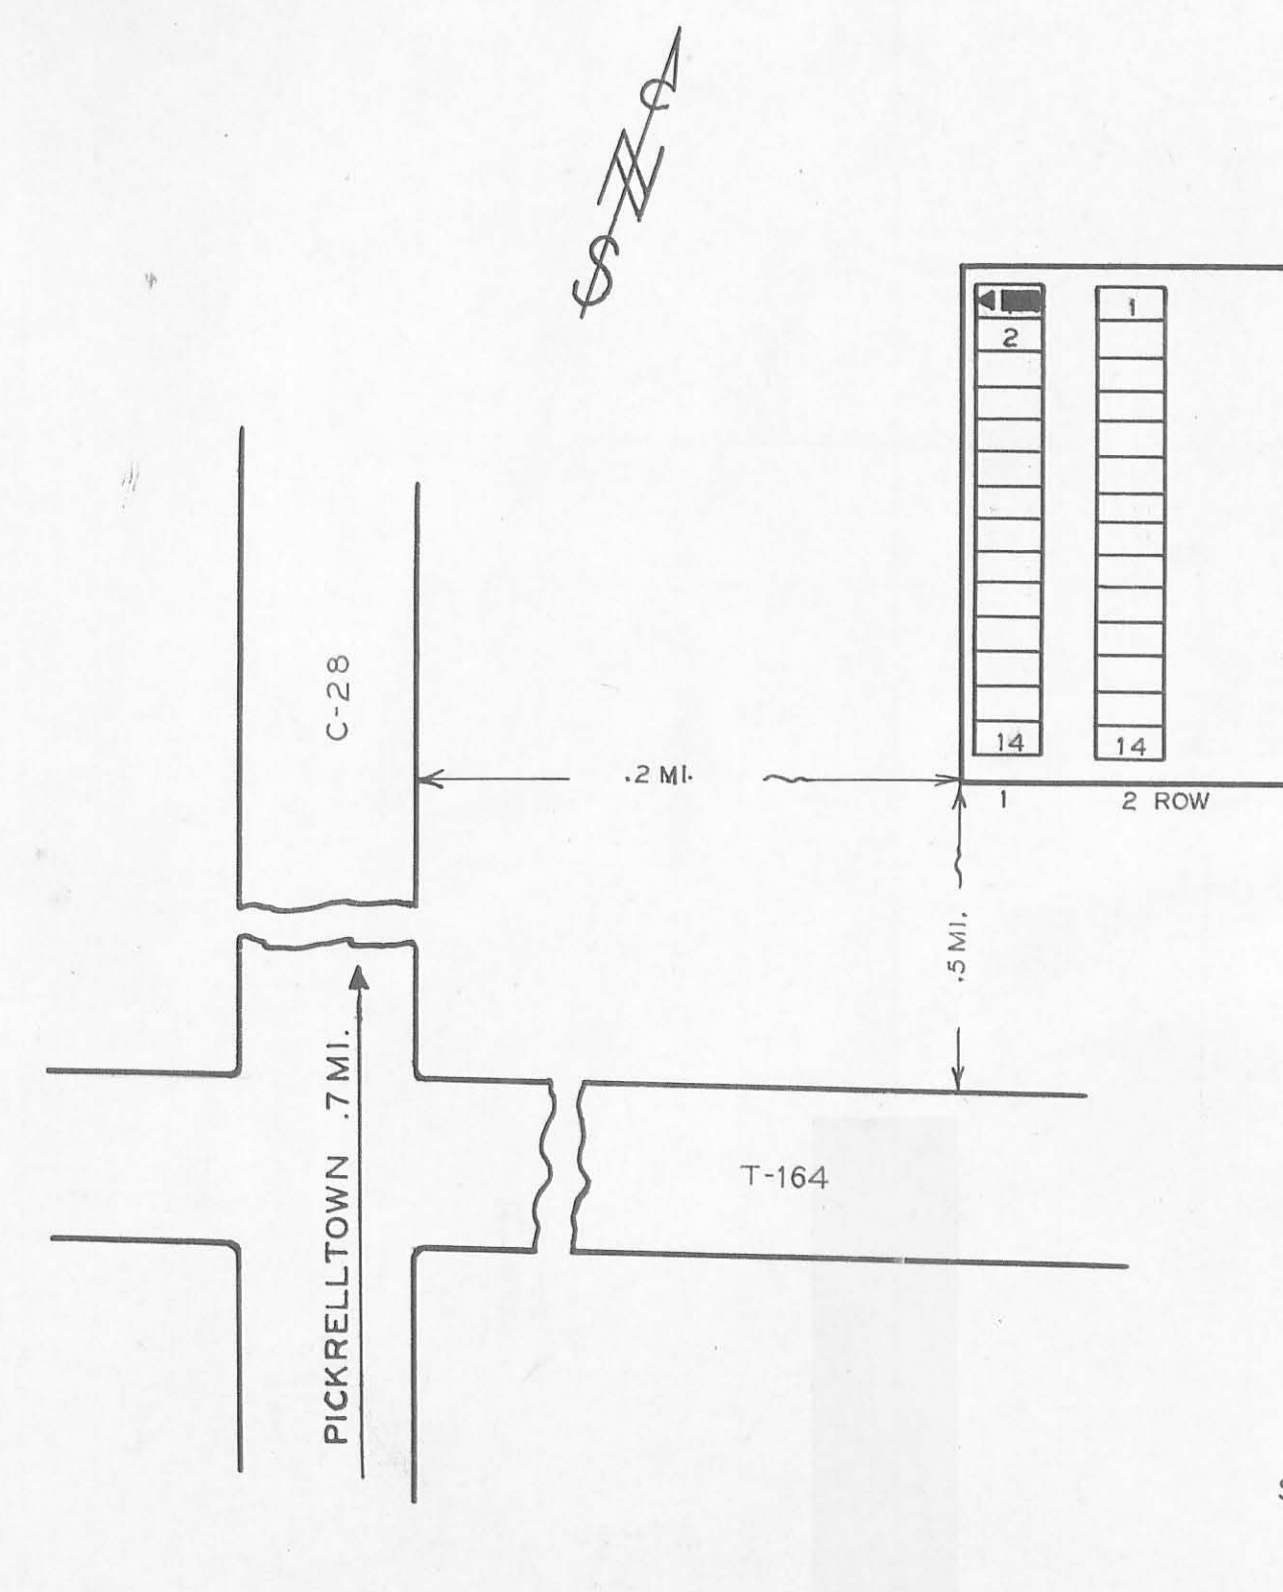


LEGEND  
SEC=SECTION L=LOT R=ROW  
G=GRAVE W=WAR  
X=POSITION UNKNOWN

**GREEN CEMETERY**  
LOGAN CO. MONROE TWP.  
OFFICIAL PROJECT N<sup>o</sup> 465-42-3-467&667-42-3-232

<p><b>LEGEND</b></p> <p>① REVOLUTIONARY WAR ⑩ WAR OF 1812 ⑯ MEXICAN WAR ⑰ CIVIL WAR ⑳ SPANISH-AM WAR ㉑ WORLD WAR</p>	<p><b>HISTORY</b></p> <p>SCALE 1" = 20'</p> <p>ACRES .06</p>
--	--

46-9-10



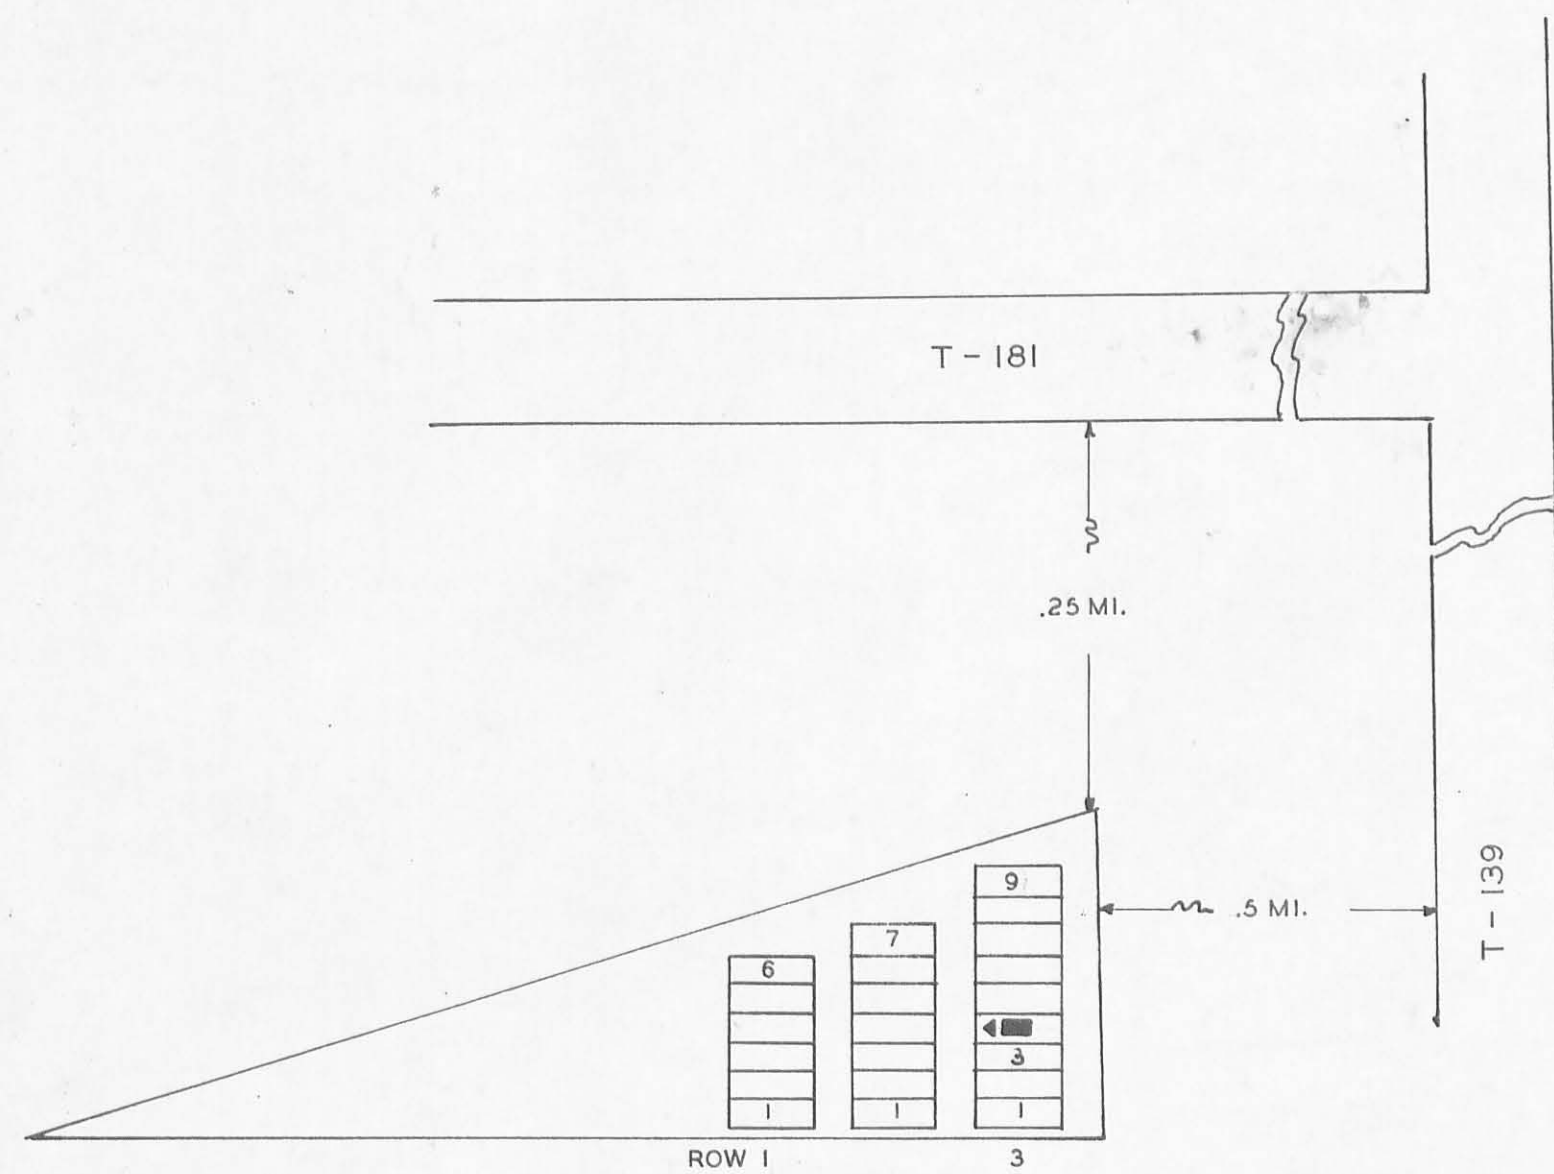


NAME SEC R G W  
 WILKINSON THOMAS 3 4 10

**FILSON FARM CEMETERY**  
 LOGAN CO. JEFFERSON TWP.  
 OFFICIAL PROJECT NOS. 465-42-3-467 & 665-42-3-232

<b>LEGEND</b> ① REVOLUTIONARY WAR ⑩ WAR OF 1812 ⑯ WAR WITH MEXICO ⑰ CIVIL WAR ⑳ SPANISH-AM. WAR ㉑ WORLD WAR	<b>HISTORY</b>      
---	--

SCALE 1"=20' .05 ACRE

46-4-9

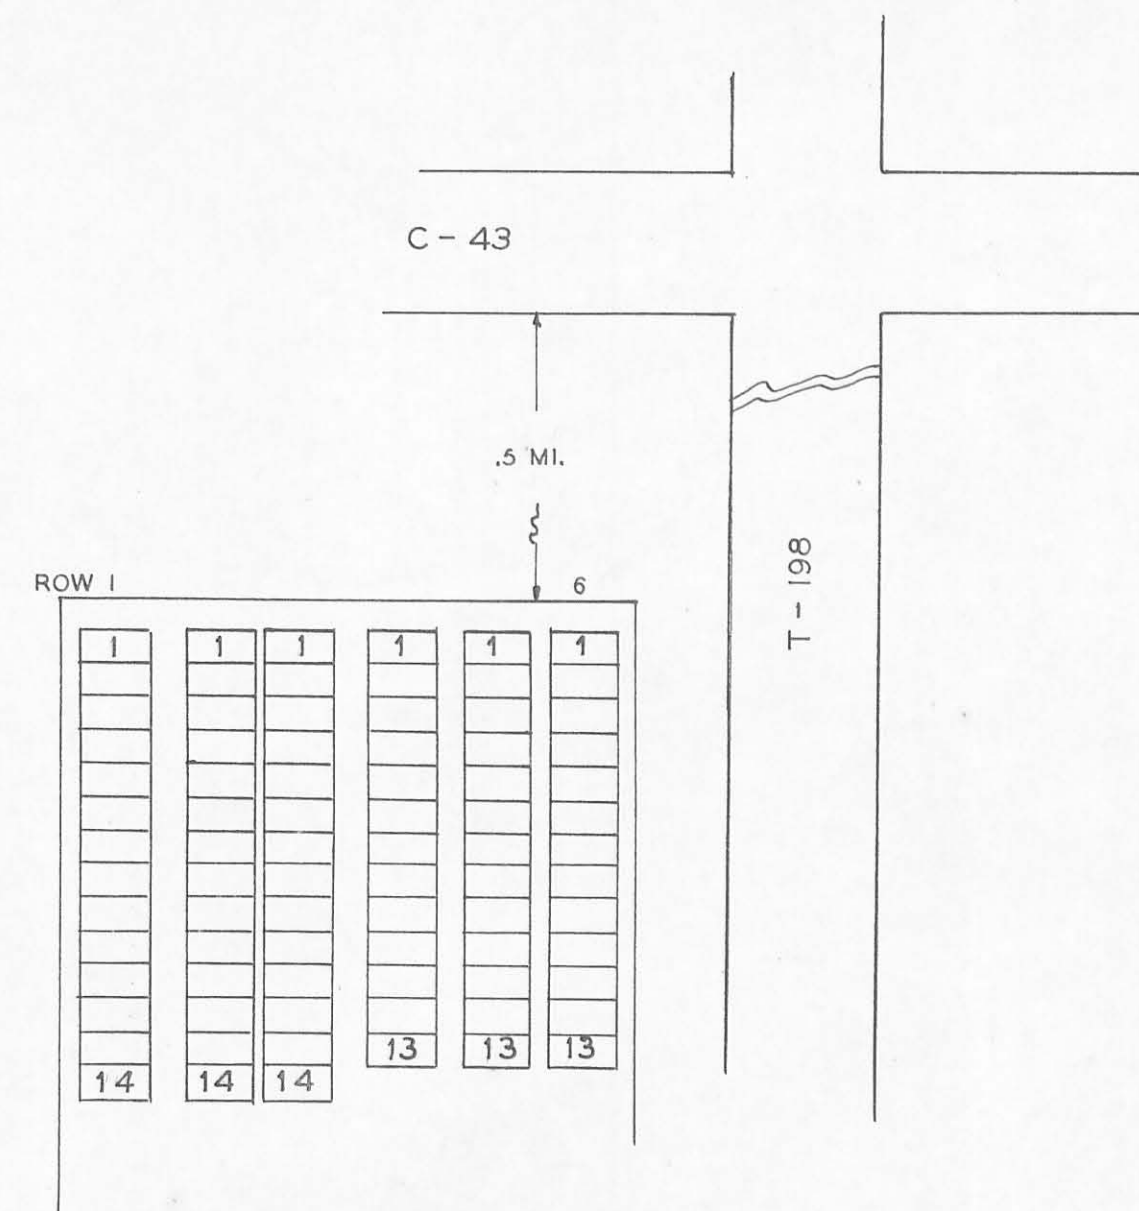


**SAGER CEMETERY**  
 LOGAN CO. UNION TWP.  
 OFFICIAL PROJECT NOS. 465-42-3-467 & 665-42-3-232

<b>LEGEND</b> ① REVOLUTIONARY WAR ⑩ WAR OF 1812 ⑯ WAR WITH MEXICO ⑰ CIVIL WAR ⑳ SPANISH-AM. WAR ㉑ WORLD WAR	<b>HISTORY</b>      
---	--

SCALE 1"=20' .3 ACRE

46-15-4

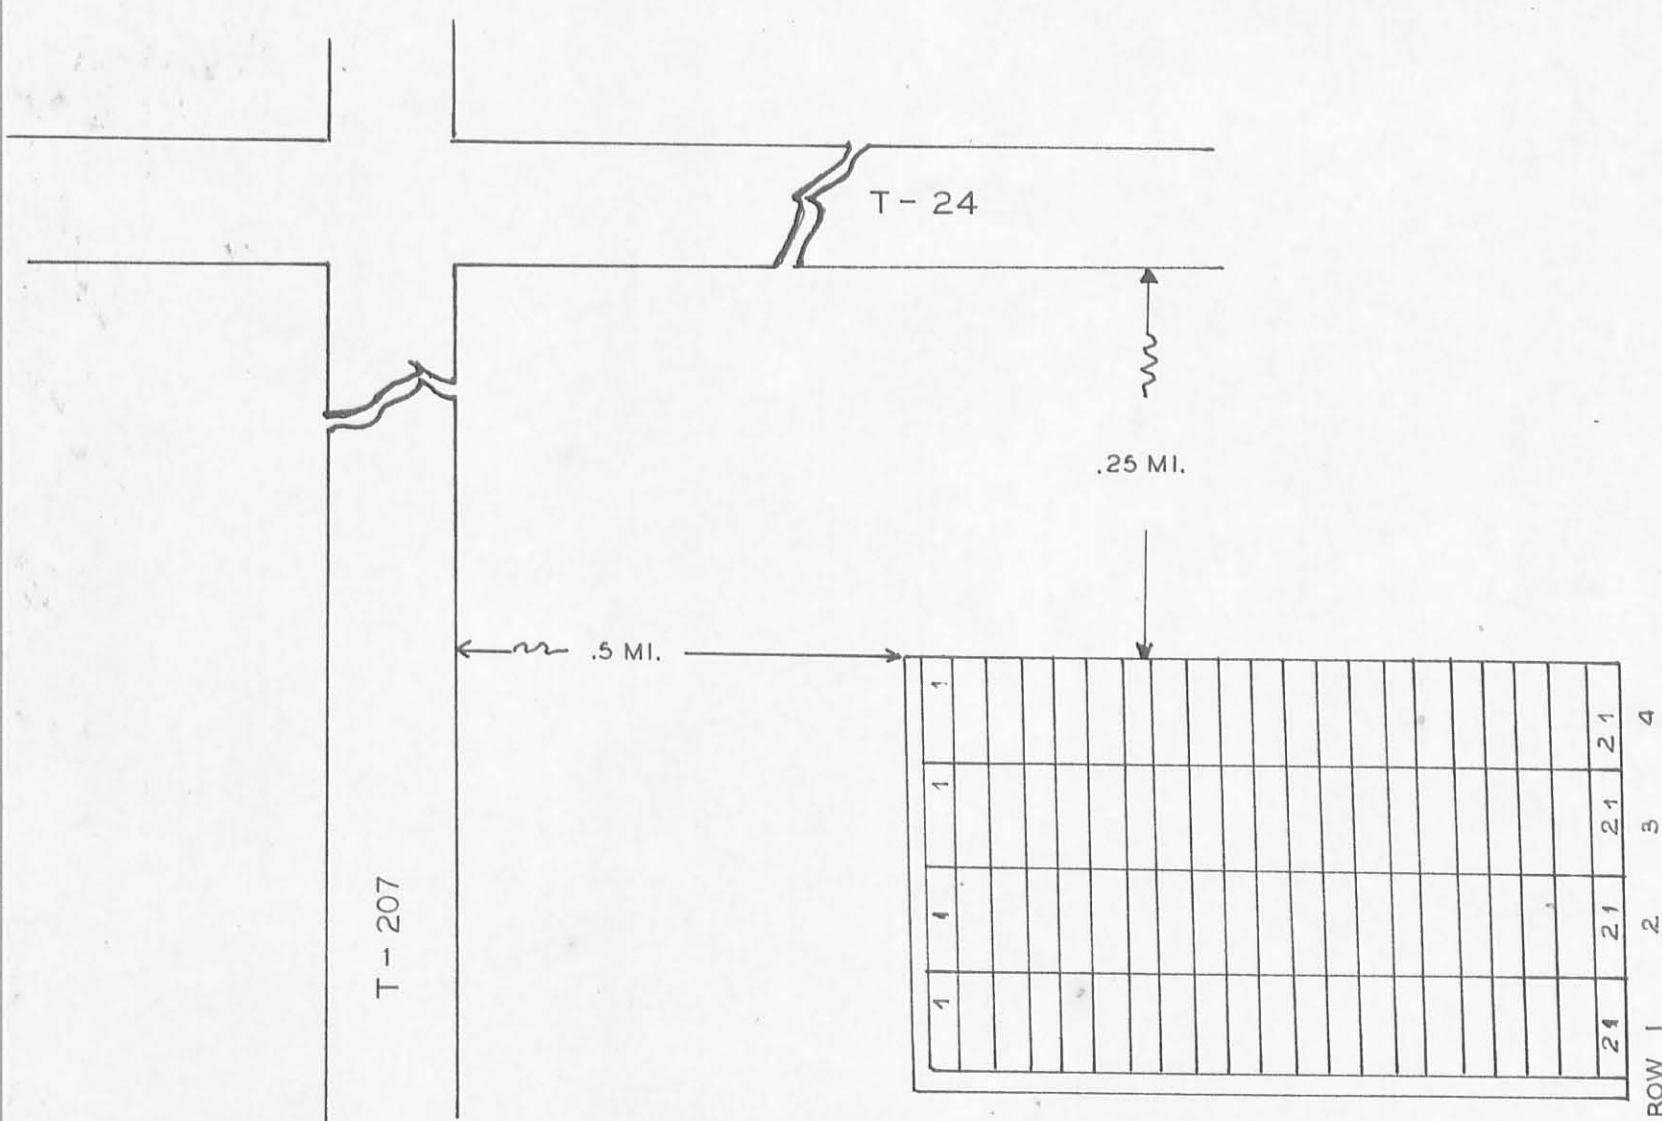


**ROGER FARM CEMETERY**  
 LOGAN CO. WASHINGTON TWP.  
 OFFICIAL PROJECT NOS. 465-42-3-467 & 665-42-3-232

<b>LEGEND</b> ① REVOLUTIONARY WAR ⑩ WAR OF 1812 ⑯ WAR WITH MEXICO ⑰ CIVIL WAR ⑳ SPANISH-AM. WAR ○ WORLD WAR	<b>HISTORY</b>      
---	--

SCALE 1"=20' .3 ACRE

46-16-4

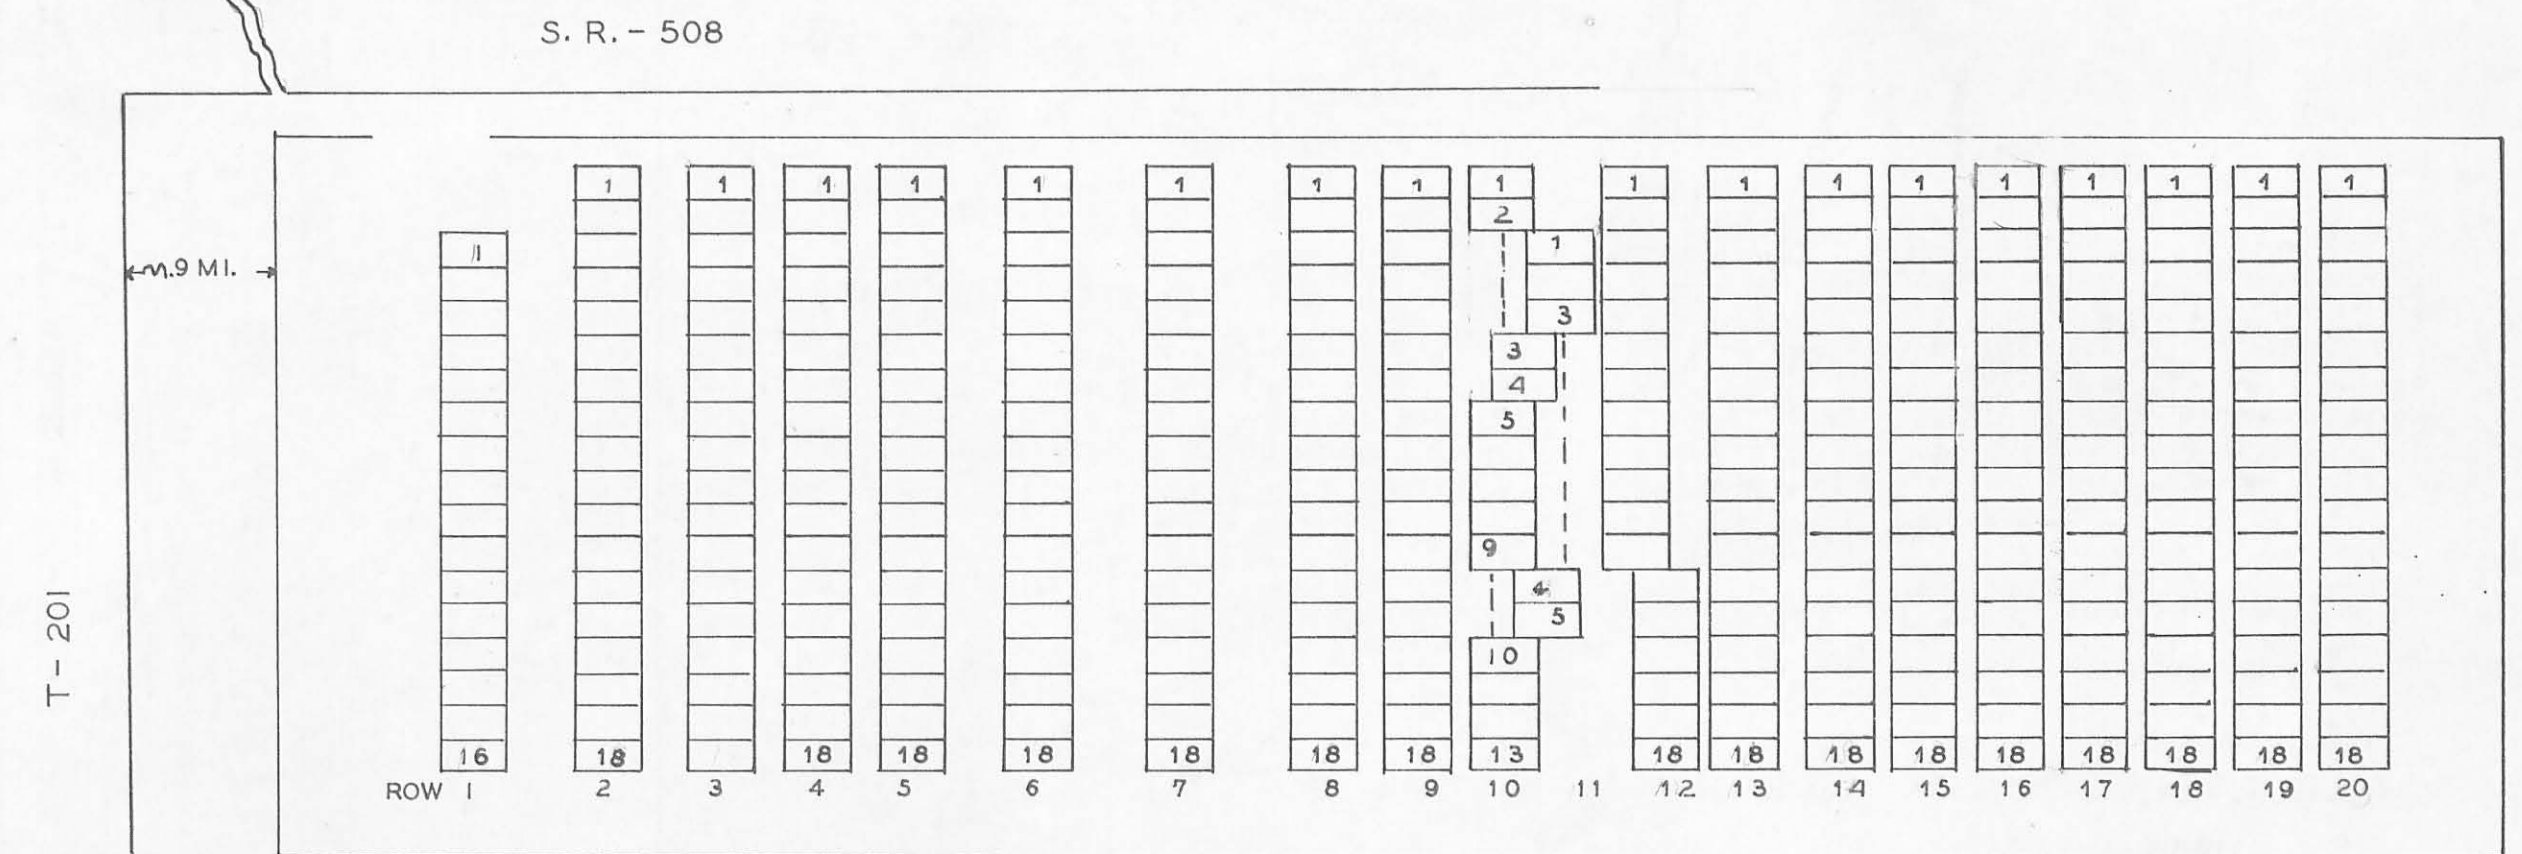

**ALEXANDRIA CEMETERY**  
 LOGAN CO. UNION TWP.  
 OFFICIAL PROJECT NOS. 465-42-3-467 & 665-42-3-232

<b>LEGEND</b> ① REVOLUTIONARY WAR ⑩ WAR OF 1812 ⑯ WAR WITH MEXICO ⑰ CIVIL WAR ⑳ SPANISH-AM. WAR ㉑ WORLD WAR	<b>HISTORY</b>      
---	--

SCALE 1"=20' 1. ACRE


46-15-2

**LEGEND**  
 SEG-SECTION L-LOT R-ROW  
 G-GRAVE W-WAR  
 X-POSITION UNKNOWN



S. R. - 69

C - 64

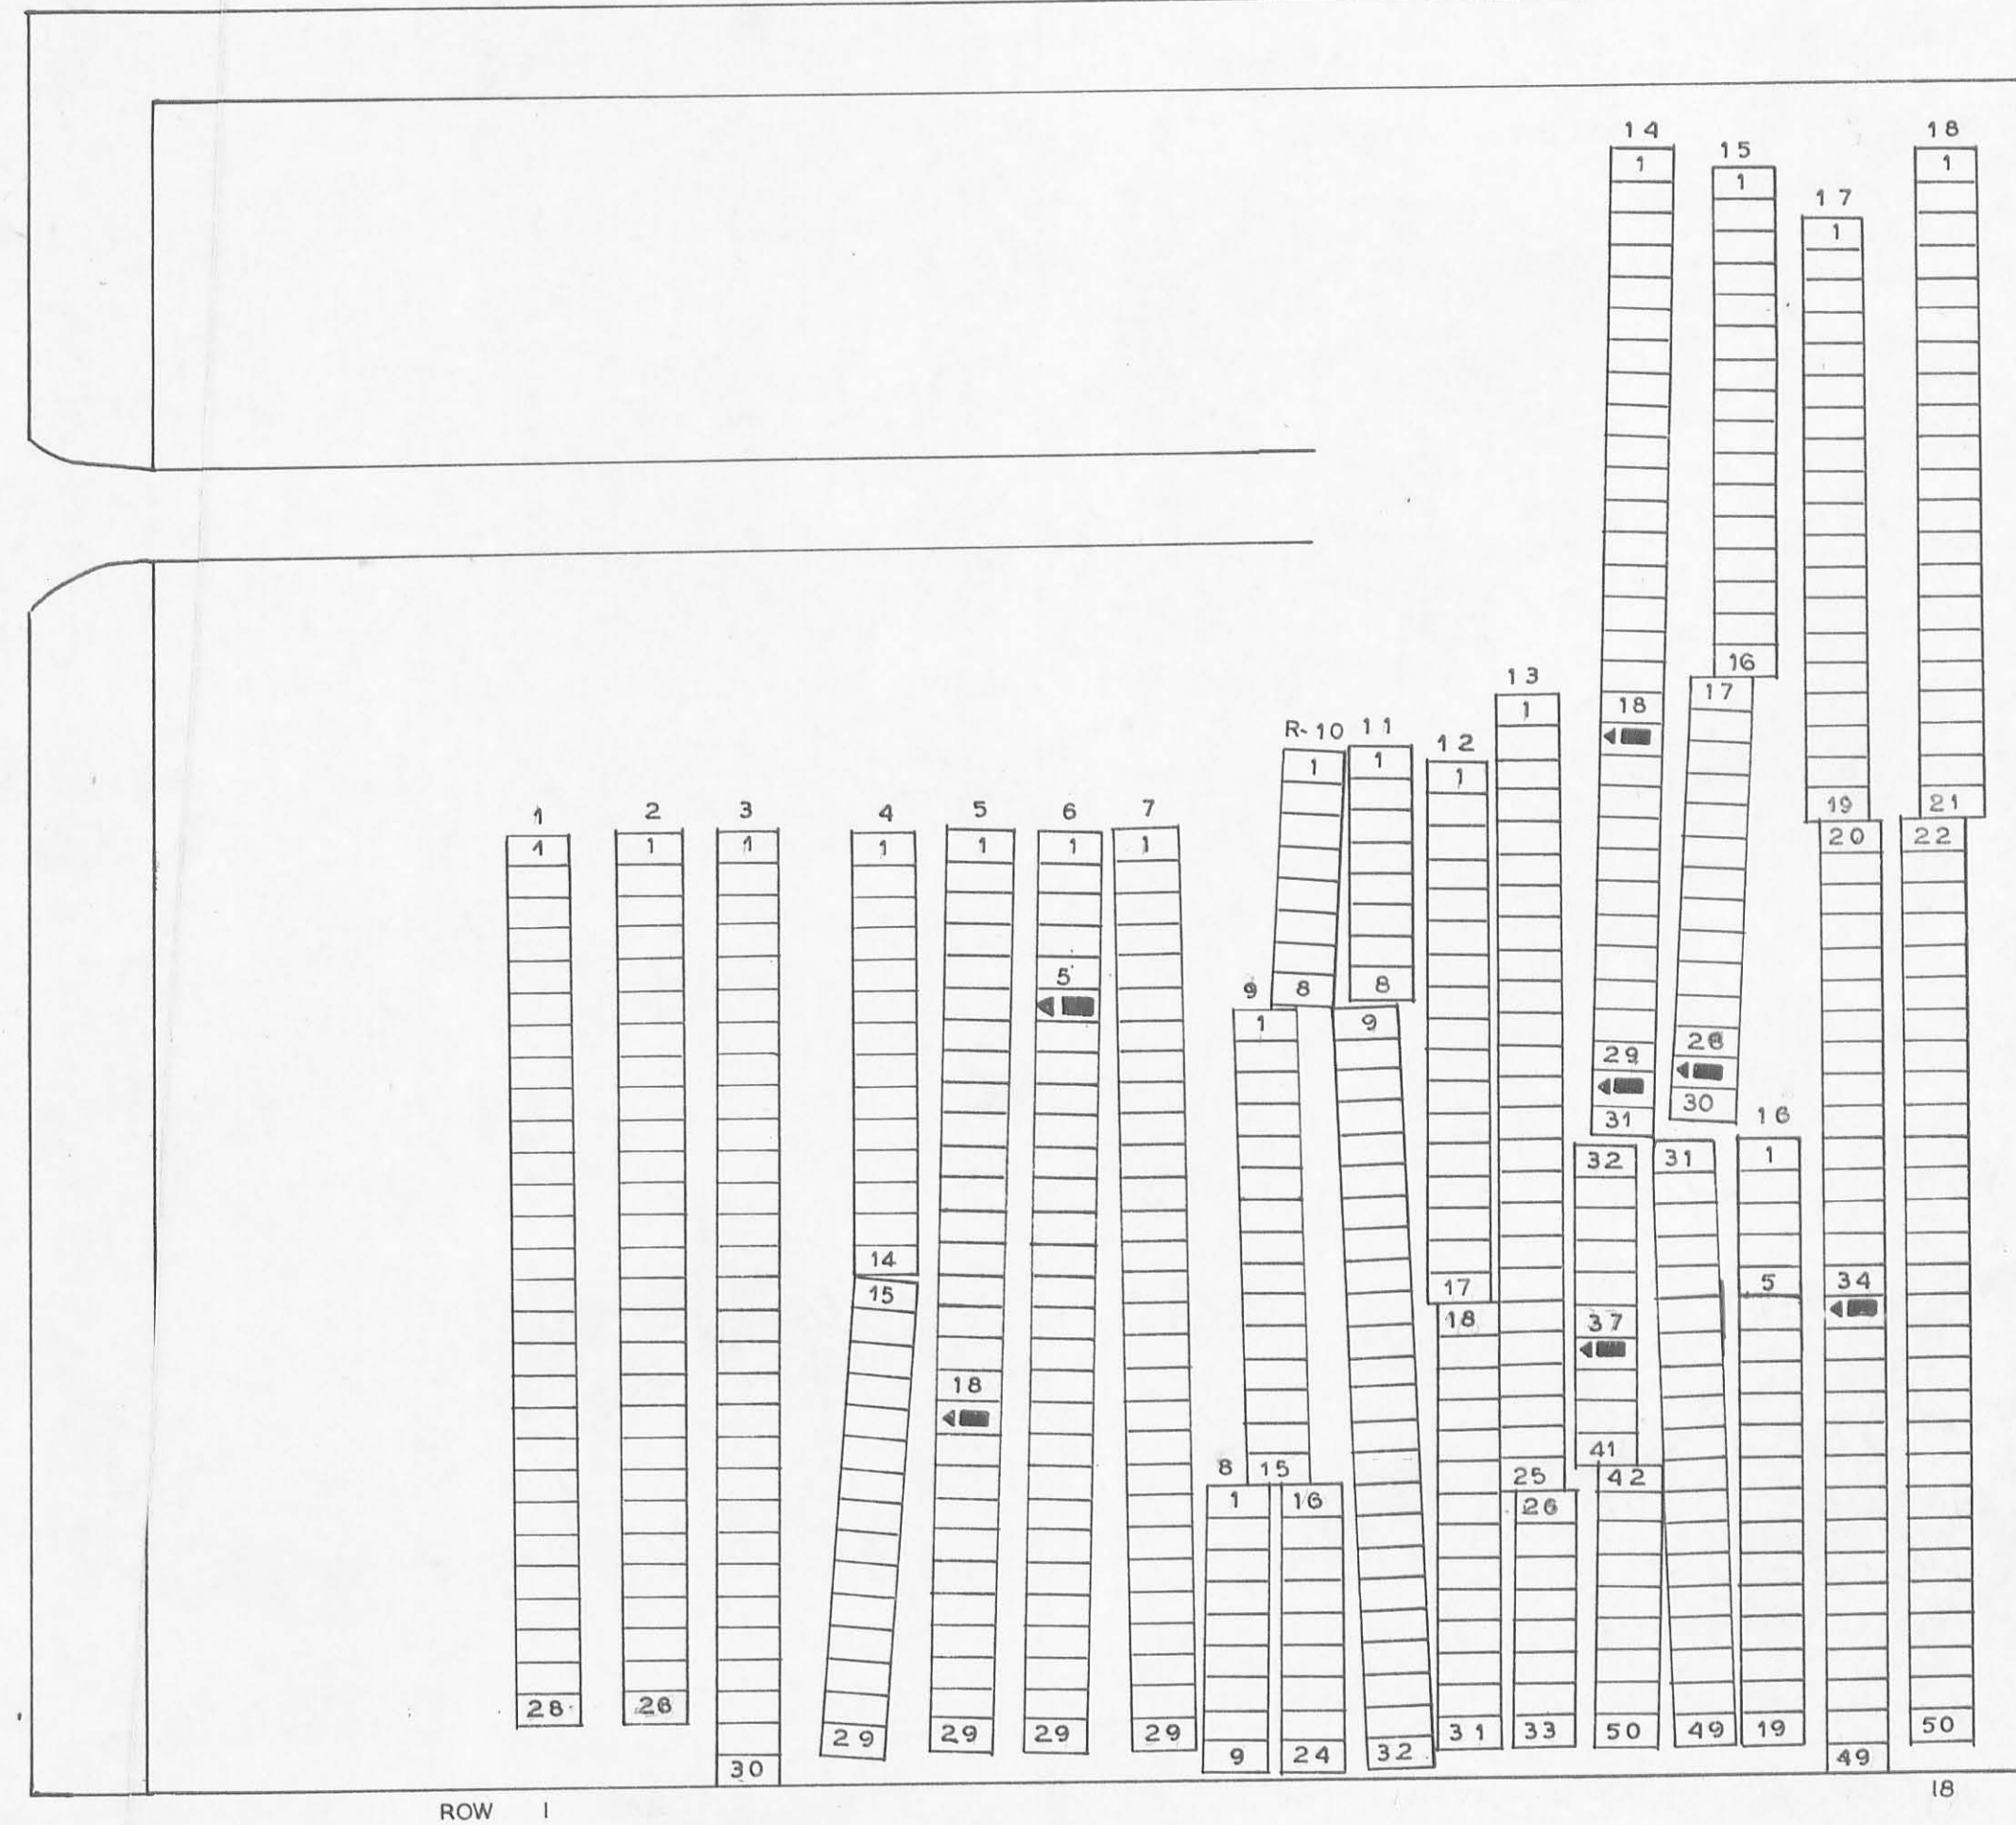

NAME	SEC	R	G	W
CURL WM.	15	29	1	
PRICHARD JARE)	17	35	1	
ROADS GEORGE	5	19	10	
SAILOR JOSEPH	14	19	19	
SAYRE JOHN	14	38	10	
SPARRING JAMES N.	14	30	19	
SPELLMAN HENRY M.	6	16	19	

## OLIVE CHAPEL CEMETERY

LOGAN CO. MIAMI TWP.

OFFICIAL PROJECT NOS. 465-42-3-467 & 665-42-3-232


<b>LEGEND</b> ① REVOLUTIONARY WAR ⑩ WAR OF 1812 ⑯ WAR WITH MEXICO ⑲ CIVIL WAR ⑳ SPANISH AM. WAR ⑳ WORLD WAR	<b>HISTORY</b>       1.1 ACRES
---	---

SCALE 1"=20'

46-8-1

S. R. - 706

S. R. - 69

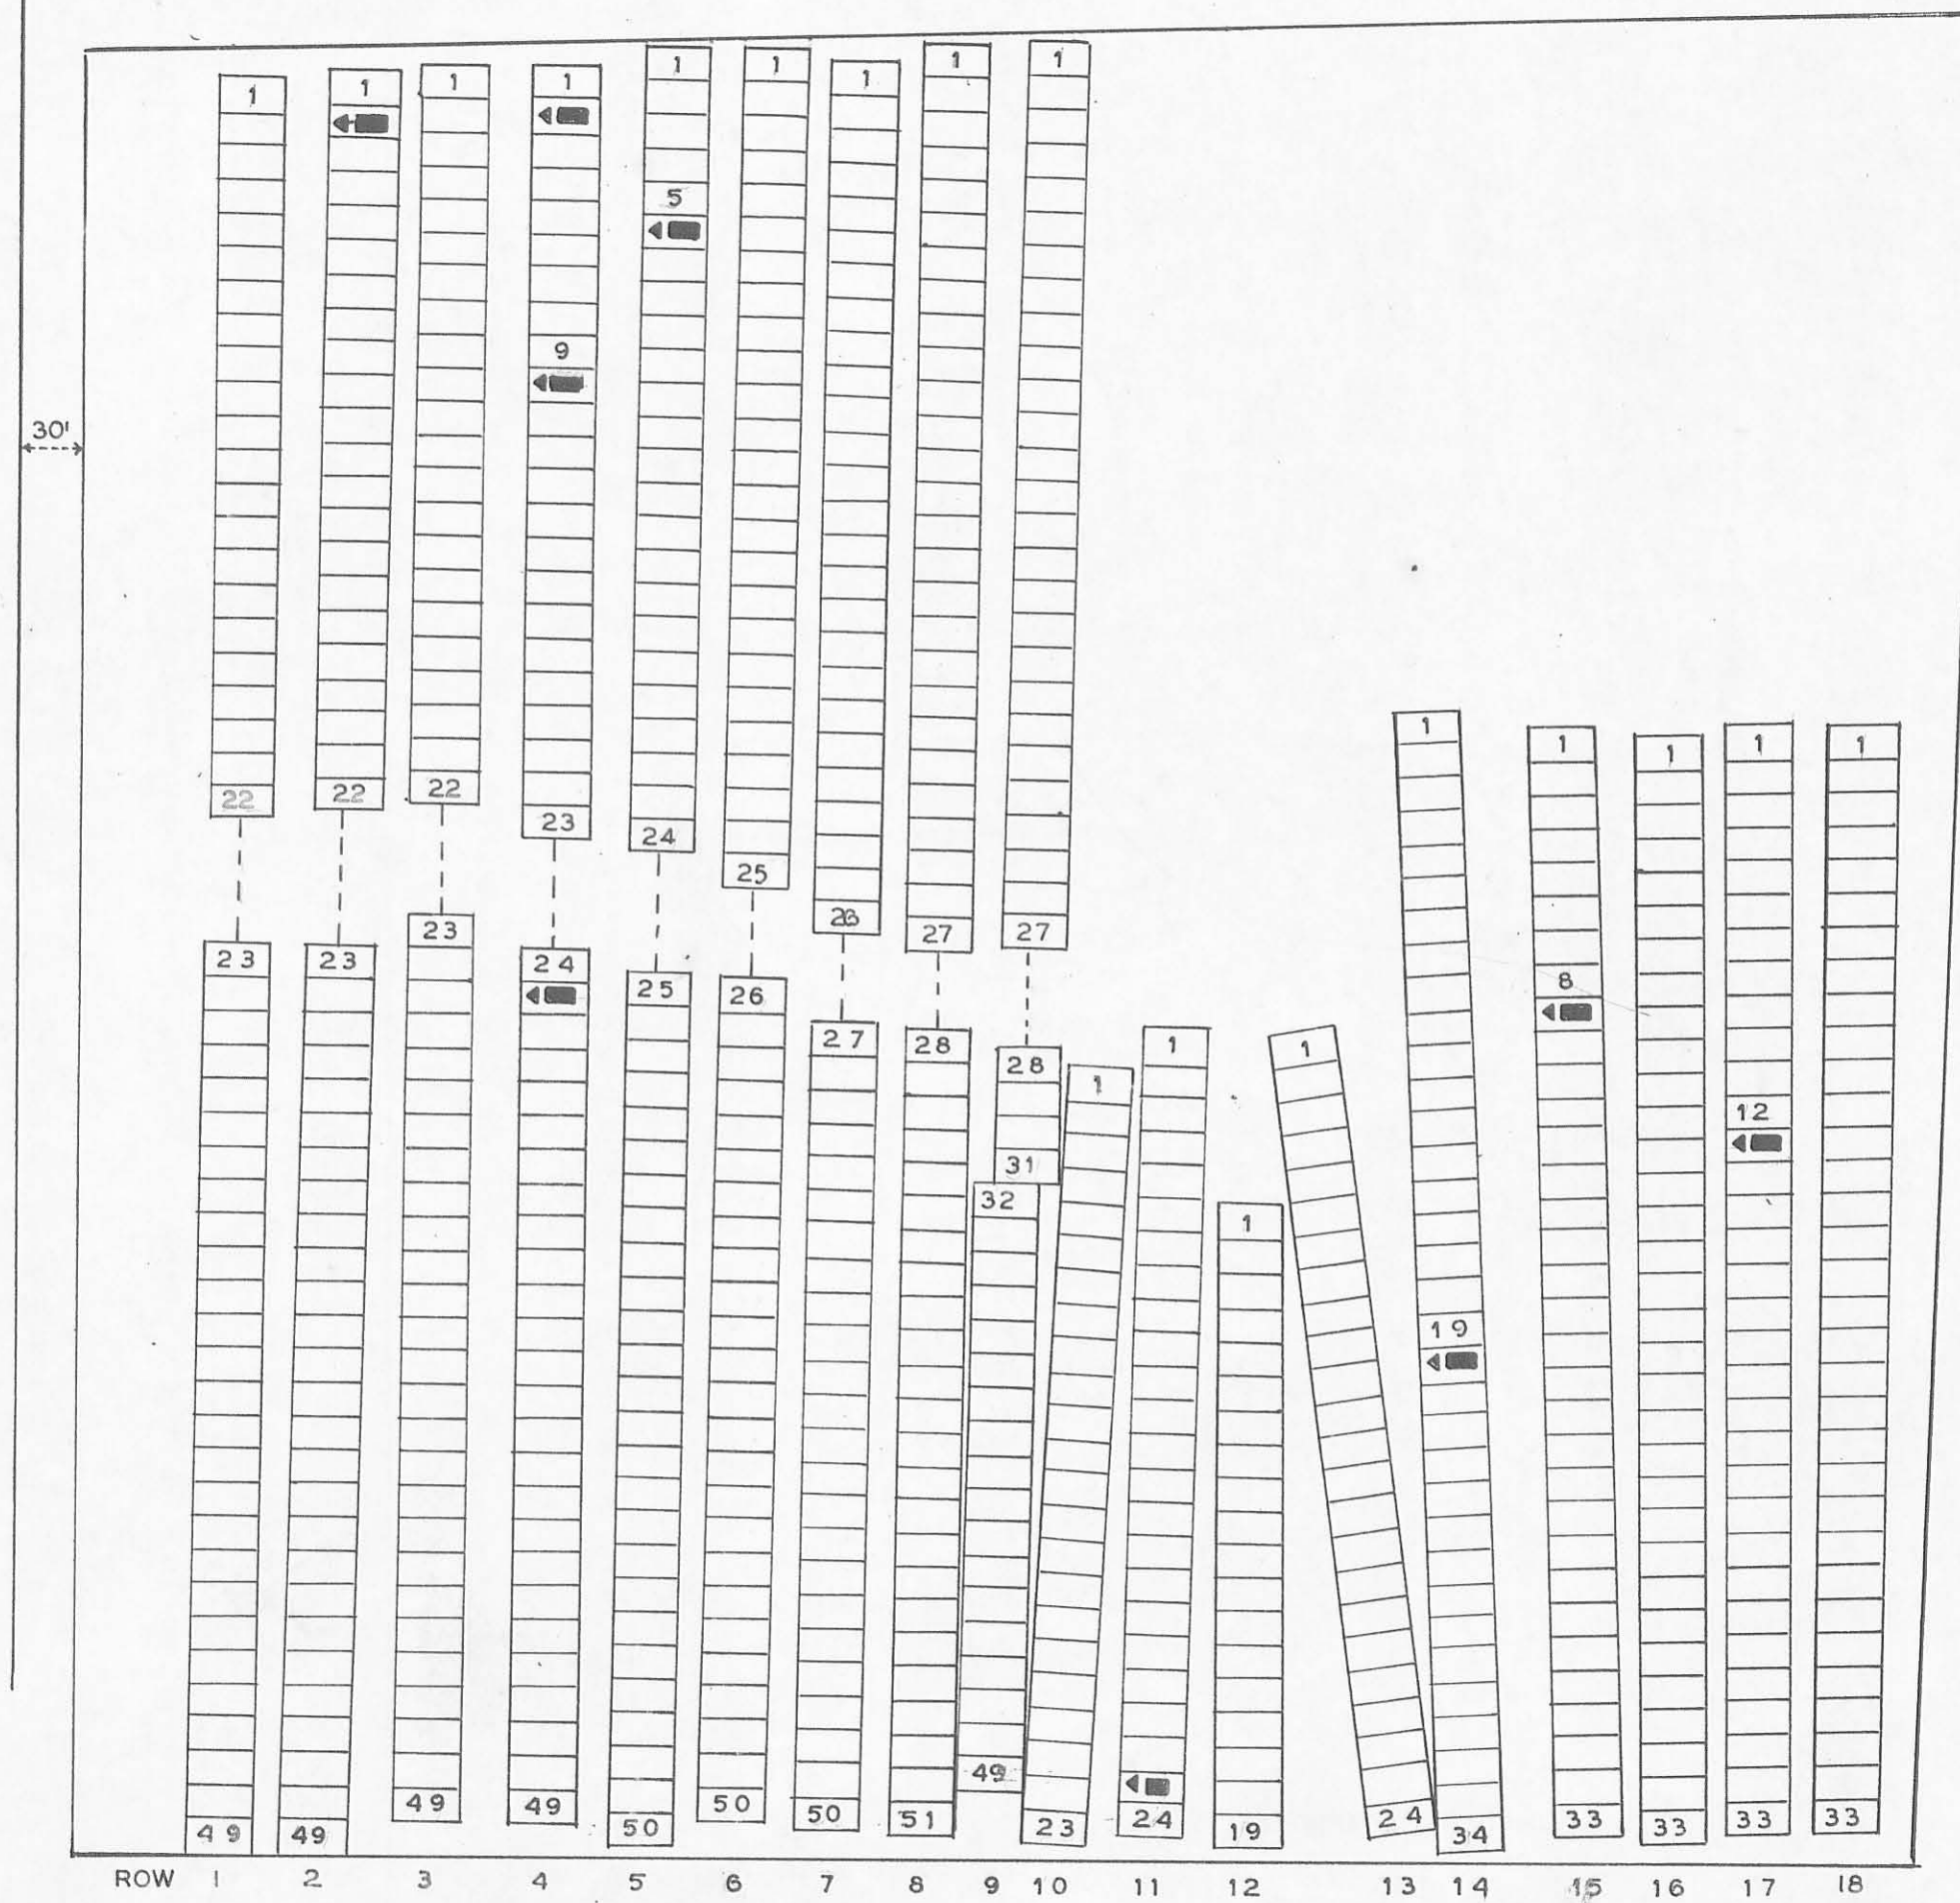

NAME	SEC	R	G	W
BALL THOMAS R.	14	20	19	
CHAMBERS MANLOVE	17	13	10	
DUTTON WILLIAM J.	4	25	19	
JORDAN JOHN S.	15	9	19	
MCKINIE CHARLES	2	2	19	
ROBBINS ISAAC	11	23		
STILES ELI B.	5	6	19	
THROCKMORTON WM. L.	4	2	19	
WEBB J. R.	4	10		

## COST CEMETERY

LOGAN CO. MIAMI TWP.

OFFICIAL PROJECT NOS. 465-42-3-467 & 665-42-3-232


<b>LEGEND</b> ① REVOLUTIONARY WAR ⑩ WAR OF 1812 ⑯ WAR WITH MEXICO ⑲ CIVIL WAR ⑳ SPANISH AM. WAR ⑳ WORLD WAR	<b>HISTORY</b>       1.2 ACRES
---	---

SCALE 1"=20'

46-8-4



NAME	SEC	L	R	G	W
COSTIN S. W. B.	68			1	19
DOWNING BAZIL	76			4	19
DOWNING ROBERT	86			5	19
EPLEY SAMUEL	19			2	19
FORD PETER	27			3	19
JONES JAMES	61			1	19
PUSEY JOHN	13			3	19
SHUMATE LEWIS	58			5	19

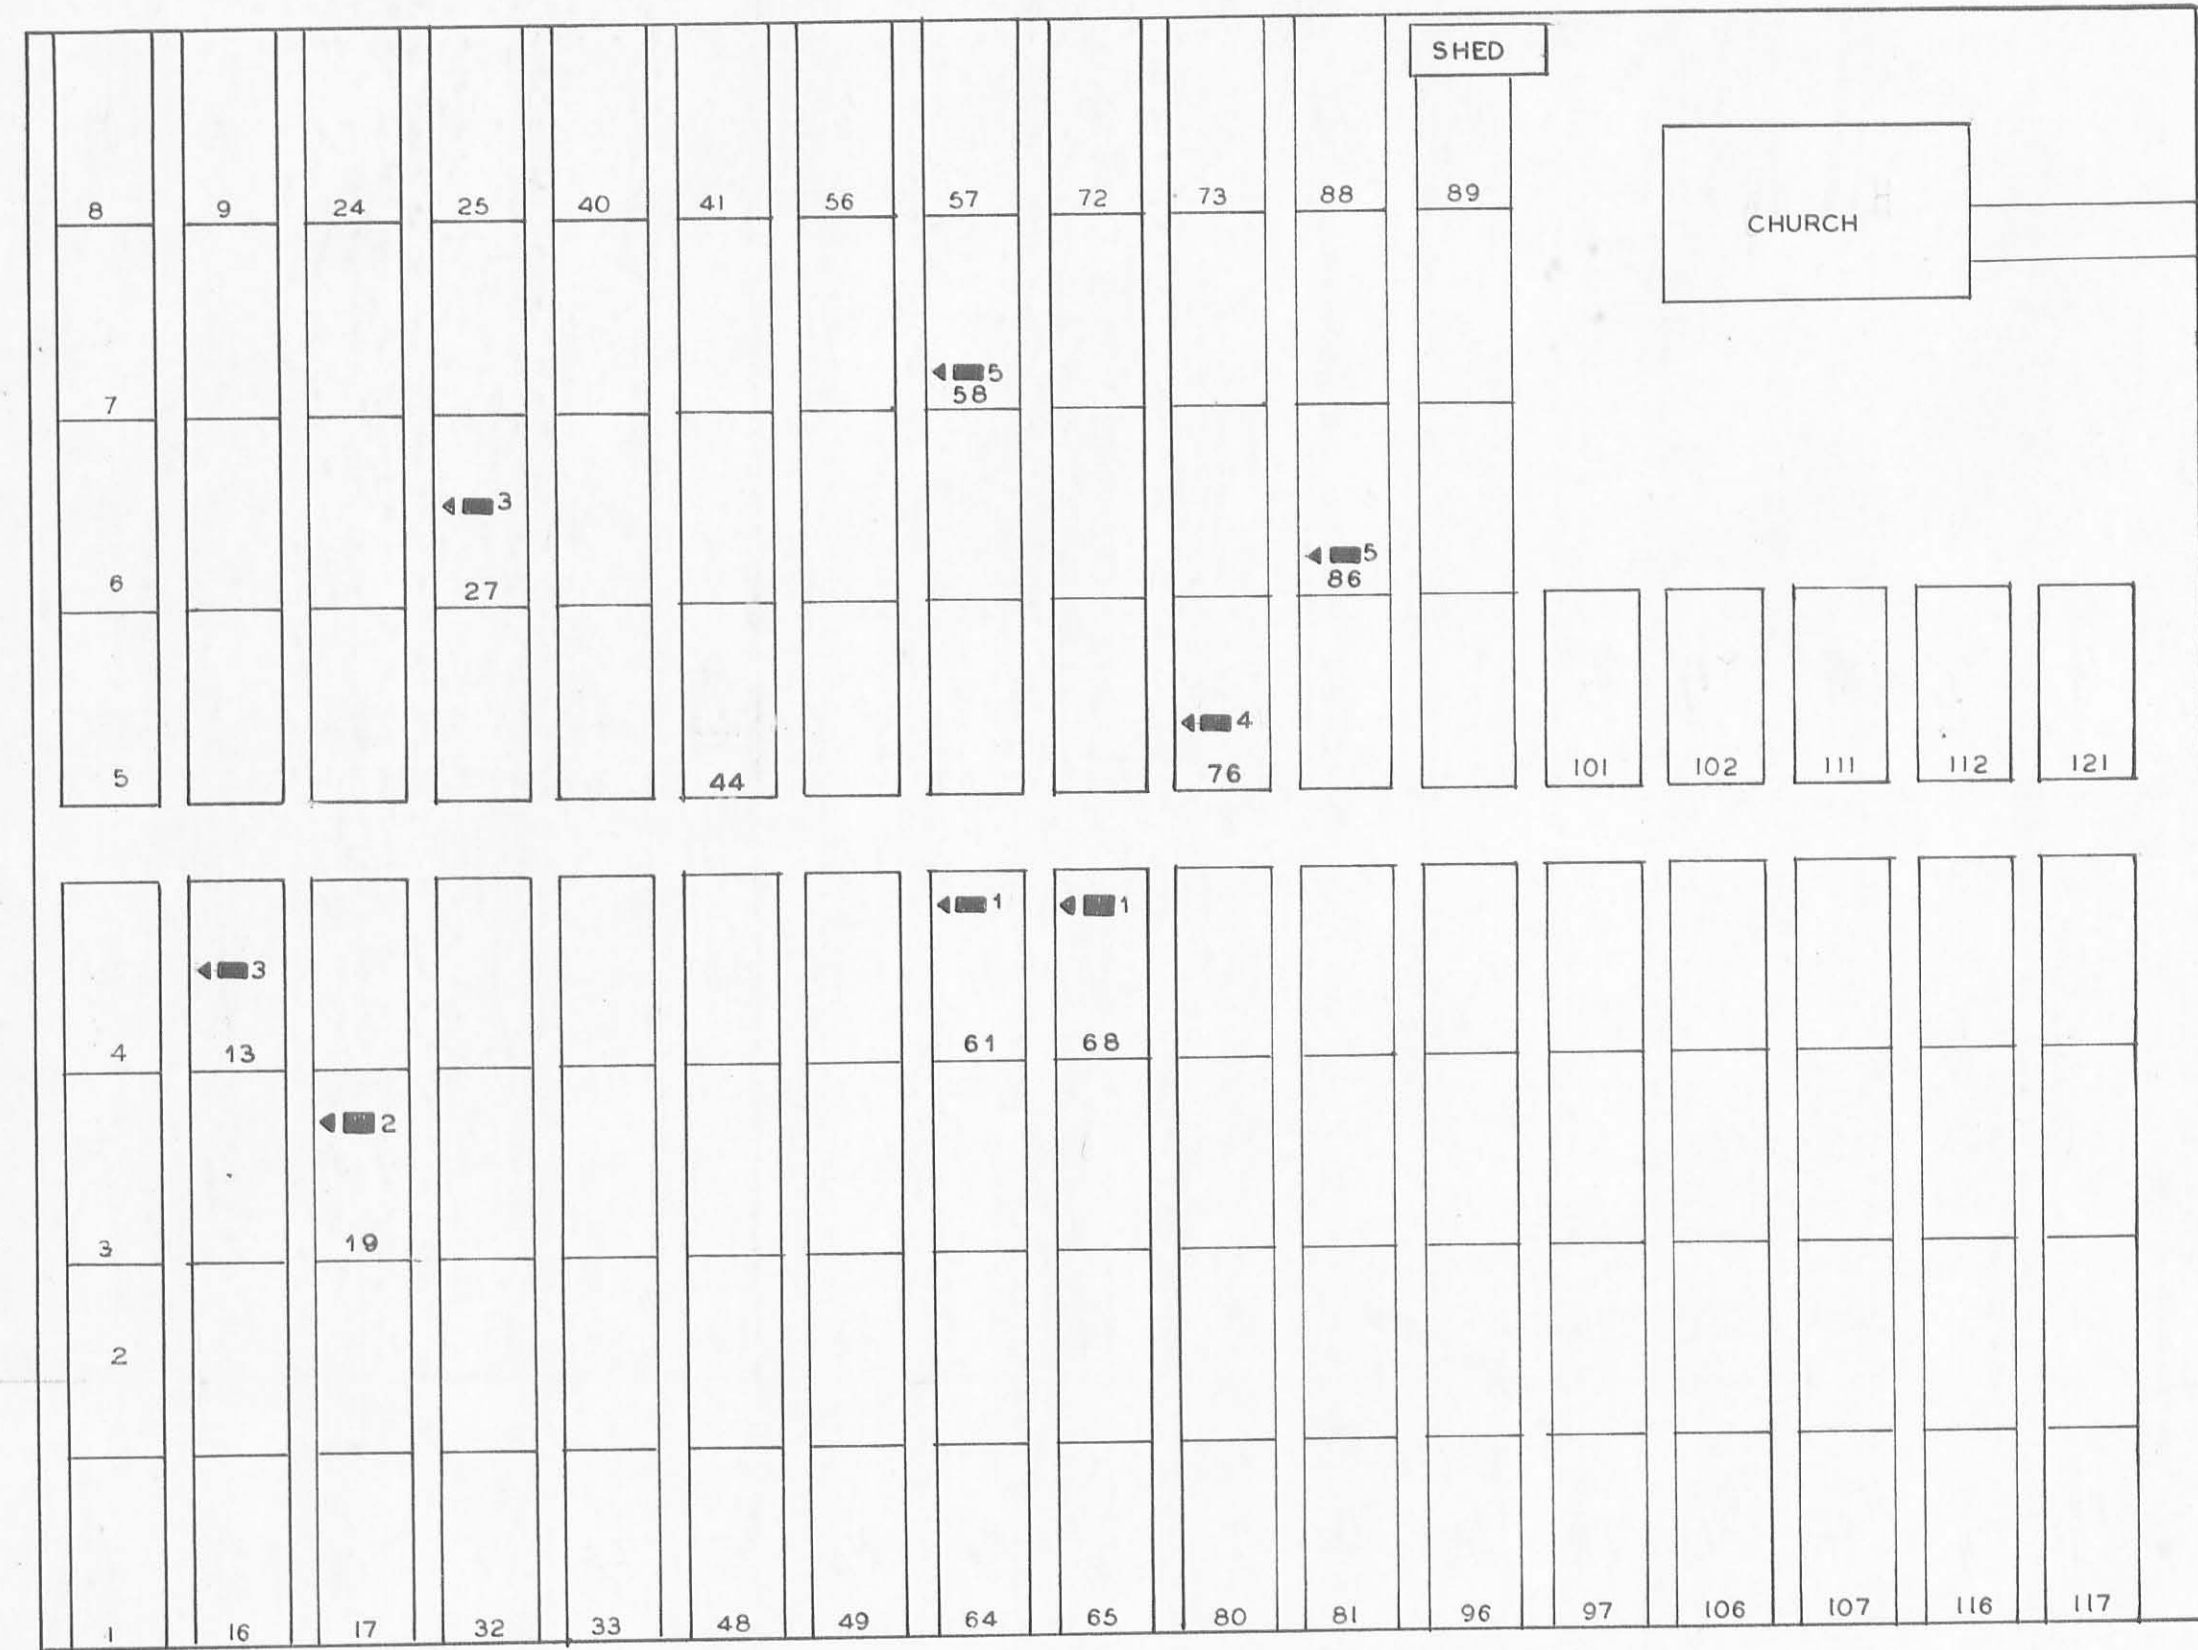


**MT. ZION CEMETERY**  
 LOGAN CO. JEFFERSON TWP.  
 OFFICIAL PROJECT NOS. 465-423-467&665-42-3-232

<b>LEGEND</b>	<b>HISTORY</b>
① REVOLUTIONARY WAR	
⑩ WAR OF 1812	
⑮ WAR WITH MEXICO	
⑲ CIVIL WAR	
⑳ SPANISH-AM. WAR	
⑳ WORLD WAR	

1. ACRE

46-4-5

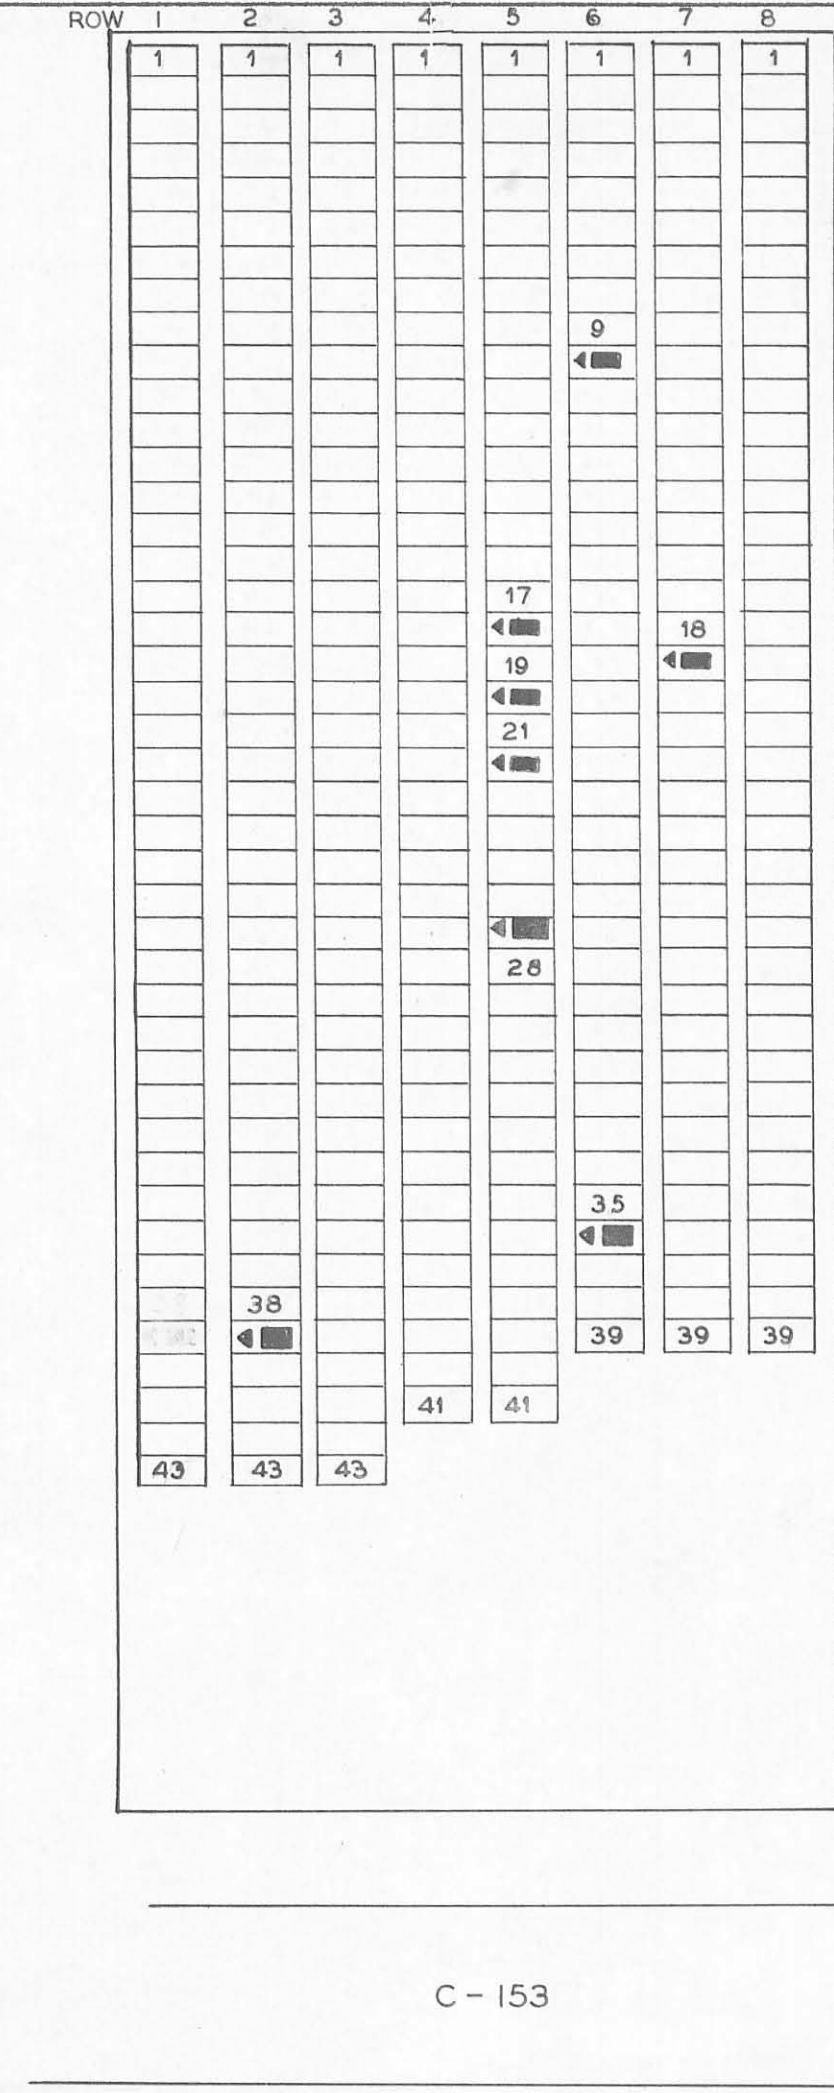

NAME	SEC	L	R	G	W
COLE JORDAN S	5			22	19
HANKIN WILLIAM	5			20	19
HOWE SELDON N	5			18	19
MATEC JONATHAN W	6			10	19
TAYLOR JAMES	6			36	
TAYLOR JOHN	2			39	19
YOUNG JEHU W	7			19	19
HARDING EDWARD	5			27	10


SCALE 1"=20'

**MARMON CEMETERY**  
 LOGAN CO. JEFFERSON TWP.  
 OFFICIAL PROJECT NOS. 465-423-467&665-423-232

<b>LEGEND</b>	<b>HISTORY</b>
① REVOLUTIONARY WAR	
⑩ WAR OF 1812	
⑮ WAR WITH MEXICO	
⑲ CIVIL WAR	
⑳ SPANISH-AM. WAR	
⑳ WORLD WAR	

1. ACRE

46-4-3

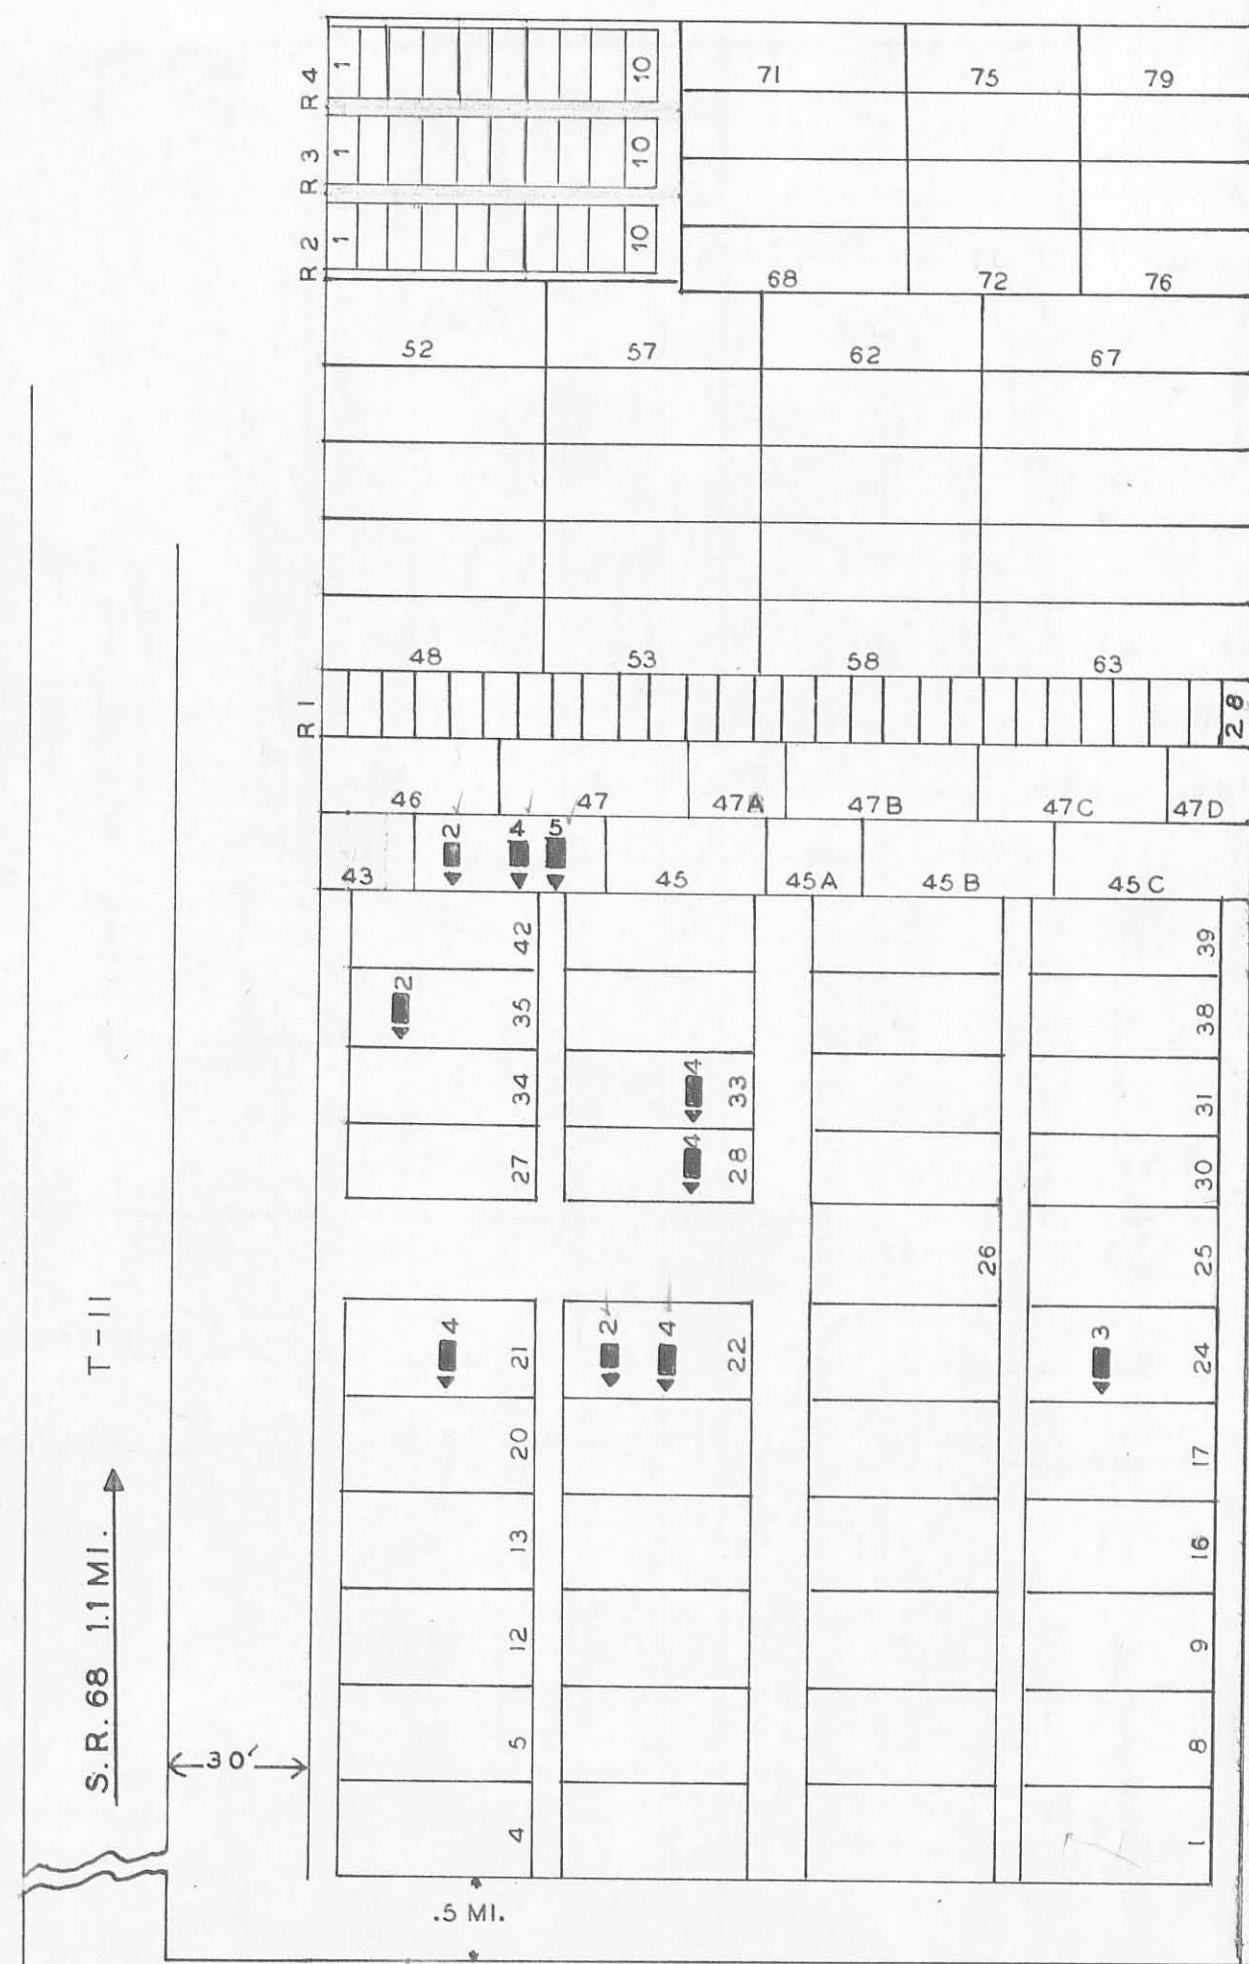

NAME	SEC	L	R	G	W
DAY JOSEPH	28			4	19
DETRICK JOHN	35			2	19
DETRICK PETER	24			3	19
DUNSON E	22			2	
GOOD JACOB	22			4	10
HARMAN WILLIAM	21			4	19
KAYLOR W H	33			4	
ROYER JOHN	44			2	10
ROYER JEREMIAH	44			4	
ROYER WILLIAM	44			5	16

SCALE 1"=20'

**BLUE JACKET CEMETERY**  
 LOGAN CO. HARRISON TWP.  
 OFFICIAL PROJECT NOS. 465-423-467&665-423-232



<b>LEGEND</b>	<b>HISTORY</b>
① REVOLUTIONARY WAR	
⑩ WAR OF 1812	
⑮ WAR WITH MEXICO	
⑲ CIVIL WAR	
⑳ SPANISH-AM. WAR	
⑳ WORLD WAR	

1. ACRE


46-3-1

LEGEND  
 SEC=SECTION L=LOT R=ROW  
 G=GRAVE W=WAR  
 \* = POSITION UNKNOWN



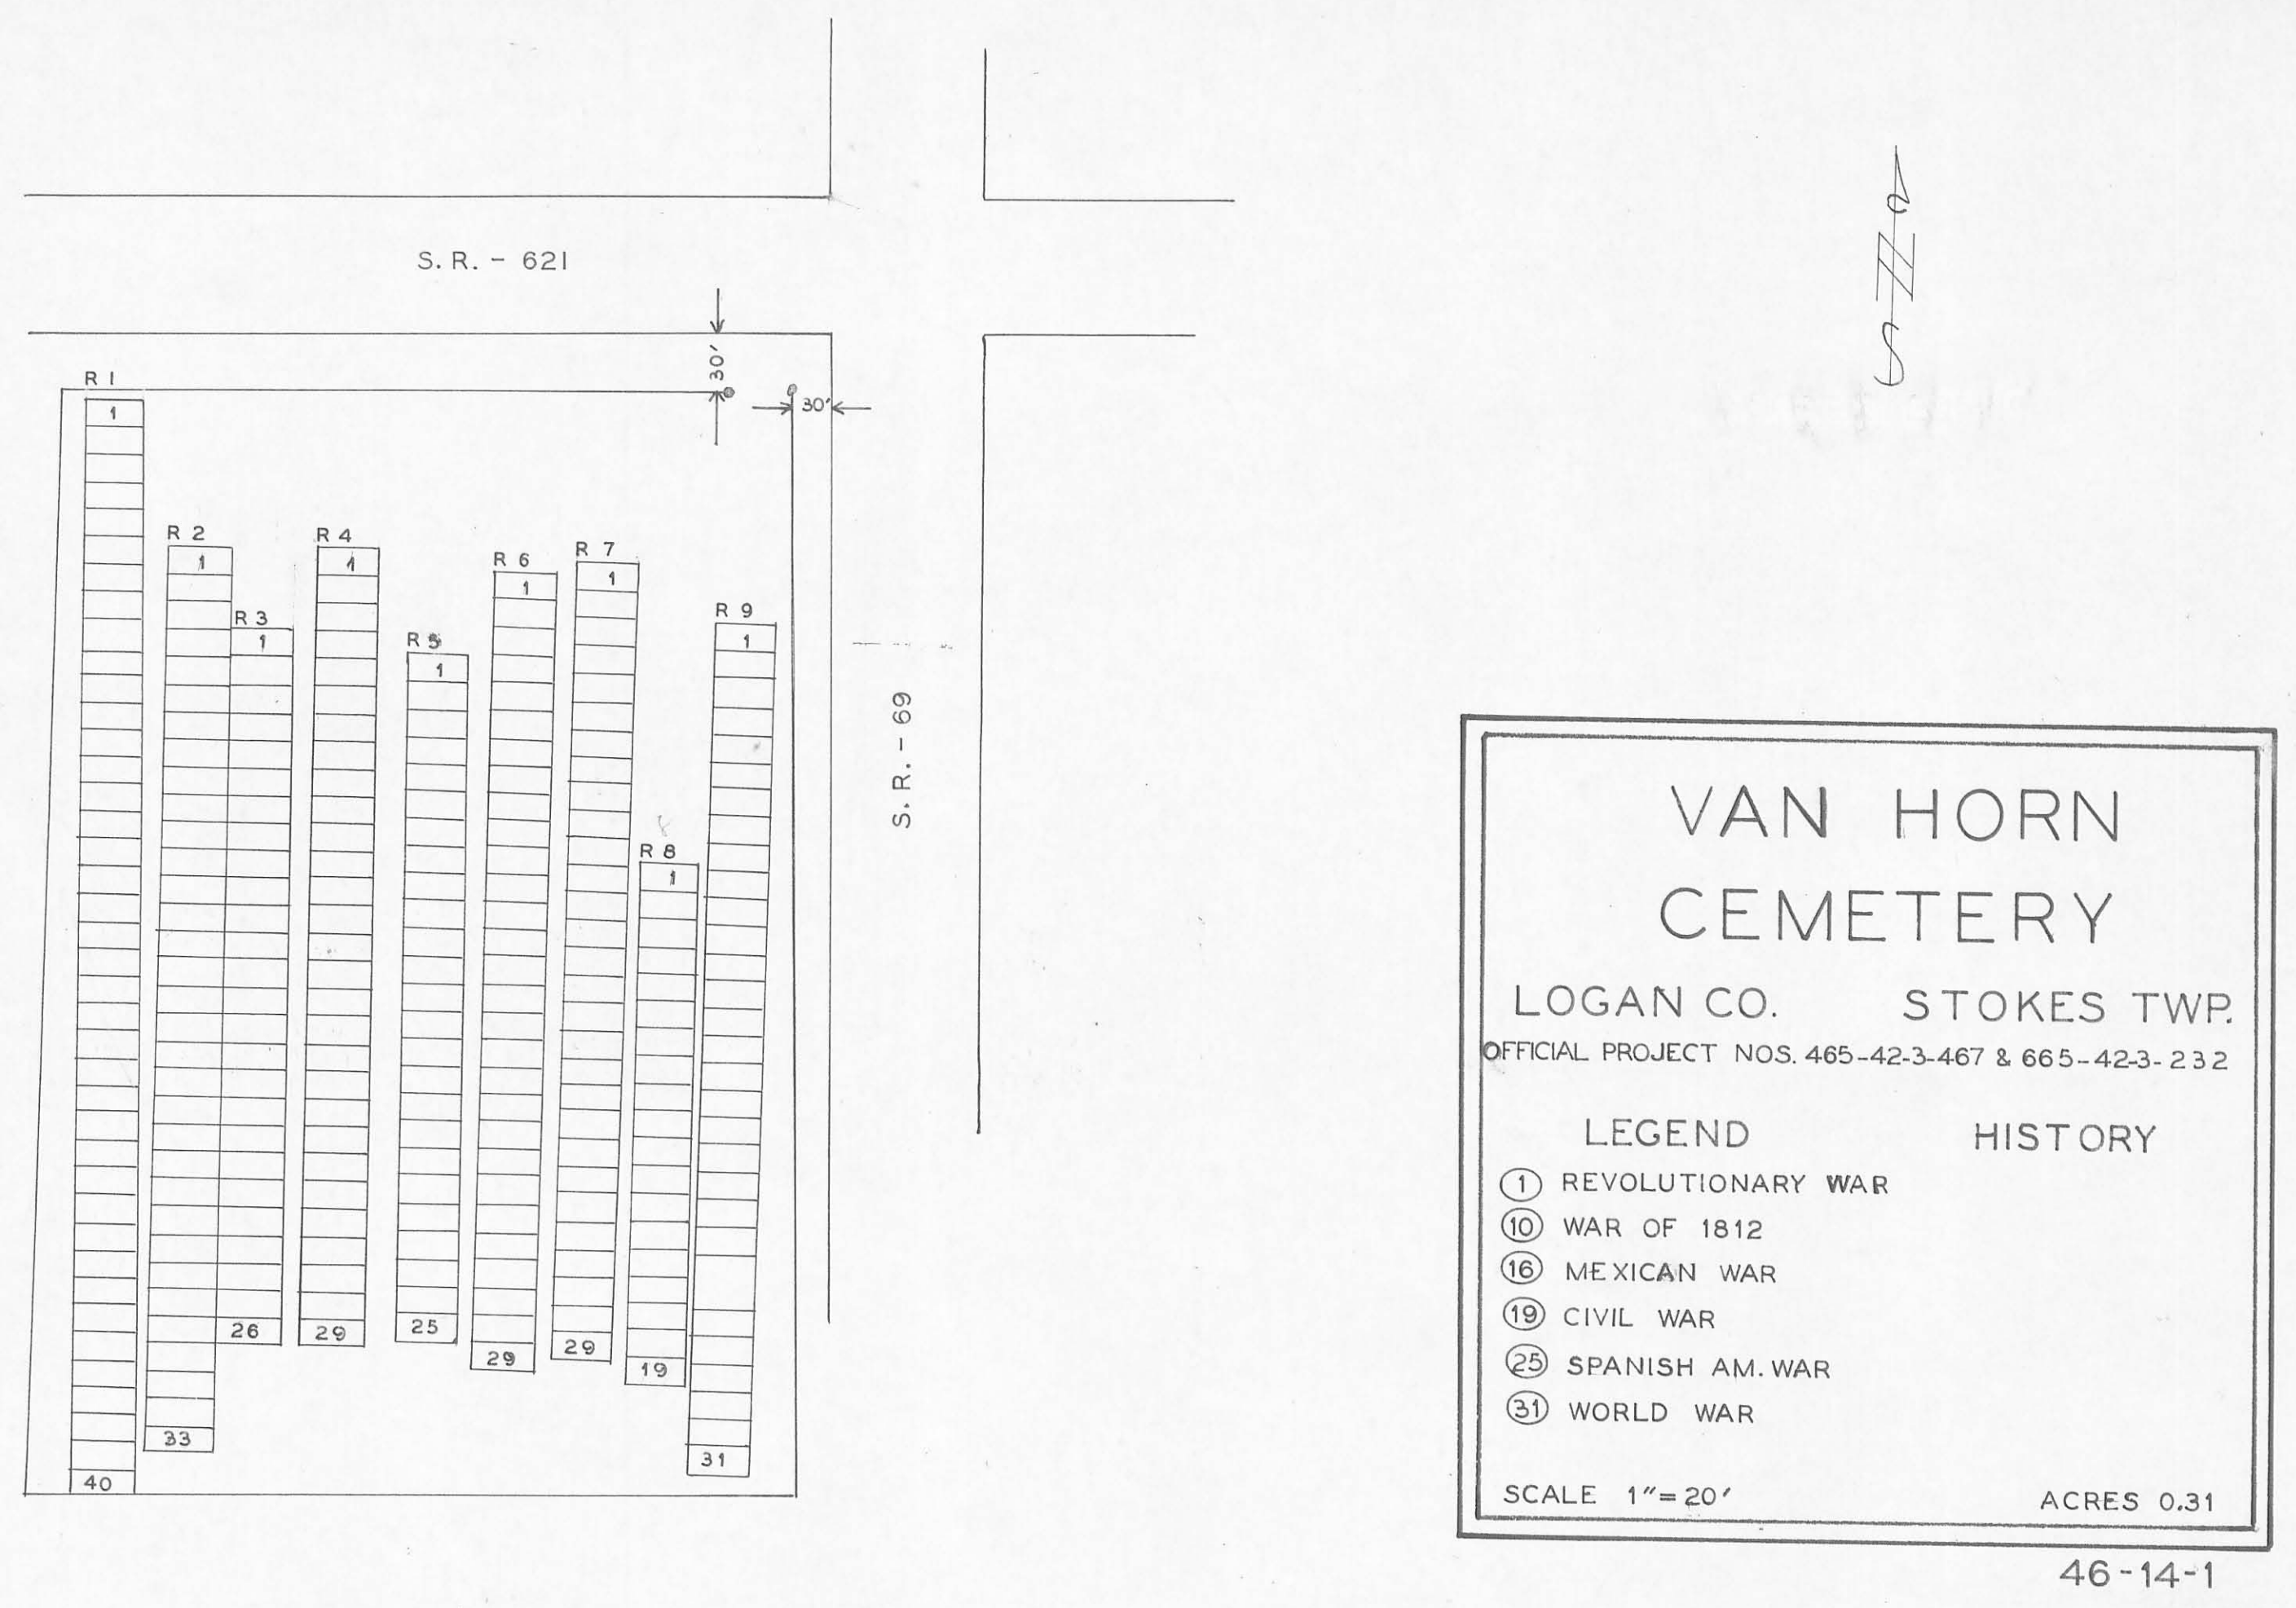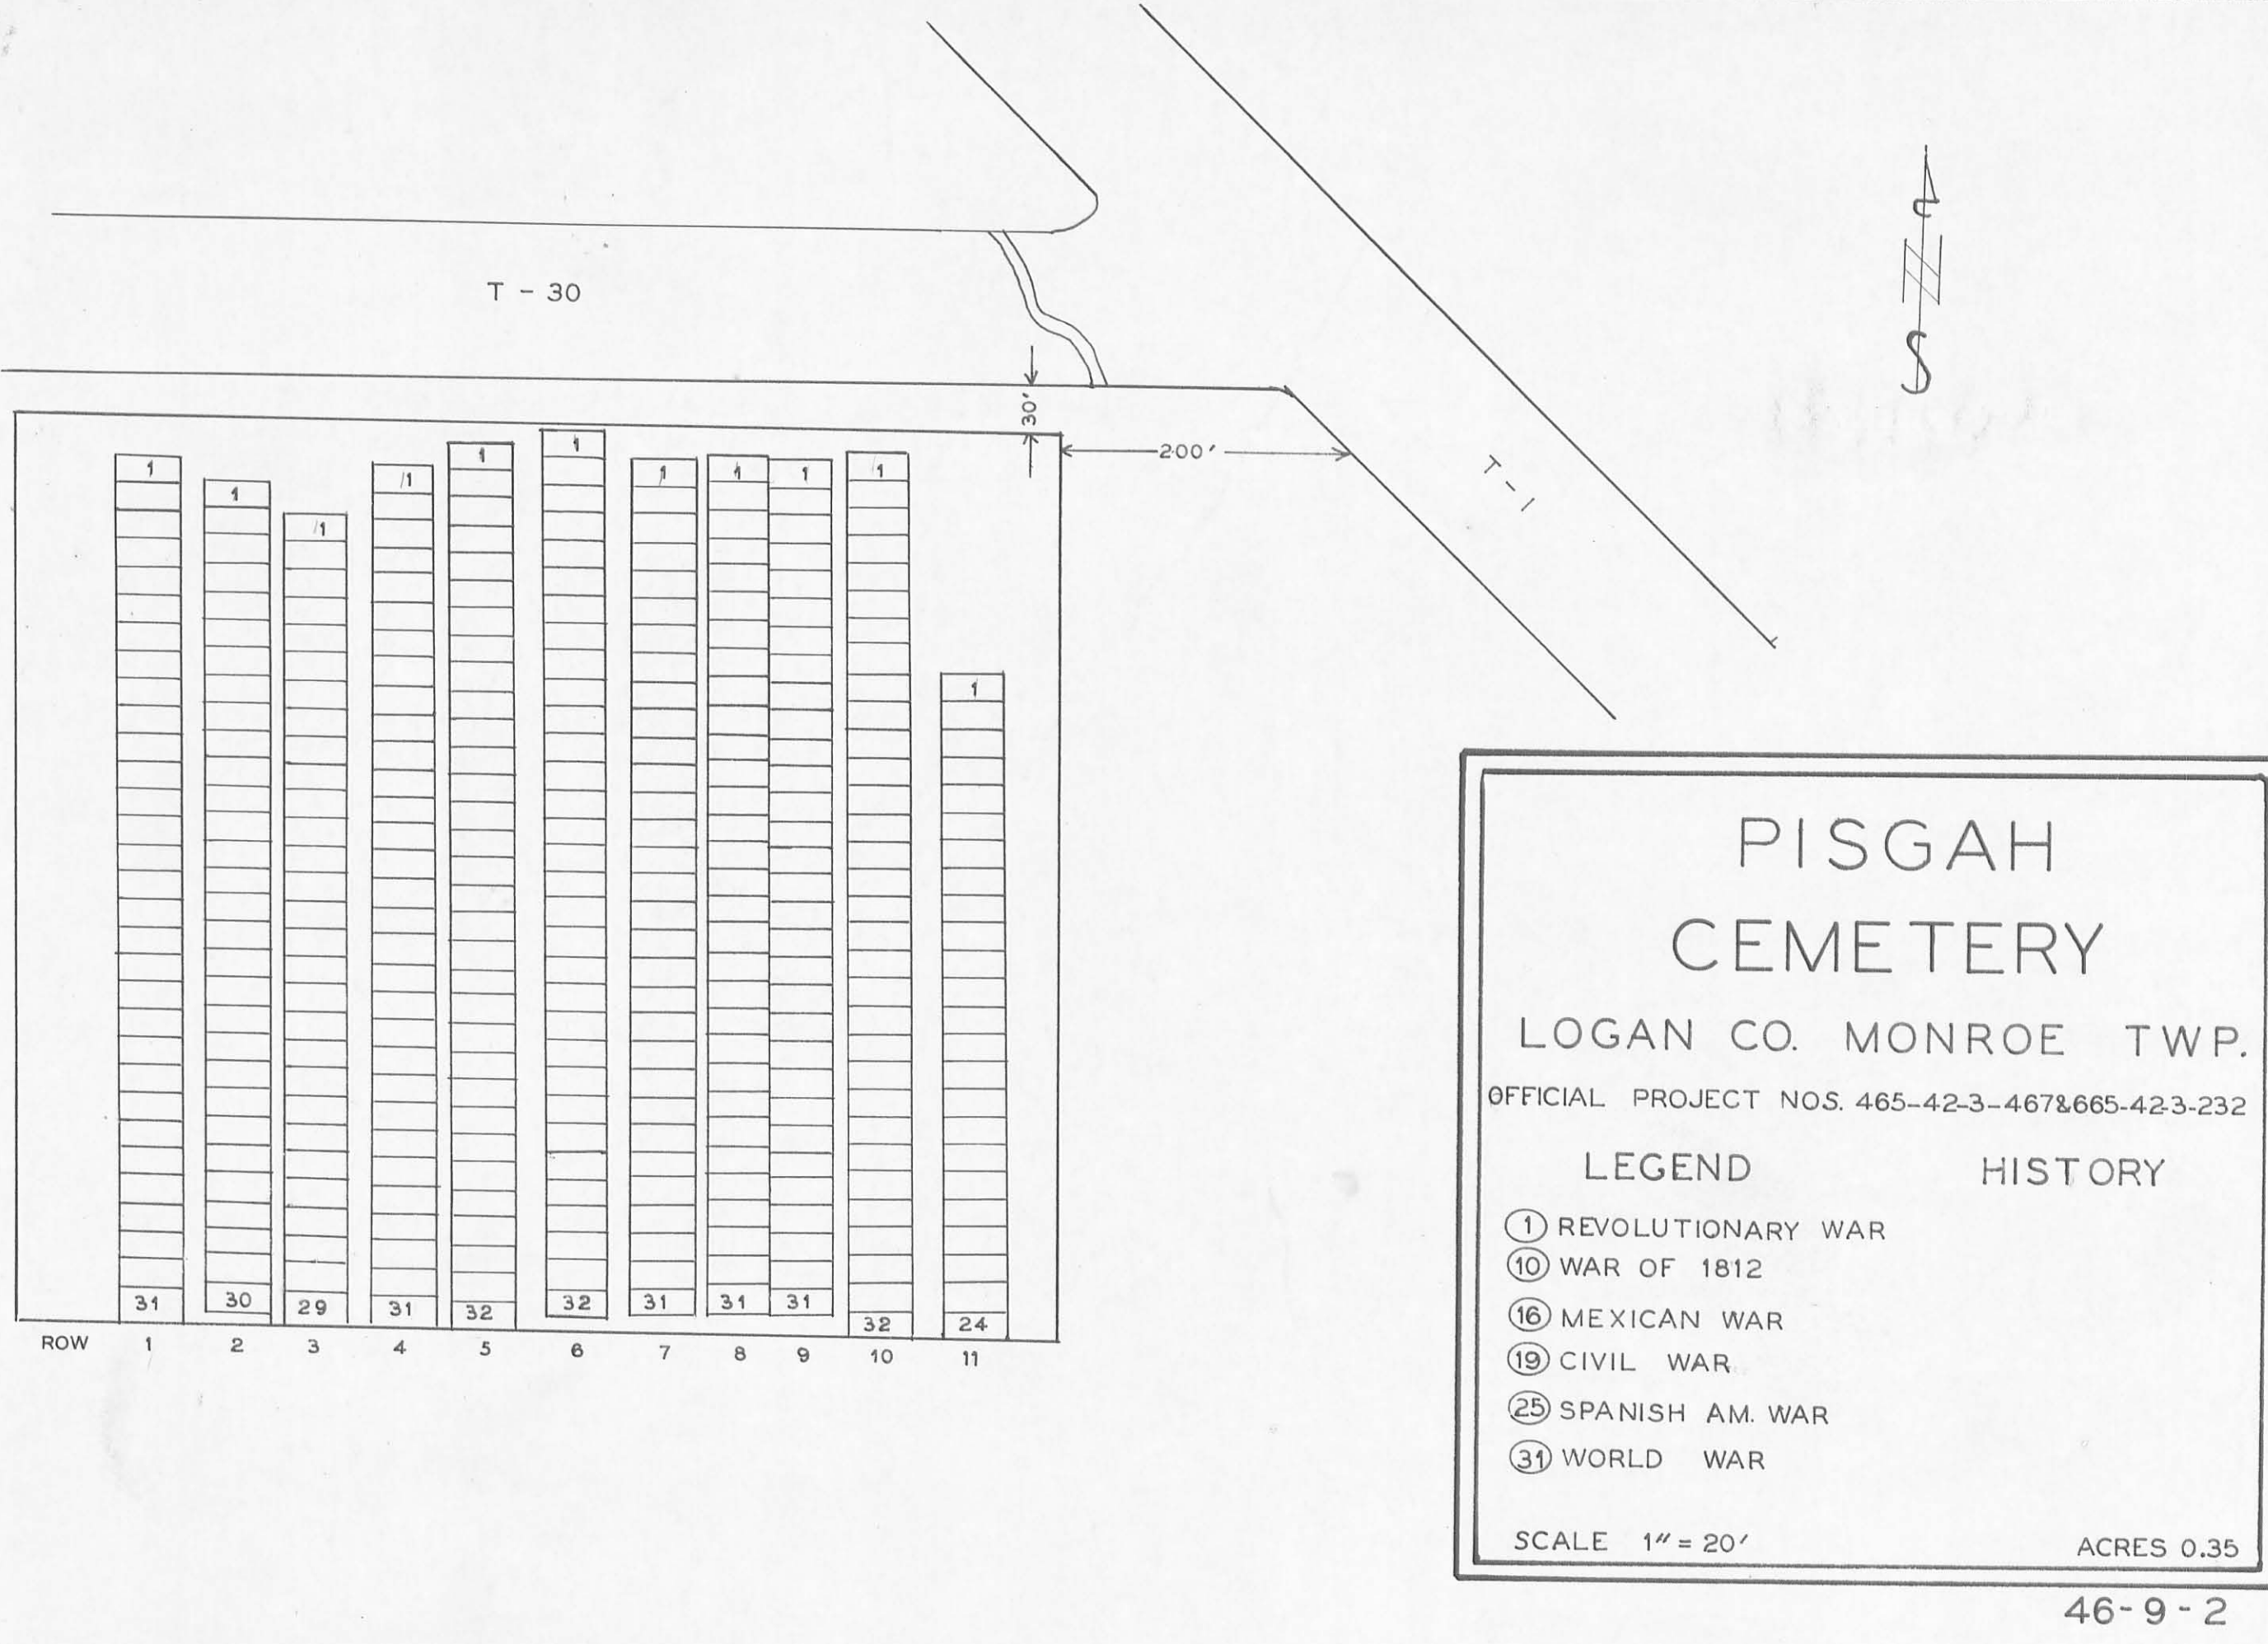


	NAME	SEC	L	R	G	W
HARDIN	ISAAC			13	36	19
MOORE	JAMES			17	31	16

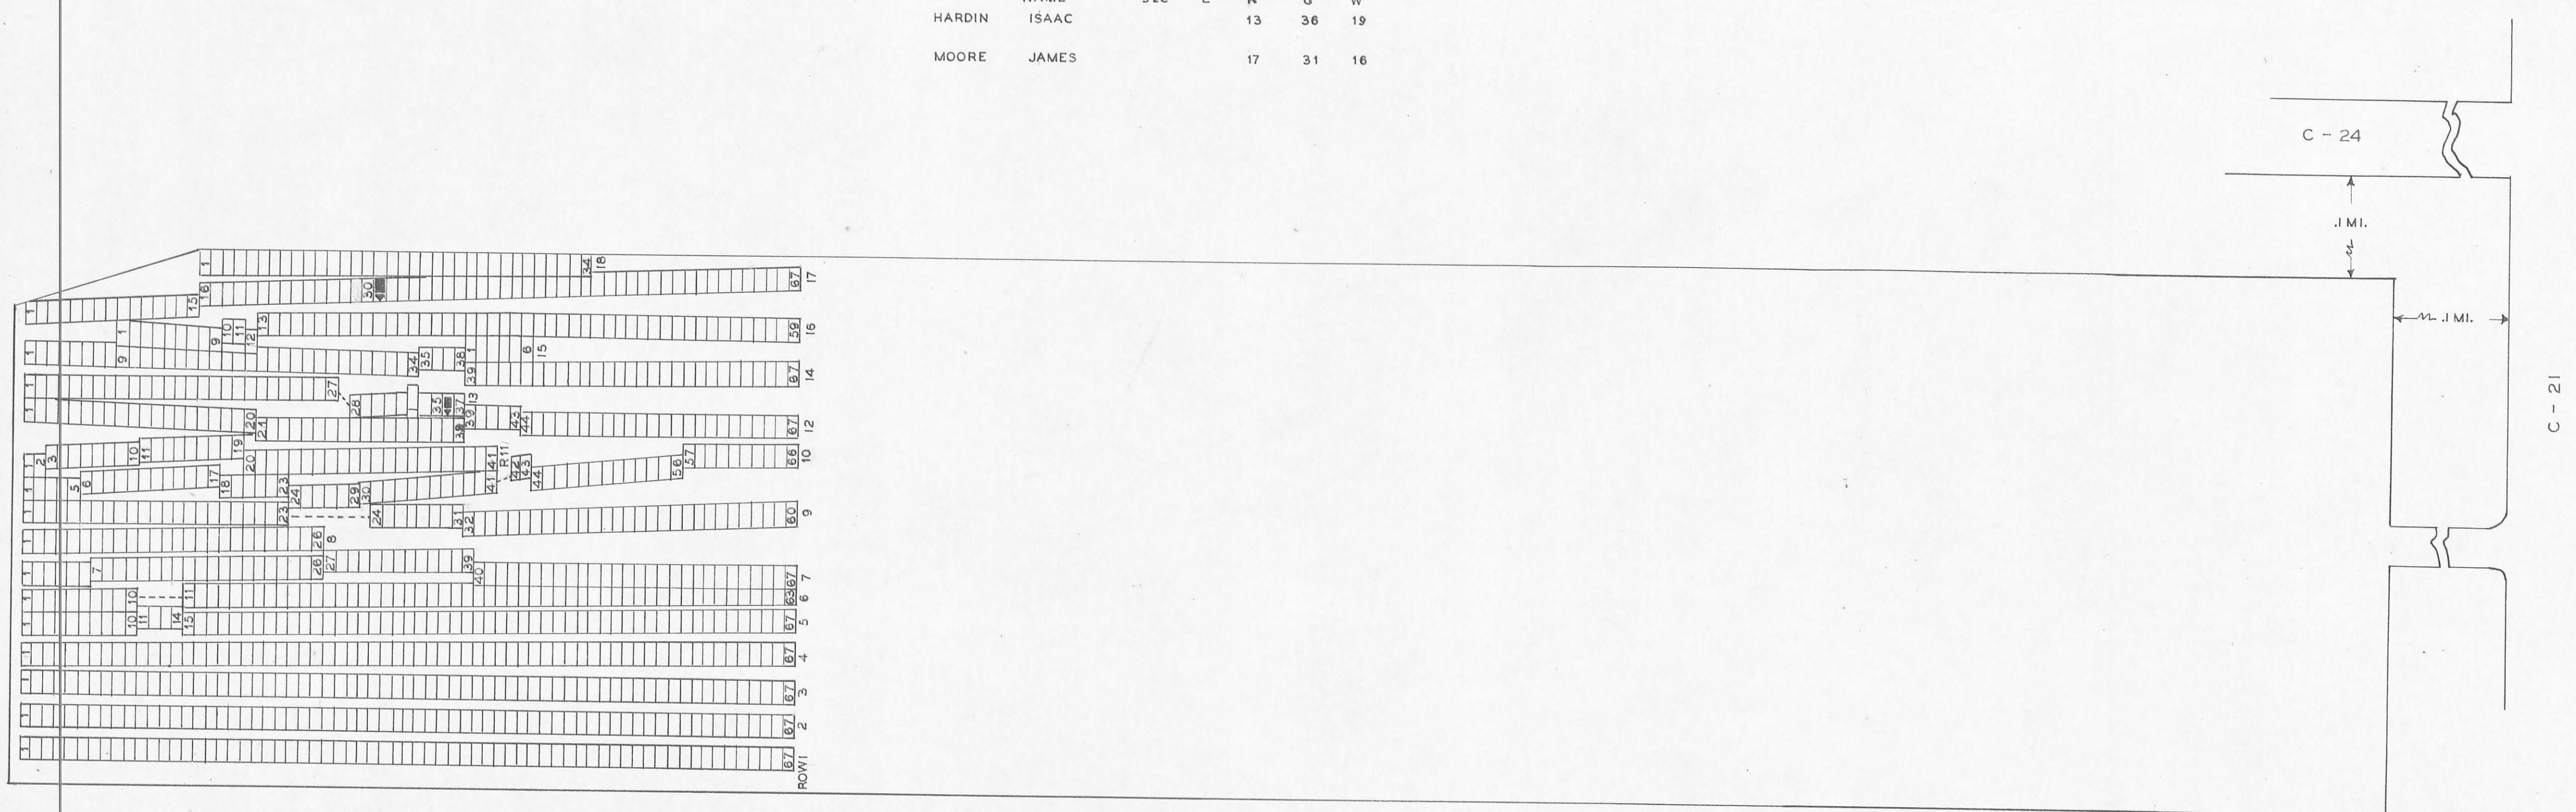

**LEGEND**  
 SEC=SECTION L=LOT R=ROW  
 G-GRAVE W-WAR  
 \*=POSITION UNKNOWN



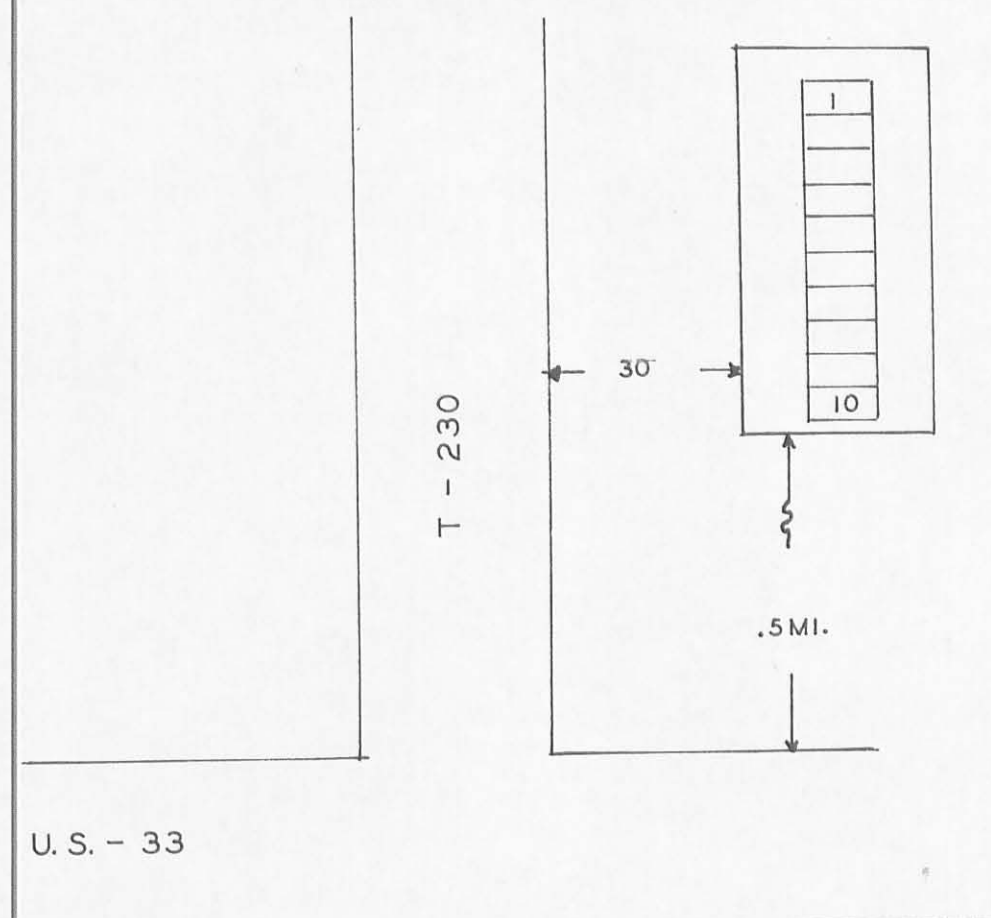


**EASTON CEMETERY**  
 LOGAN CO. JEFFERSON TWP.  
 OFFICIAL PROJECT NOS. 465-423-467&665-423-232

LEGEND	HISTORY
① REVOLUTIONARY WAR	
⑩ WAR OF 1812	
⑯ MEXICAN WAR	
⑲ CIVIL WAR	
⑳ SPANISH AM. WAR	
⑳ WORLD WAR	

SCALE 1" = 20'      ACRES .02

46-4-7

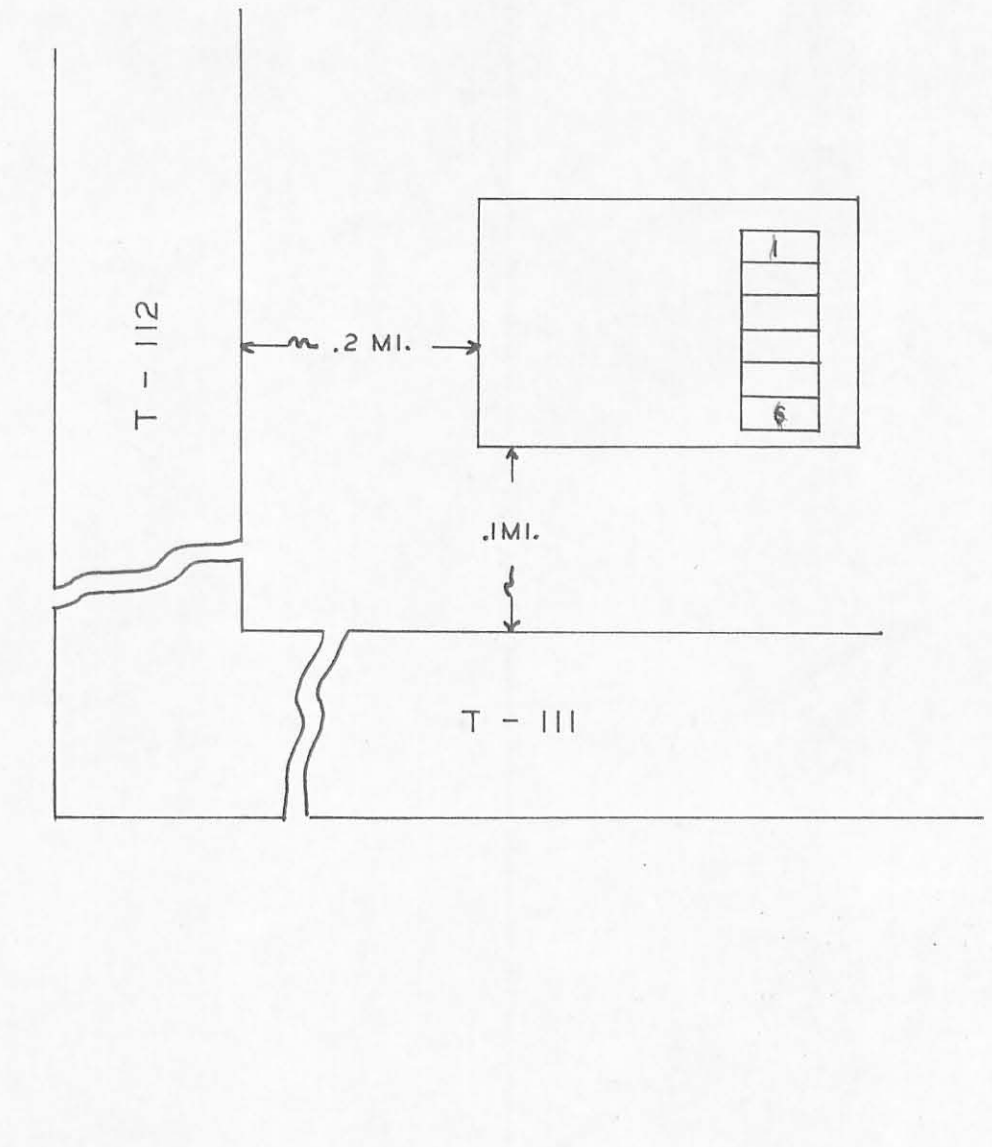


**DORMAN CEMETERY**  
 LOGAN CO. RUSHCREEK TWP.  
 OFFICIAL PROJECT NOS. 465-423-467&665-423-232

LEGEND	HISTORY
① REVOLUTIONARY WAR	
⑩ WAR OF 1812	
⑯ MEXICAN WAR	
⑲ CIVIL WAR	
⑳ SPANISH AM. WAR	
⑳ WORLD WAR	

SCALE 1" = 20'      ACRES .03

46-13-6

NAME	SEC	L	R	G	W
KENTON SIMON			2	5	1

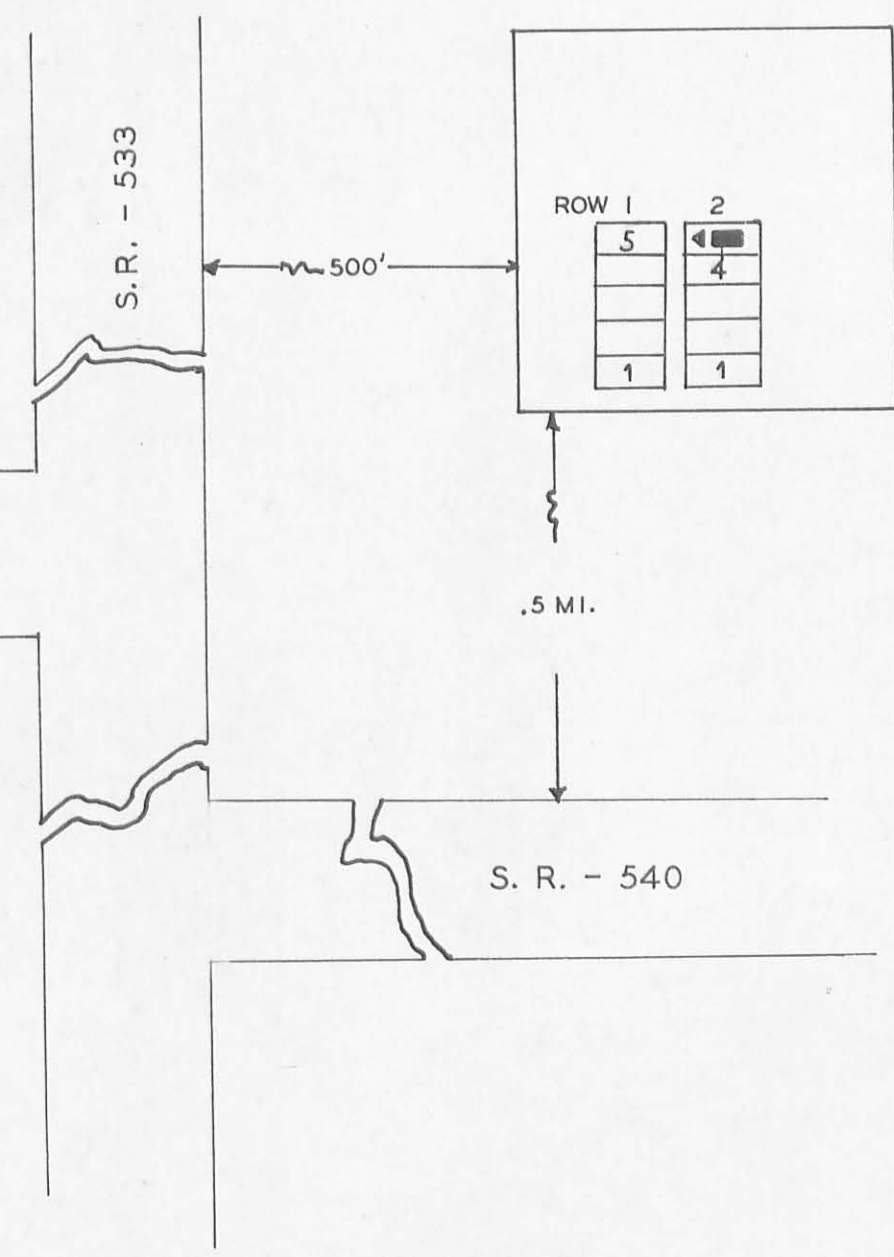


**SIMON-KENTON CEMETERY**  
 LOGAN CO. JEFFERSON TWP.  
 OFFICIAL PROJECT NOS. 465-423-467&665-423-232

LEGEND	HISTORY
① REVOLUTIONARY WAR	
⑩ WAR OF 1812	
⑯ MEXICAN WAR	
⑲ CIVIL WAR	
⑳ SPANISH AM. WAR	
⑳ WORLD WAR	

SCALE 1" = 20'      ACRES .04

46-4-10

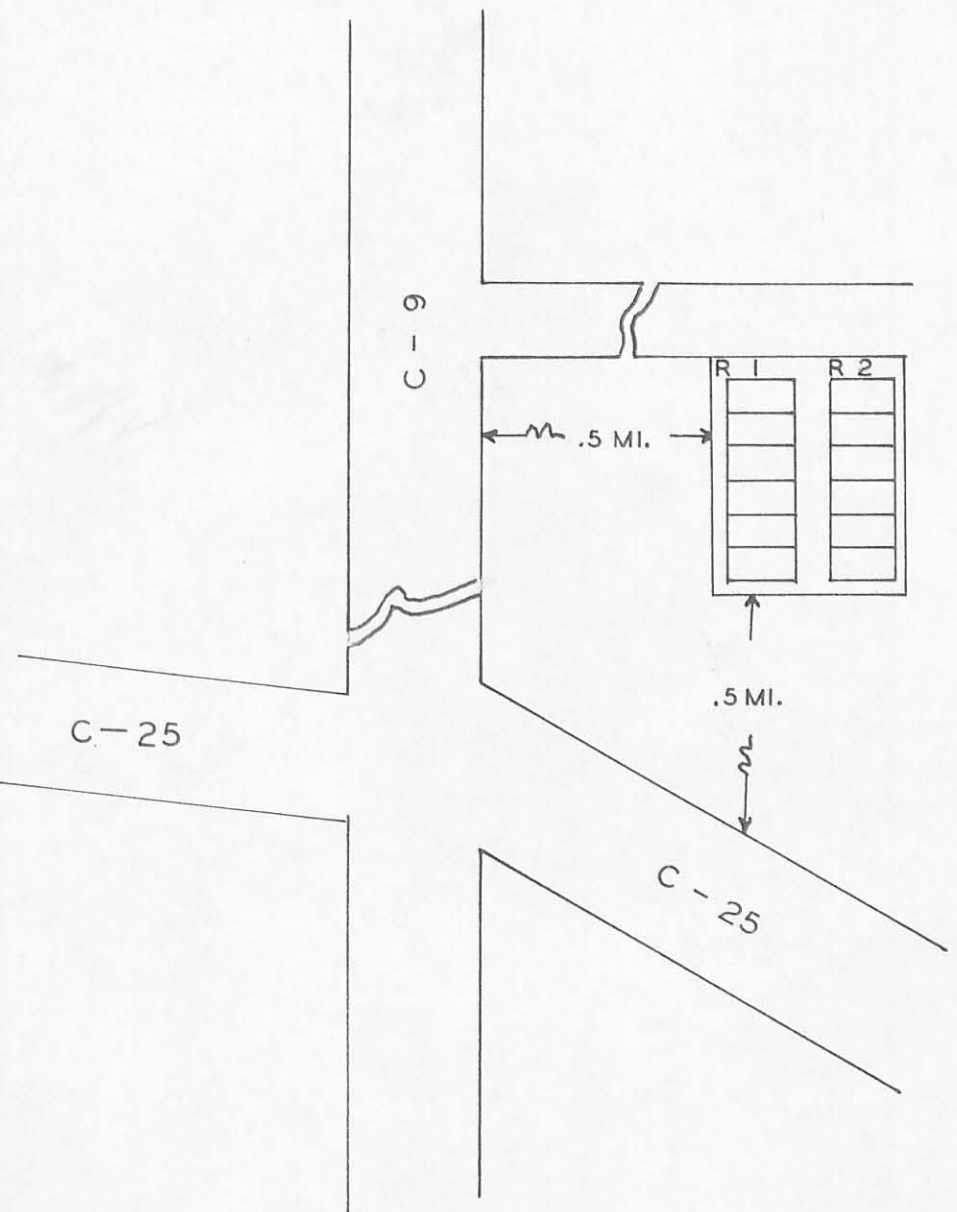

**COOVER CEMETERY**  
 LOGAN CO. RUSHCREEK TWP.  
 OFFICIAL PROJECT NOS. 465-423-467&665-423-232

LEGEND	HISTORY
① REVOLUTIONARY WAR	
⑩ WAR OF 1812	
⑯ MEXICAN WAR	
⑲ CIVIL WAR	
⑳ SPANISH AM. WAR	
⑳ WORLD WAR	

SCALE 1" = 20'      ACRES .01

46-13-7

LEGEND  
 SEC = SECTION L = LOT R = ROW  
 G = GRAVE W = WAR  
 \* = POSITION UNKNOWN



T - 260




**GHORMLEY  
CEMETERY**  
LOGAN CO. STOKES TWP.  
OFFICIAL PROJECT NOS. 465-42-3-467&665-42-3-232

<p><b>LEGEND</b></p> <p>① REVOLUTIONARY WAR ⑩ WAR OF 1812 ⑯ MEXICAN WAR ⑲ CIVIL WAR ⑳ SPANISH AM. WAR ㉑ WORLD WAR</p>	<p><b>HISTORY</b></p>
---	-----------------------

SCALE 1" = 20' ACRES 1.00

46-14-2

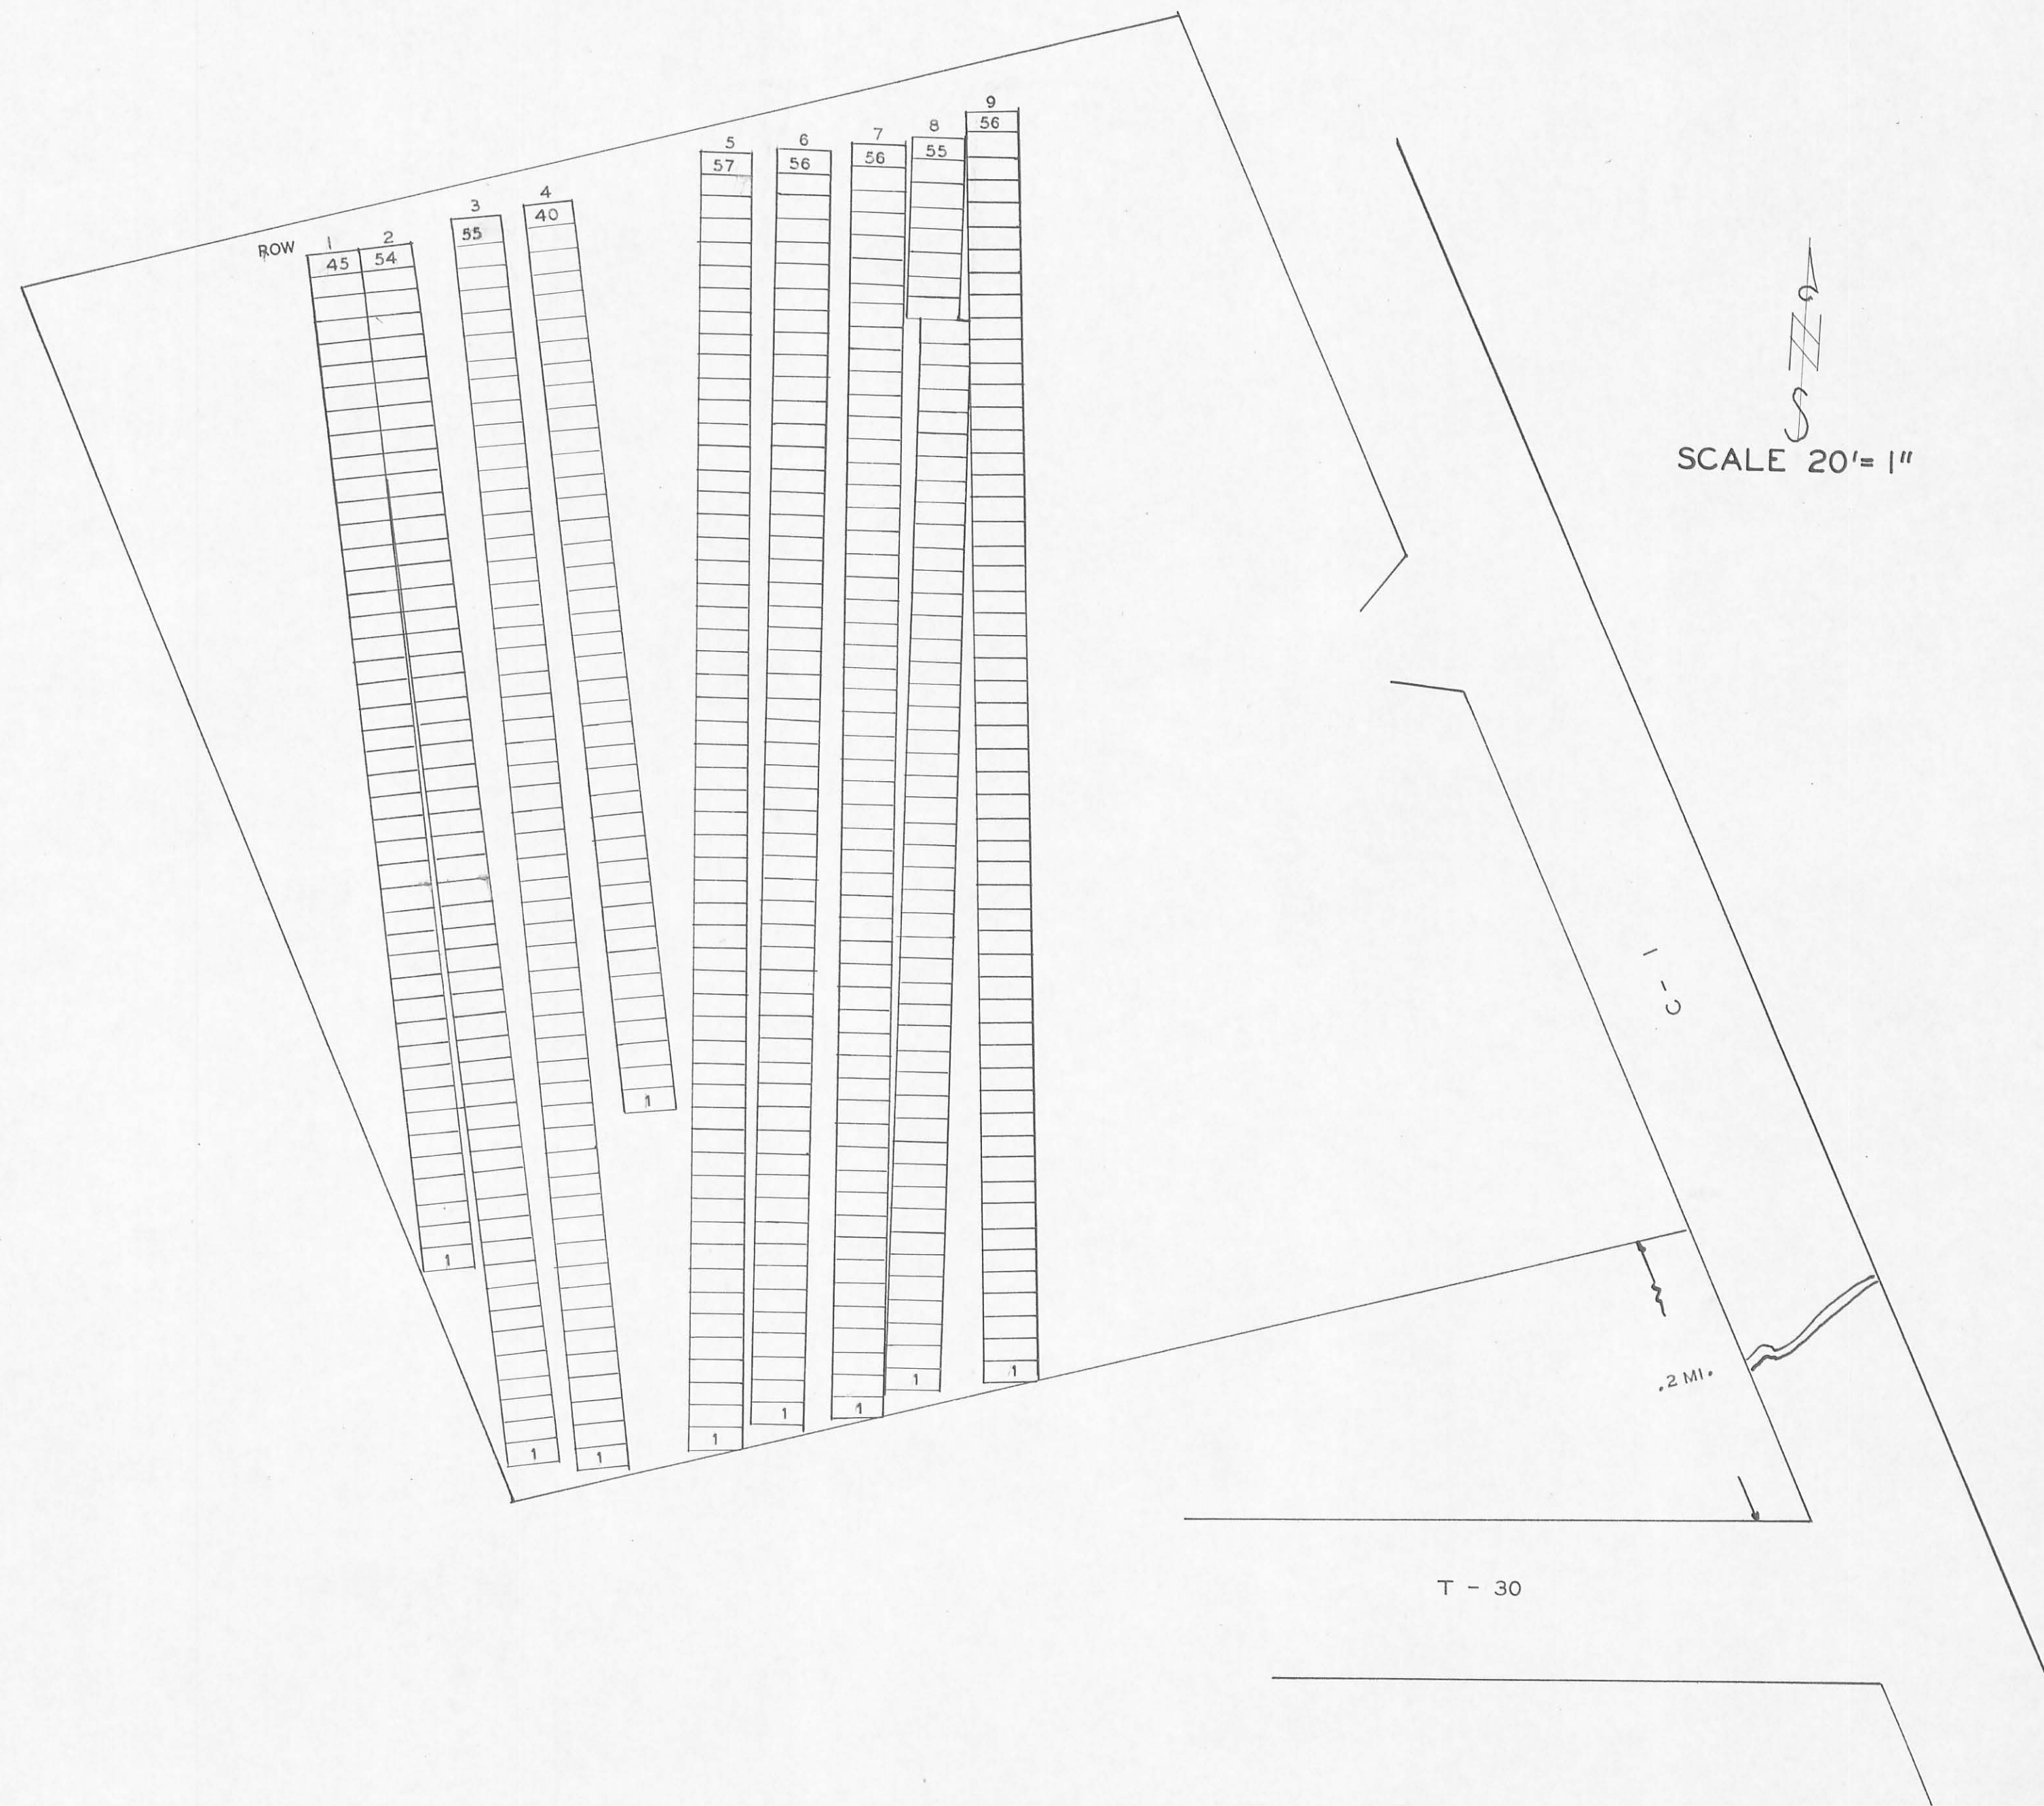


**YODER  
CEMETERY**  
LOGAN CO. MONROE TWP.  
OFFICIAL PROJECT NOS. 465-42-3-467&665-42-3-232

<p><b>LEGEND</b></p> <p>① REVOLUTIONARY WAR ⑩ WAR OF 1812 ⑯ MEXICAN WAR ⑲ CIVIL WAR ⑳ SPANISH AM. WAR ㉑ WORLD WAR</p>	<p><b>HISTORY</b></p>
---	-----------------------

SCALE 1" = 20' ACRES 0.85

46-9-3



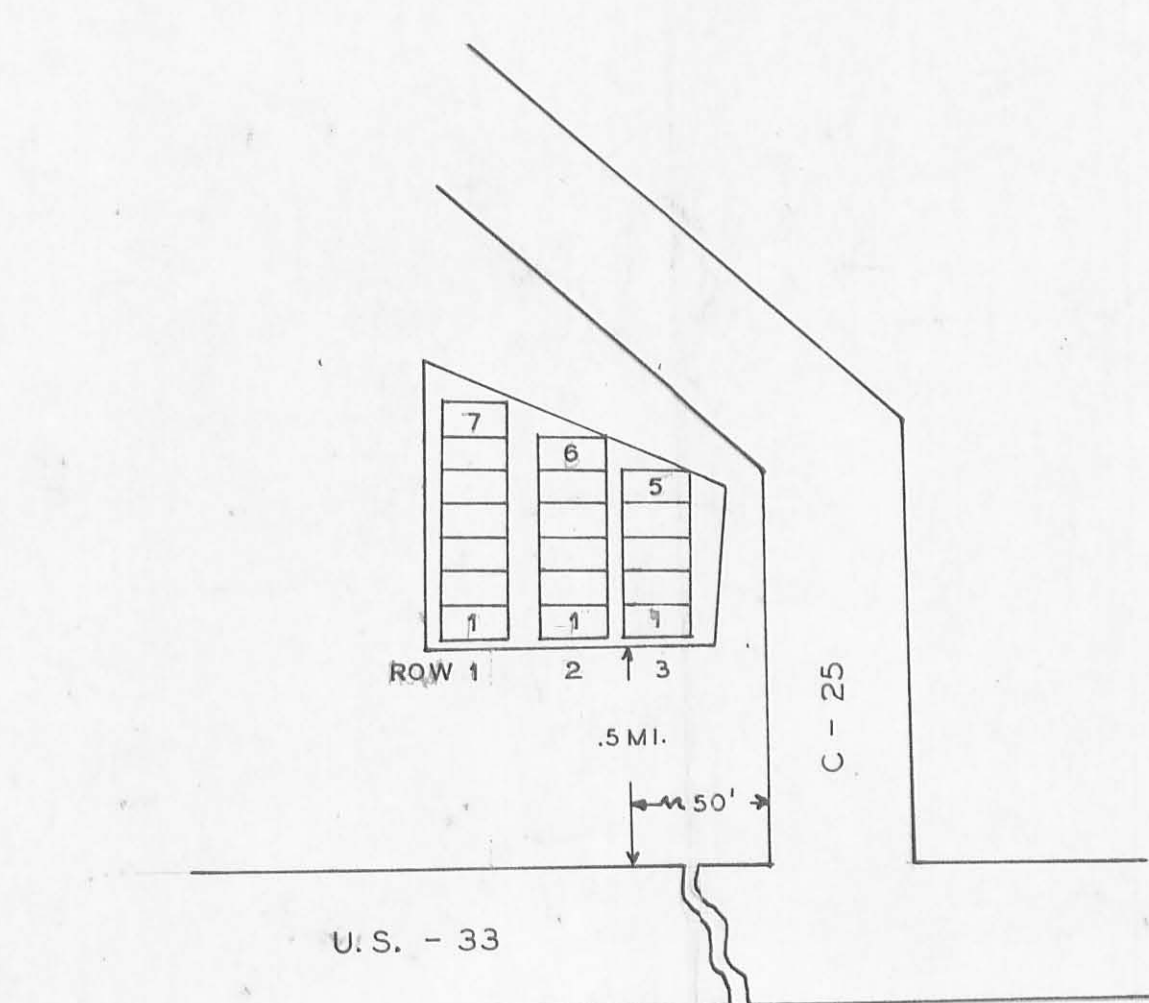


**MEANS CEMETERY**  
 LOGAN CO. JEFFERSON TWP.  
 OFFICIAL PROJECT NOS. 465-42-3-467&665-423-232

<p><b>LEGEND</b></p> <ul style="list-style-type: none"> <li>① REVOLUTIONARY WAR</li> <li>⑩ WAR OF 1812</li> <li>⑯ WAR WITH MEXICO</li> <li>⑲ CIVIL WAR</li> <li>⑳ SPANISH-AM. WAR</li> <li>㉑ WORLD WAR</li> </ul>	<p><b>HISTORY</b></p>
---	-----------------------

SCALE 1" = 20'      .02 ACRE

46-4-8

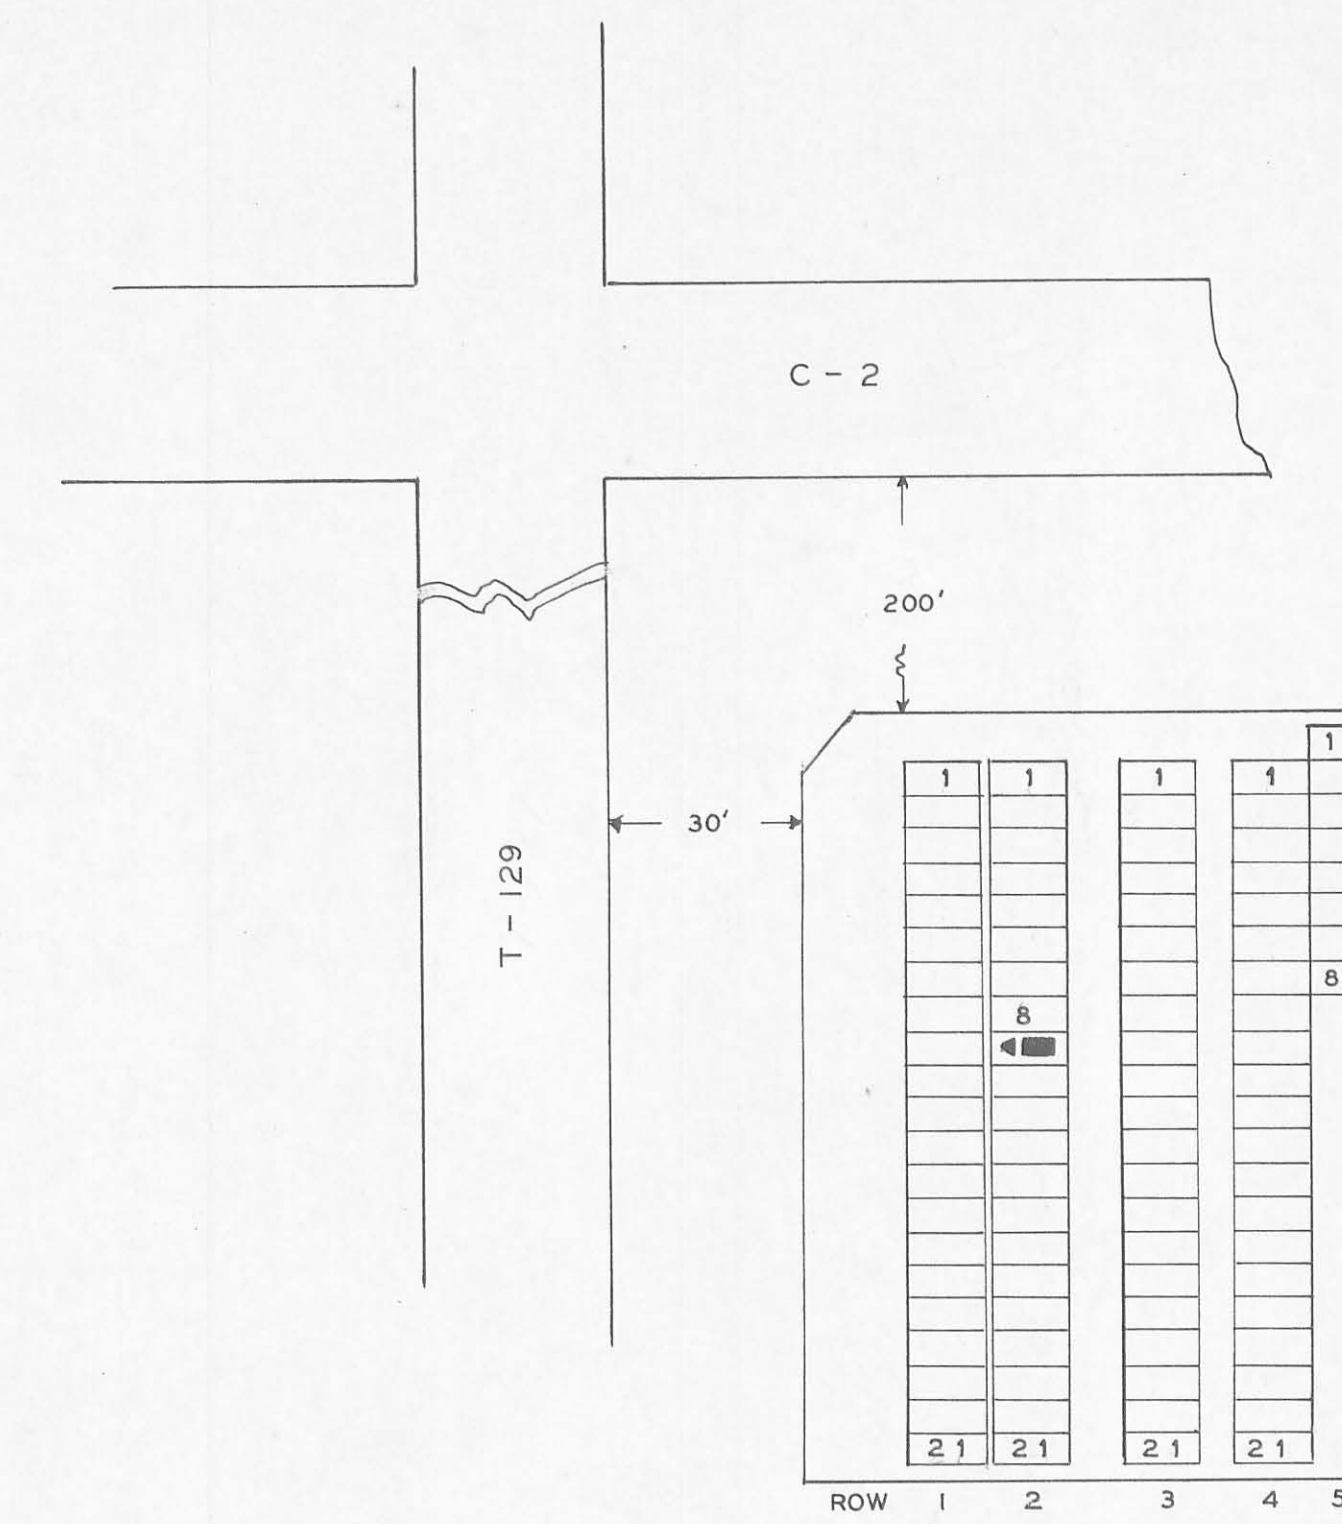


**LEGEND**  
 SEC.-SECTION R-ROW  
 G-GRAVE W-WAR

**QUAKER CEMETERY**  
 LOGAN CO. PERRY TWP.  
 OFFICIAL PROJECT NOS. 465-42-3-467&665-423-232

<p><b>LEGEND</b></p> <ul style="list-style-type: none"> <li>① REVOLUTIONARY WAR</li> <li>⑩ WAR OF 1812</li> <li>⑯ WAR WITH MEXICO</li> <li>⑲ CIVIL WAR</li> <li>⑳ SPANISH-AM. WAR</li> <li>㉑ WORLD WAR</li> </ul>	<p><b>HISTORY</b></p>
---	-----------------------

SCALE 1" = 20'      .1 ACRE

46-10-4

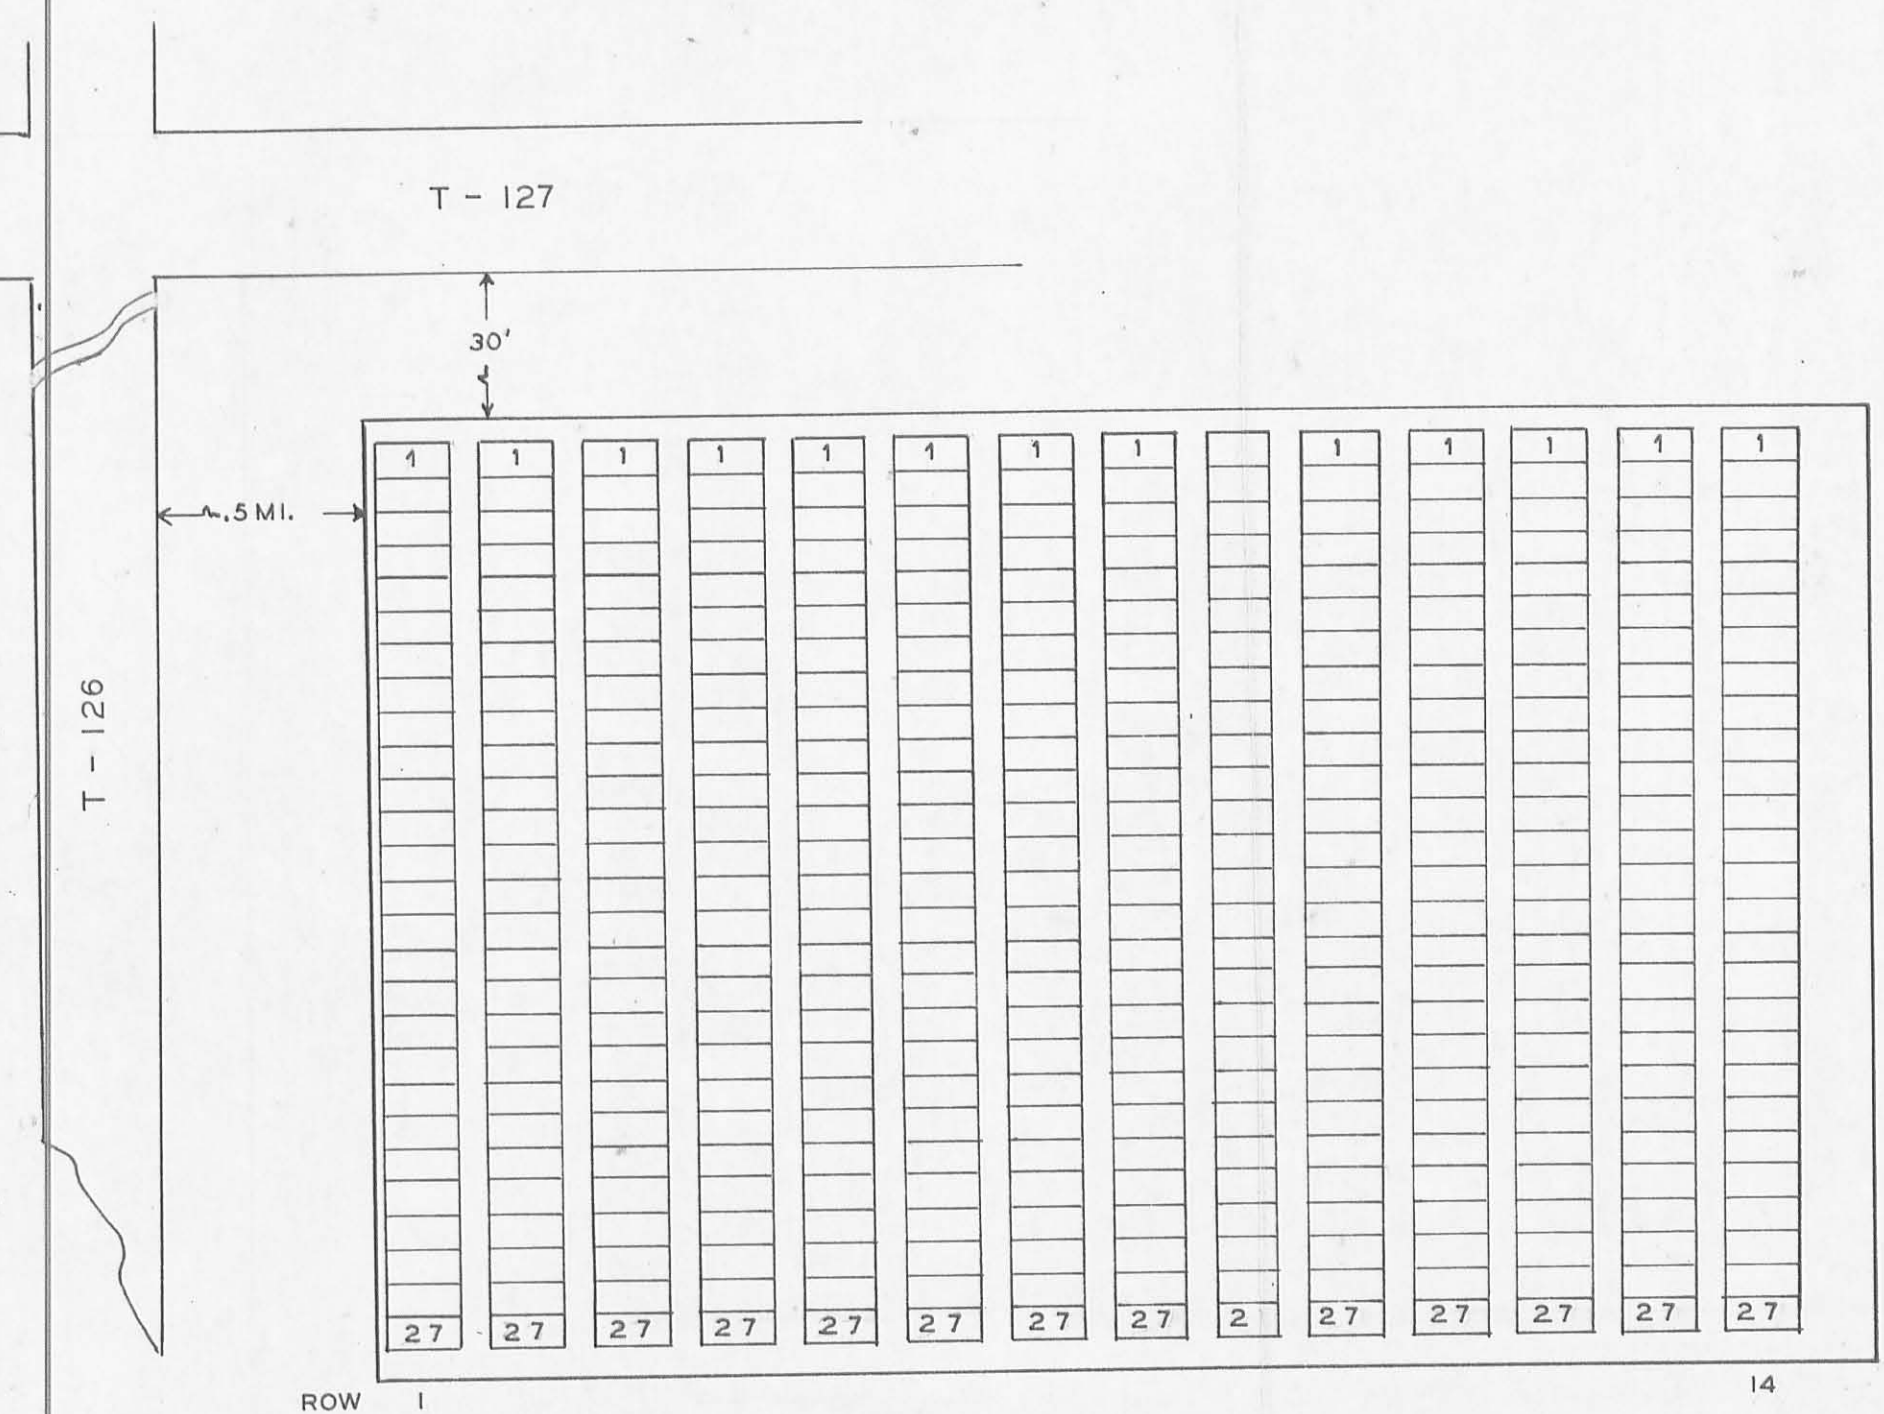

**HAITHCOCK CEMETERY**  
 LOGAN CO. JEFFERSON TWP.  
 OFFICIAL PROJECT NOS. 465-42-3-467&665-423-232

<p><b>LEGEND</b></p> <ul style="list-style-type: none"> <li>① REVOLUTIONARY WAR</li> <li>⑩ WAR OF 1812</li> <li>⑯ WAR WITH MEXICO</li> <li>⑲ CIVIL WAR</li> <li>⑳ SPANISH-AM. WAR</li> <li>㉑ WORLD WAR</li> </ul>	<p><b>HISTORY</b></p>
---	-----------------------

SCALE 1" = 20'      .36 ACRE

46-4-11



NAME	SEC	R	G	W
CAMPBELL WILLIAM	6	22	10	
DAVIS GEO. W.	8	1	19	
DILLON ISSAC	1	33	19	
DOWNS DANIEL	16	13	19	
DUGLAS WILLIAM	5	2	19	
ERTER JOHN	6	20	19	
SAGER SAMUEL L.	13	32	19	
SMITH SYLVANUS	14	11	19	
TAYLOR RICHARD	9	10	19	
WEEKS JOHN	11	1	10	
WHITMAN WM.	15	19	19	
LYNN GEORGE	6	1		
WISE JACOB	6	2		


**LOGANSVILLE CEMETERY**  
 LOGAN CO. PLEASANTVILLE TWP.  
 OFFICIAL PROJECT NOS. 465-42-3-467&665-423-232

<p><b>LEGEND</b></p> <ul style="list-style-type: none"> <li>① REVOLUTIONARY WAR</li> <li>⑩ WAR OF 1812</li> <li>⑯ WAR WITH MEXICO</li> <li>⑲ CIVIL WAR</li> <li>⑳ SPANISH-AM. WAR</li> <li>㉑ WORLD WAR</li> </ul>	<p><b>HISTORY</b></p>
---	-----------------------

SCALE 1" = 20'      1.6 ACRE

46-11-2



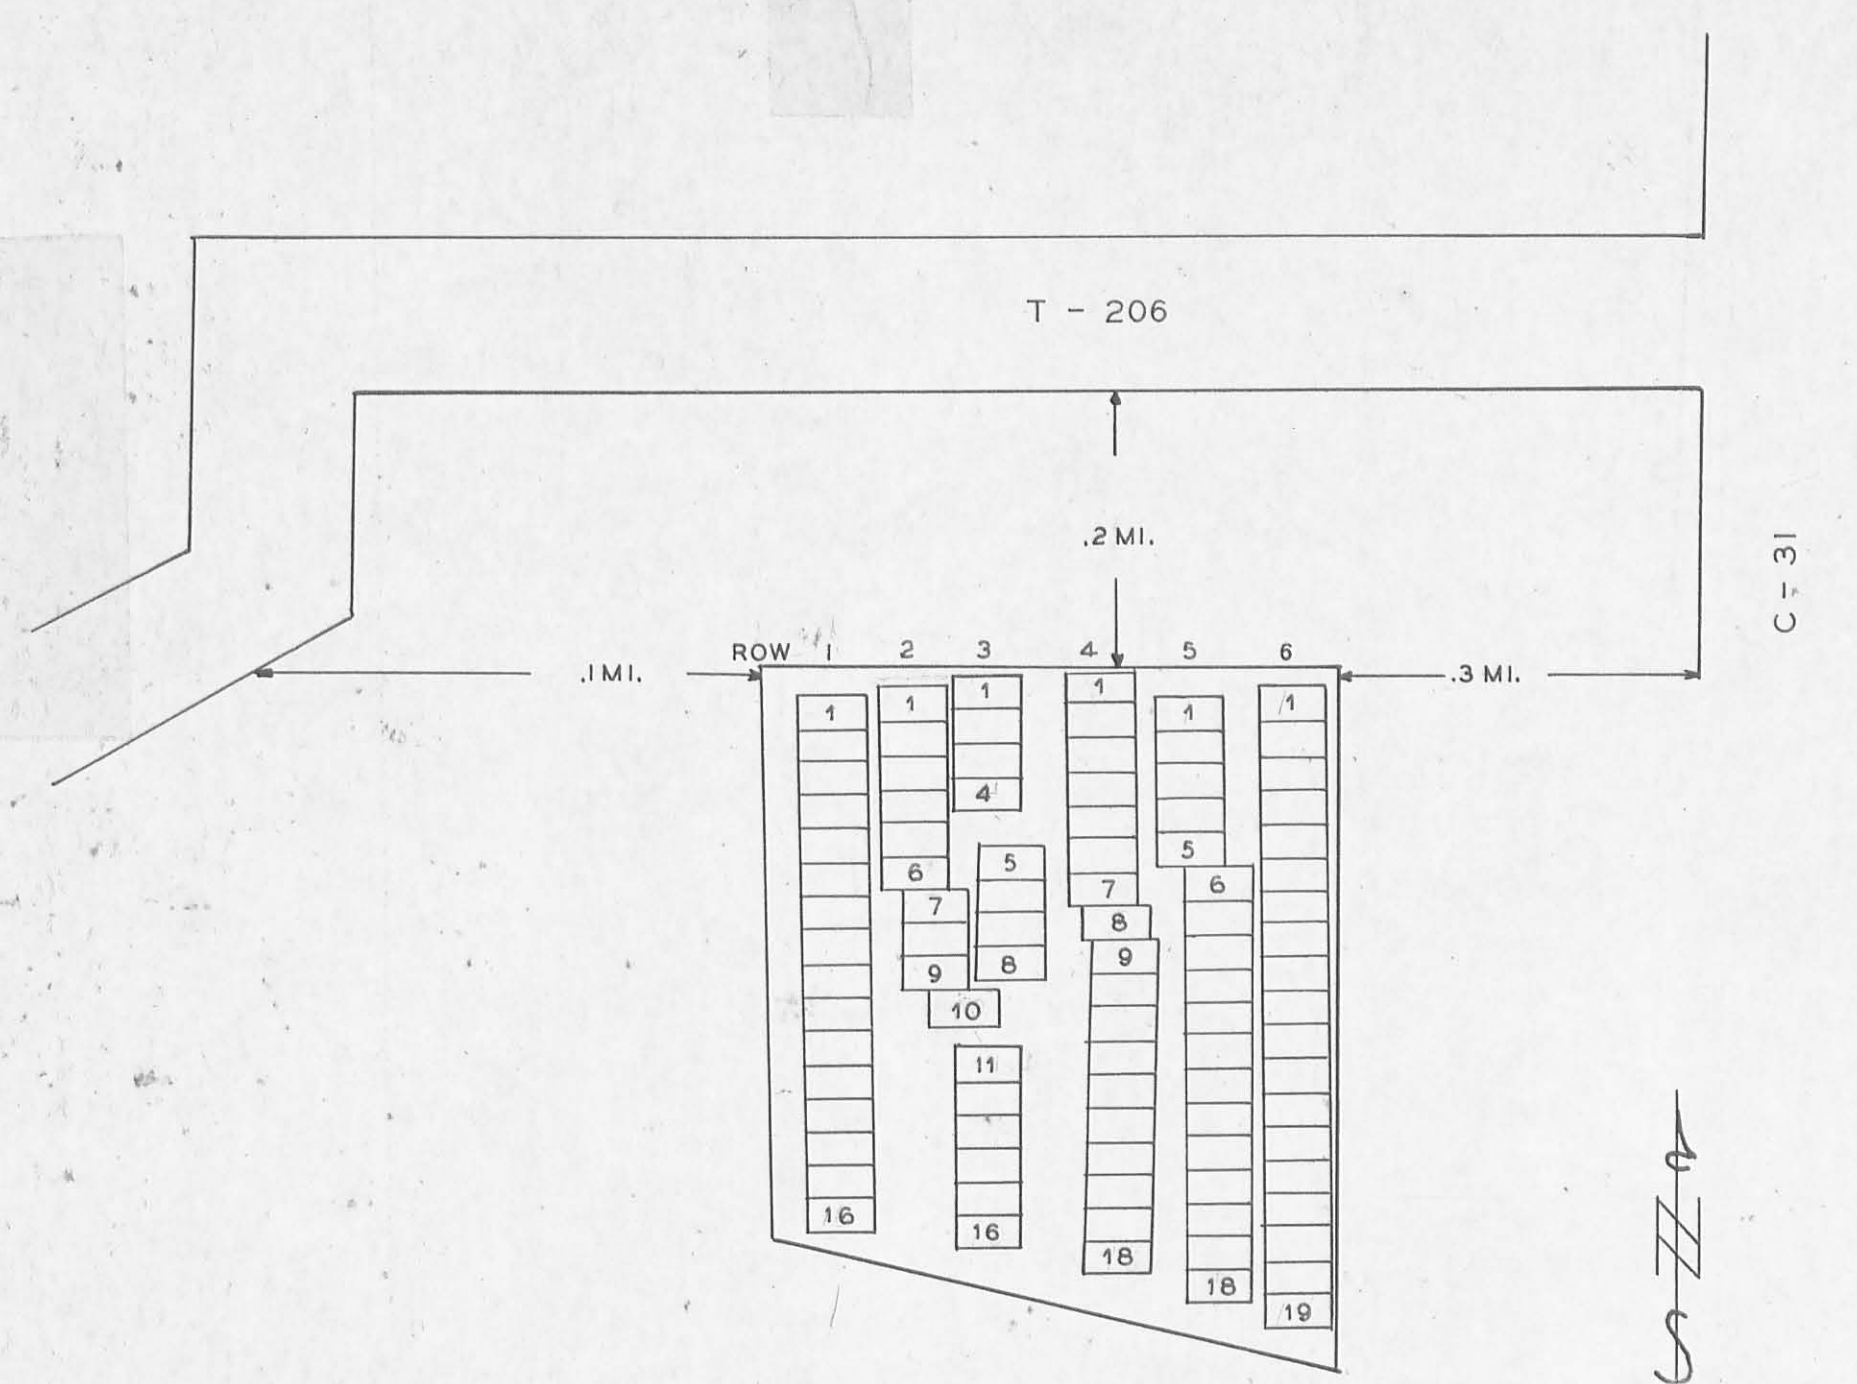


**MILLER  
CEMETERY**  
LOGAN CO. HARRISON TWP.

OFFICIAL PROJECT NOS. 465-42-3-467 & 665-42-3-232

<p><b>LEGEND</b></p> <p>① REVOLUTIONARY WAR ⑩ WAR OF 1812 ⑯ WAR WITH MEXICO ⑲ CIVIL WAR ⑳ SPANISH AM. WAR ⑳ WORLD WAR</p>	<p><b>HISTORY</b></p> <p>.25 ACRES</p>
---	--

46-3-5

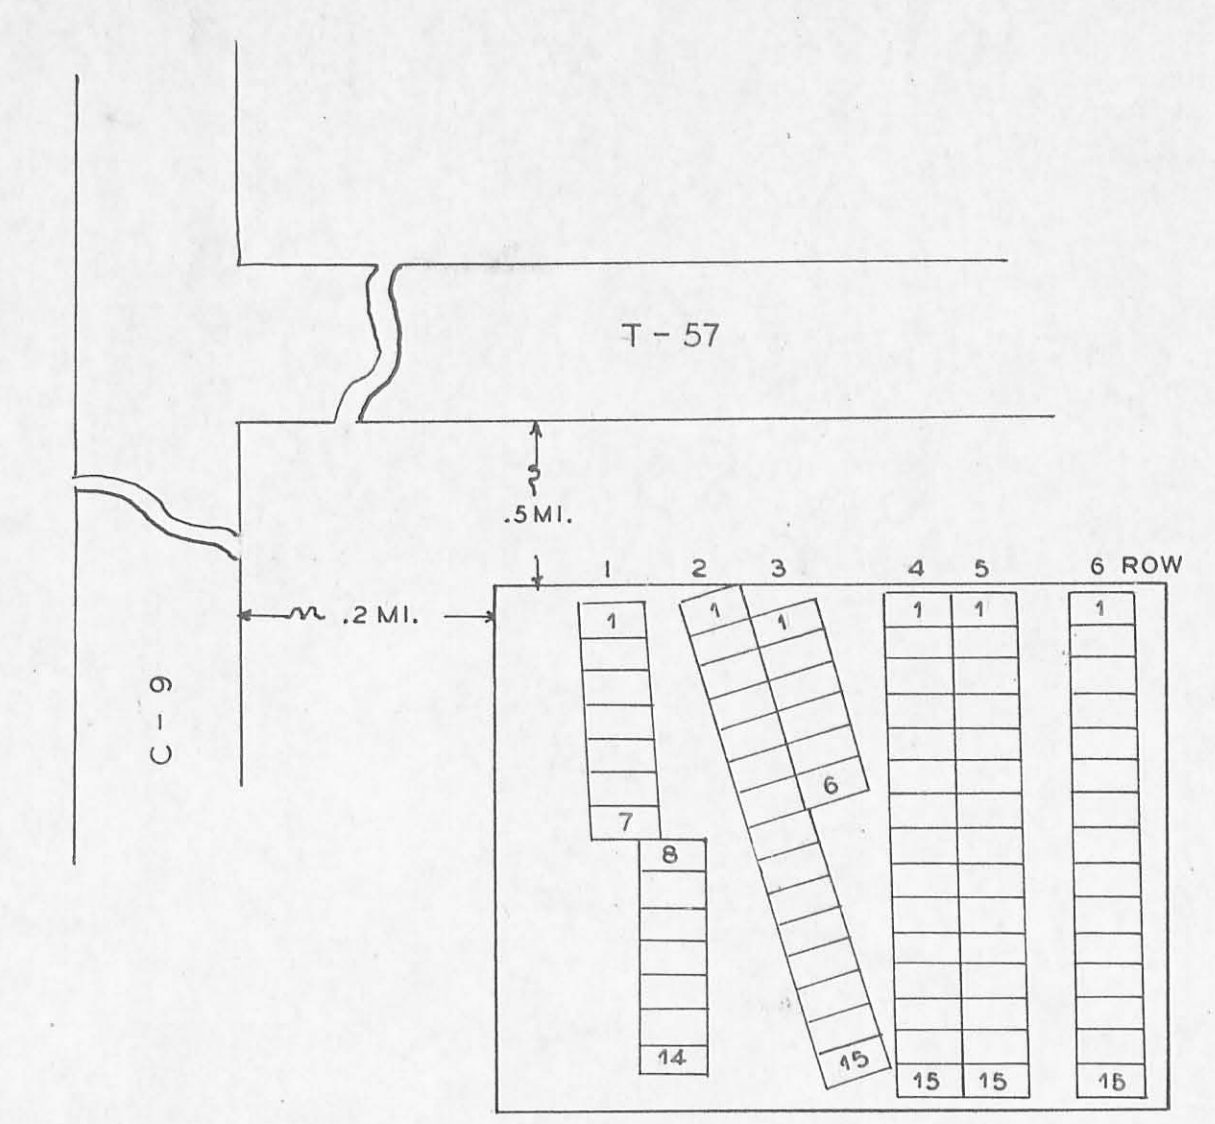


**STANFIELD  
CEMETERY**  
LOGAN CO. MIAMI TWP.

OFFICIAL PROJECT NOS. 465-42-3-467-665-42-3-232

<p><b>LEGEND</b></p> <p>① REVOLUTIONARY WAR ⑩ WAR OF 1812 ⑯ WAR WITH MEXICO ⑲ CIVIL WAR ⑳ SPANISH AM. WAR ⑳ WORLD WAR</p>	<p><b>HISTORY</b></p> <p>.09 ACRES</p>
---	--

46-13-5

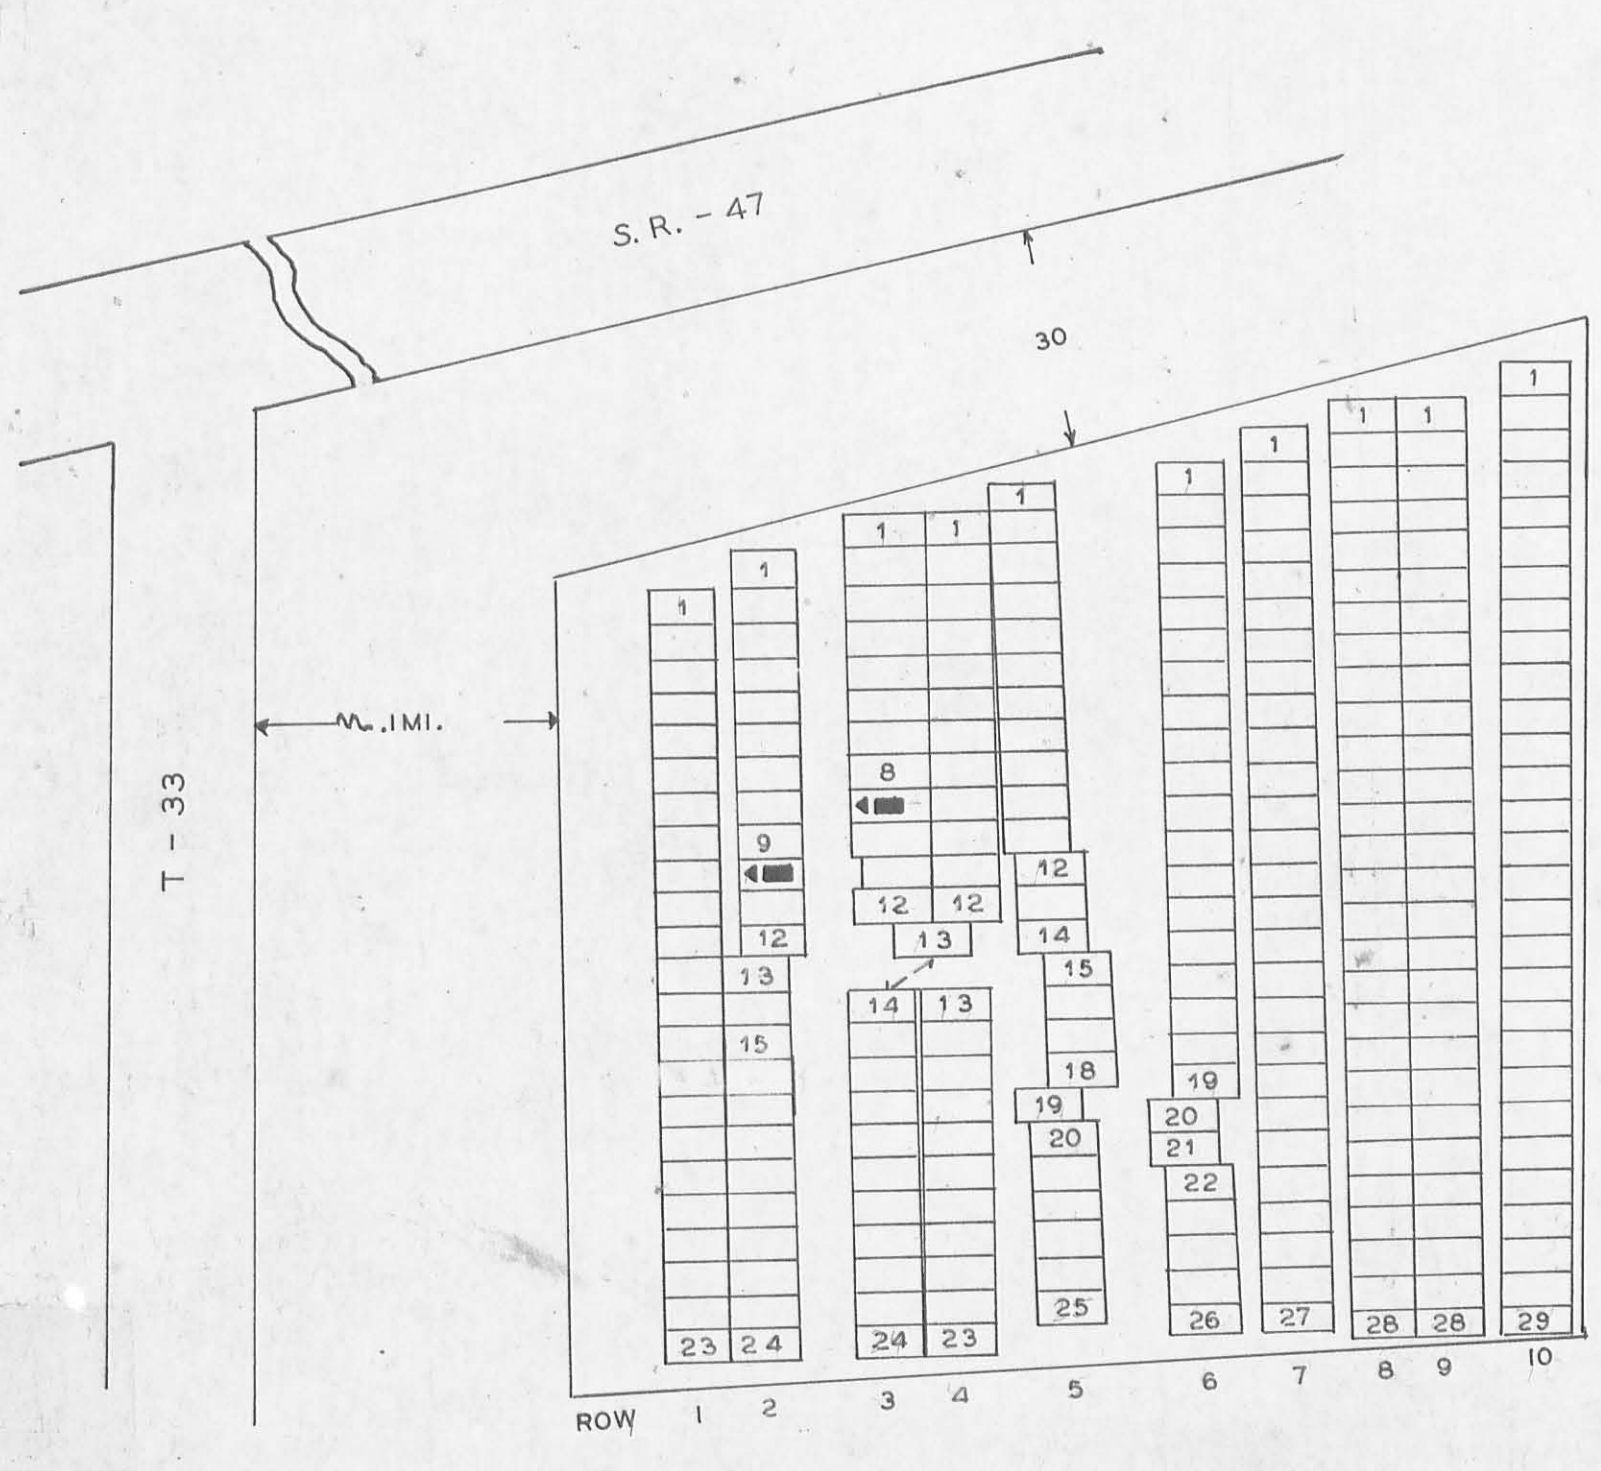


NAME	SEC	L	R	G	W
PARRISH JOHN			3	9	10
TURNER CALEB J			2	10	19

**PARRISH  
CEMETERY**  
LOGAN CO. HARRISON TWP.

OFFICIAL PROJECT NOS. 465-42-3 & 667-42-3-232

<p><b>LEGEND</b></p> <p>① REVOLUTIONARY WAR ⑩ WAR OF 1812 ⑯ WAR WITH MEXICO ⑲ CIVIL WAR ⑳ SPANISH AM. WAR ⑳ WORLD WAR</p>	<p><b>HISTORY</b></p> <p>.25 ACRES</p>
---	--

46-3-2

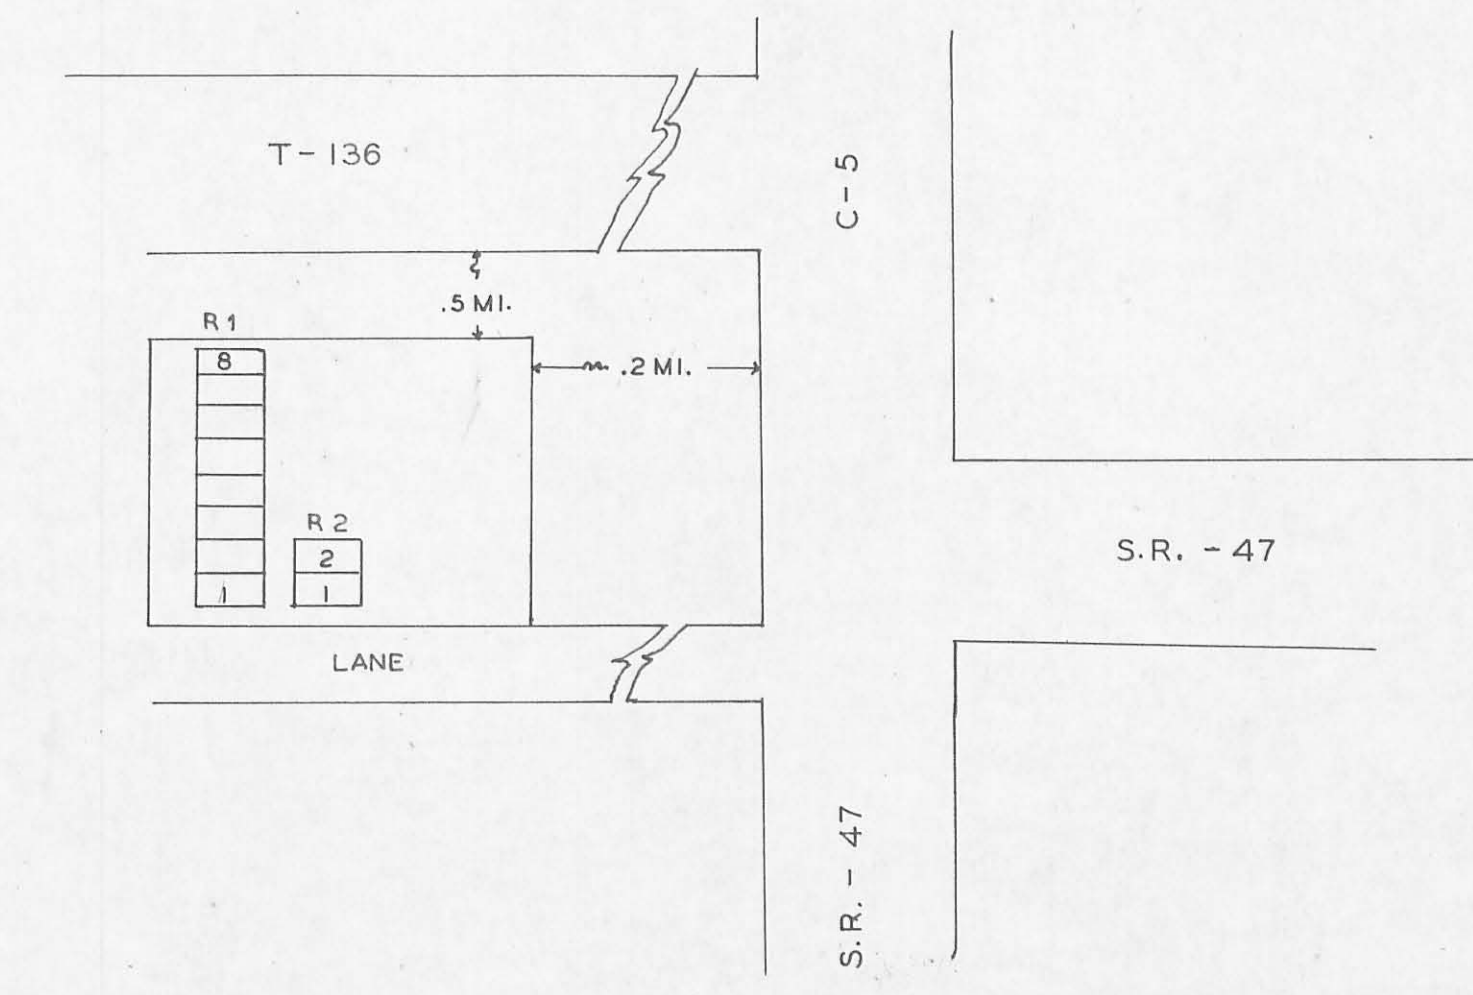

**JASINSKY  
CEMETERY**  
LOGAN CO. RUSHCREEK TWP.


OFFICIAL PROJECT NOS. 465-42-3-467-665-42-3-232

<p><b>LEGEND</b></p> <p>① REVOLUTIONARY WAR ⑩ WAR OF 1812 ⑯ WAR WITH MEXICO ⑲ CIVIL WAR ⑳ SPANISH AM. WAR ⑳ WORLD WAR</p>	<p><b>HISTORY</b></p> <p>.03 ACRES</p>
---	--

46-13-8



NAME	W
BUSHONG F. H.	31 MEMORIAL
DUBBS FOREST E.	31 MEMORIAL

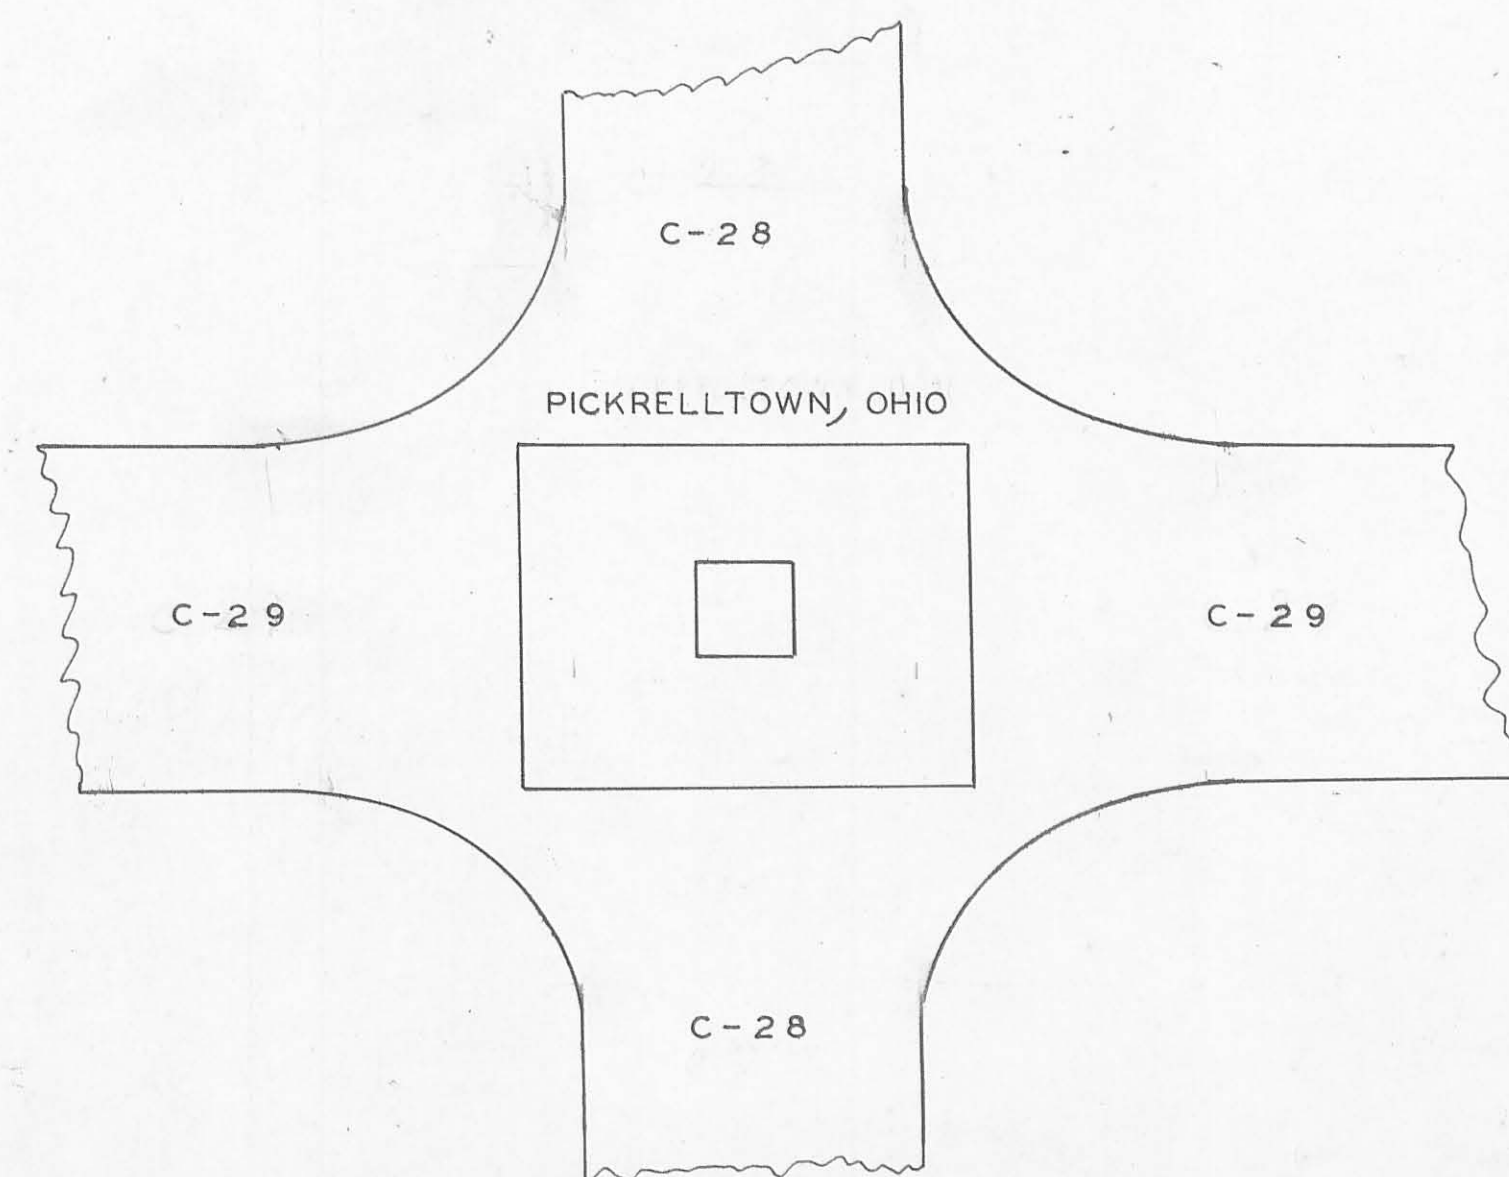

**PICKRELLTOWN W.W.  
MEMORIAL**

LOGAN CO. MONROE TWP.

OFFICIAL PROJECT NOS. 465-42-3-467 & 665-42-3-232

LEGEND	HISTORY
① REVOLUTIONARY WAR	
⑩ WAR OF 1812	
⑯ WAR WITH MEXICO	
⑲ CIVIL WAR	
⑳ SPANISH-AM. WAR	
㉑ WORLD WAR	

0.01 ACRE

46-9-11